


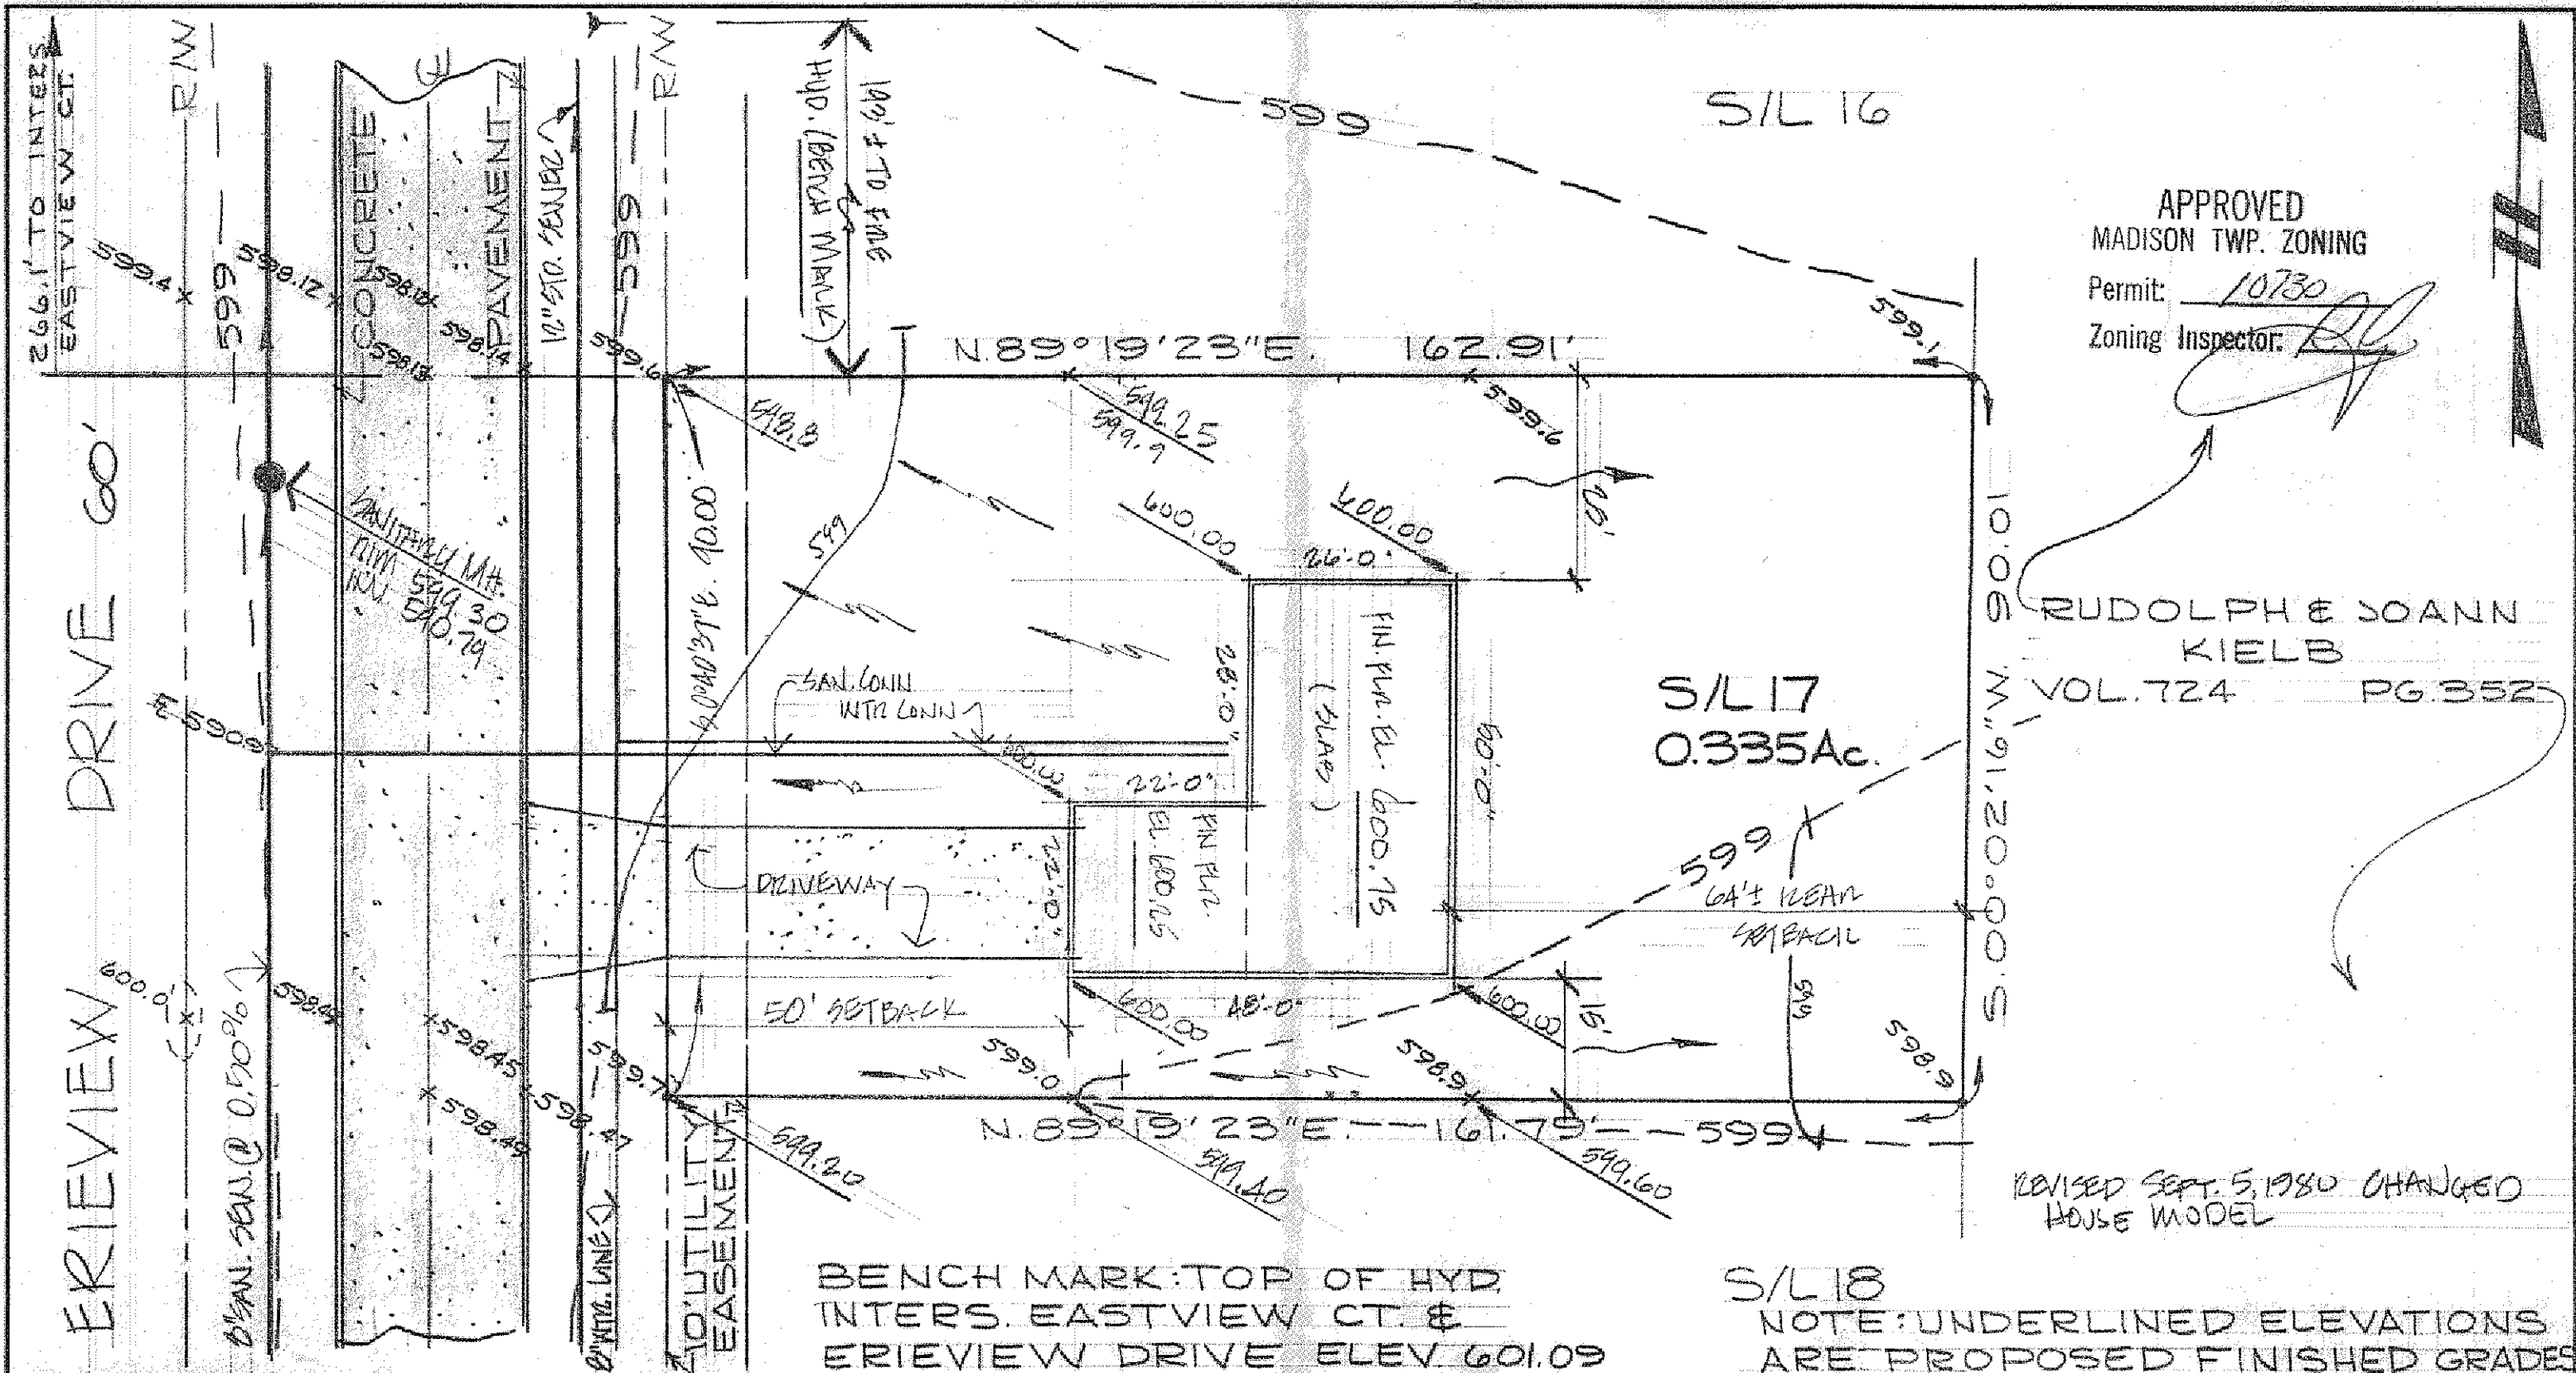

APPROVED  
MADISON TWP. ZONING  
Permit: 10730  
Zoning Inspector: [Signature]

RUDOLPH & JOANN  
KIELB  
VOL. 724 PG. 352

REVISED SEPT. 5, 1980 CHANGED  
HOUSE MODEL

S/L18  
NOTE: UNDERLINED ELEVATIONS  
ARE PROPOSED FINISHED GRADES

DESIGN CERTIFICATION

THIS PLAT WAS PREPARED BY ME,  
AND IS CORRECT TO THE BEST OF  
MY KNOWLEDGE AND BELIEF.

*[Signature]*

REG. SURVEYOR NO. 4785

**AS BUILT CERTIFICATION**

I HEREBY CERTIFY THAT THE CIRCLED GRADES  
ARE EXISTING FINISH GRADES CHECKED IN THE  
FIELD ON \_\_\_\_\_ AND THAT  
SURVEY IS CORRECT TO THE BEST OF MY  
KNOWLEDGE AND BELIEF.

\_\_\_\_\_

REG. SURVEYOR NO. \_\_\_\_\_



**COLPETZER · WOODS**  
CONSULTANTS, INC.

DATE 5/30/79  
SCALE 1"=20'  
DRWN BY D.E.  
CHKD BY \_\_\_\_\_  
JOB NO. 78/107  
# 361 PG 76  
FB

SITE PLAN FOR  
NEFF-FAUVER INC.  
BEING S/L NO.17 IN ERIEVIEW  
ESTATES SUBDIVISION  
MADISON TWP. LAKE COUNTY, OH