


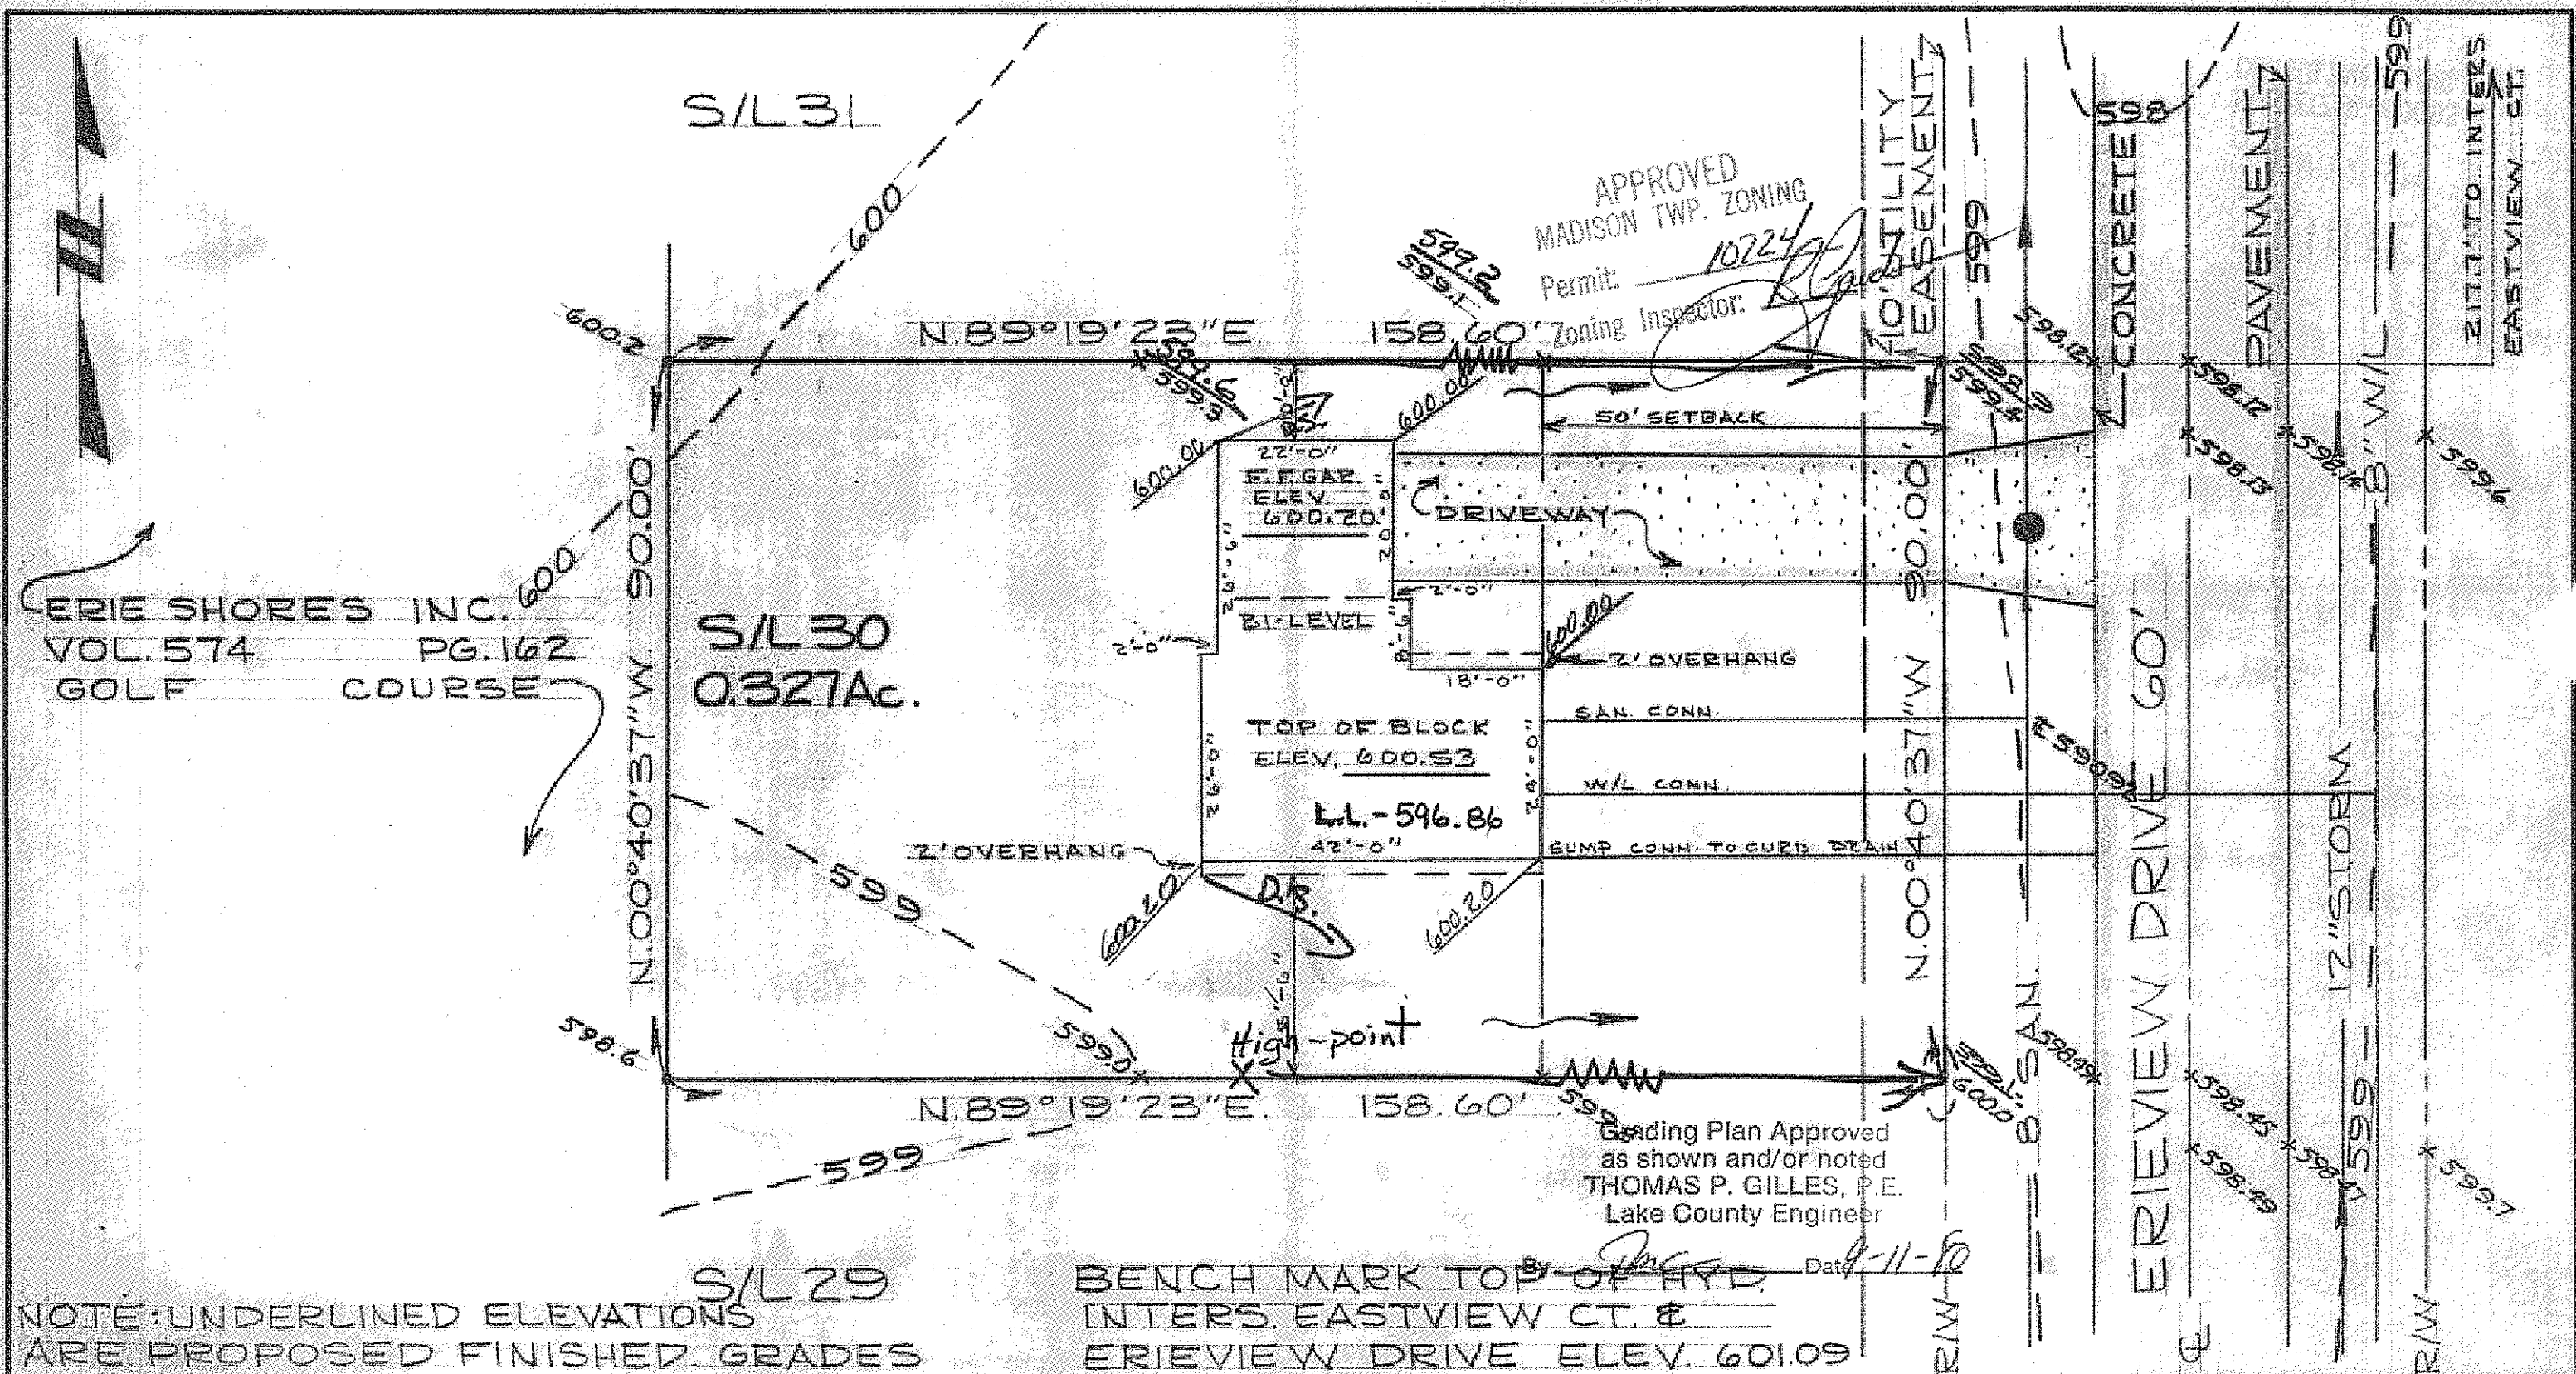

|                                                                                                                                                                                        |                                                                                                                                                                                                                                                 |                                                                               |                                                                                                                                                                 |
|----------------------------------------------------------------------------------------------------------------------------------------------------------------------------------------|-------------------------------------------------------------------------------------------------------------------------------------------------------------------------------------------------------------------------------------------------|-------------------------------------------------------------------------------|-----------------------------------------------------------------------------------------------------------------------------------------------------------------|
| <p><b>DESIGN CERTIFICATION</b></p> <p>THIS PLAT WAS PREPARED BY ME, AND IS CORRECT TO THE BEST OF MY KNOWLEDGE AND BELIEF.</p> <p><i>[Signature]</i></p> <p>REG. SURVEYOR NO. 4785</p> | <p><b>AS BUILT CERTIFICATION</b></p> <p>I HEREBY CERTIFY THAT THE CIRCLED GRADES ARE EXISTING FINISH GRADES CHECKED IN THE FIELD ON _____ AND THAT SURVEY IS CORRECT TO THE BEST OF MY KNOWLEDGE AND BELIEF.</p> <p>REG. SURVEYOR NO. _____</p> | <p><b>COLPETZER · WOODS</b></p> <p>CONSULTANTS, INC.</p> <p><i>[Logo]</i></p> | <p><b>DATE 5/30/19</b></p> <p><b>SCALE 1" = 20'</b></p> <p><b>DRWN BY J.E.</b></p> <p><b>CHKD BY</b></p> <p><b>JOB NO 78/107</b></p> <p><b>FB 361 PG 18</b></p> |
|----------------------------------------------------------------------------------------------------------------------------------------------------------------------------------------|-------------------------------------------------------------------------------------------------------------------------------------------------------------------------------------------------------------------------------------------------|-------------------------------------------------------------------------------|-----------------------------------------------------------------------------------------------------------------------------------------------------------------|