

SITE PLAN

MADISON COUNTY, OHIO

for: MA. GAIDER JR.

BRACKSOLLE, OHIO

ADDRESS CITY ZIP

LOT TRACT
VOLUME PAGE
PANEL NO. STREET

LEGEND

SANITARY MANHOLE
STORM MANHOLE
INLET OR CATCH BASIN
HYDRANT
EXISTING CONTOURS
PROPOSED CONTOURS
EXIST. ELEV.
PROP. ELEV.

REMARKS

ALL BOUNDARY DATA SHOWN WAS OBTAINED FROM (DEEDS, RECORDED
SUBDIVISION PLAT OR OTHER PUBLIC RECORDS)
LOCATIONS AS SHOWN OF ADJACENT WELLS AND SEPTIC TANKS OBTAINED FROM
LAKE COUNTY HEALTH DEPARTMENT

DESIGN CERTIFICATION

THIS PLAT WAS PREPARED BY ME, AND IS CORRECT
TO THE BEST OF MY KNOWLEDGE AND BELIEF.
NAME SURVEYOR REGISTRATION NO.

CHECK LIST

NO. OF BEDROOMS
DIMENSIONS
SEALINGS
TIE TO NEAREST STREET
SUBJECT NO. PARCEL NO.
SURROUNDING OWNERS
BLDG. DIMENSIONS, FIN. GR.
BLDG. TYPE, GRADES
APPROX. TYPE WIDTH THICKNESS
SIDEWALK TYPE WIDTH THICKNESS
CULVERT TYPE DIA. LENGTH
ROCK OUTCROPPINGS

PLAN PREPARED BY:

BABCOCK • JONES & ASSOCIATES, INC.
PAINESVILLE, OHIO

NO.	DATE	BY
1	5/10/83	MB
2		
3		
4		
5		

"AS BUILT" CERTIFICATION

I, HEREBY CERTIFY THAT THE CIRCLED GRADES ARE EXISTING
FINISH GRADES CHECKED IN THE FIELD ON 19
AND ARE CORRECT TO THE BEST OF MY KNOWLEDGE AND BELIEF.

REGISTERED SURVEYOR

REG. NO.

MAILED E-2

40' MIN. S.B.
10' MIN. S.T. 25' MIN. YARD

T.B.M. - R.M. STATION MARK
ELEV. 600.88

MAY 26 1983

MAY 11 1983


APPROVED

MADISON TWP. ZONING

Permit 11196

Zoning Inspector: [Signature]

ERIEVIEW DR. 60'

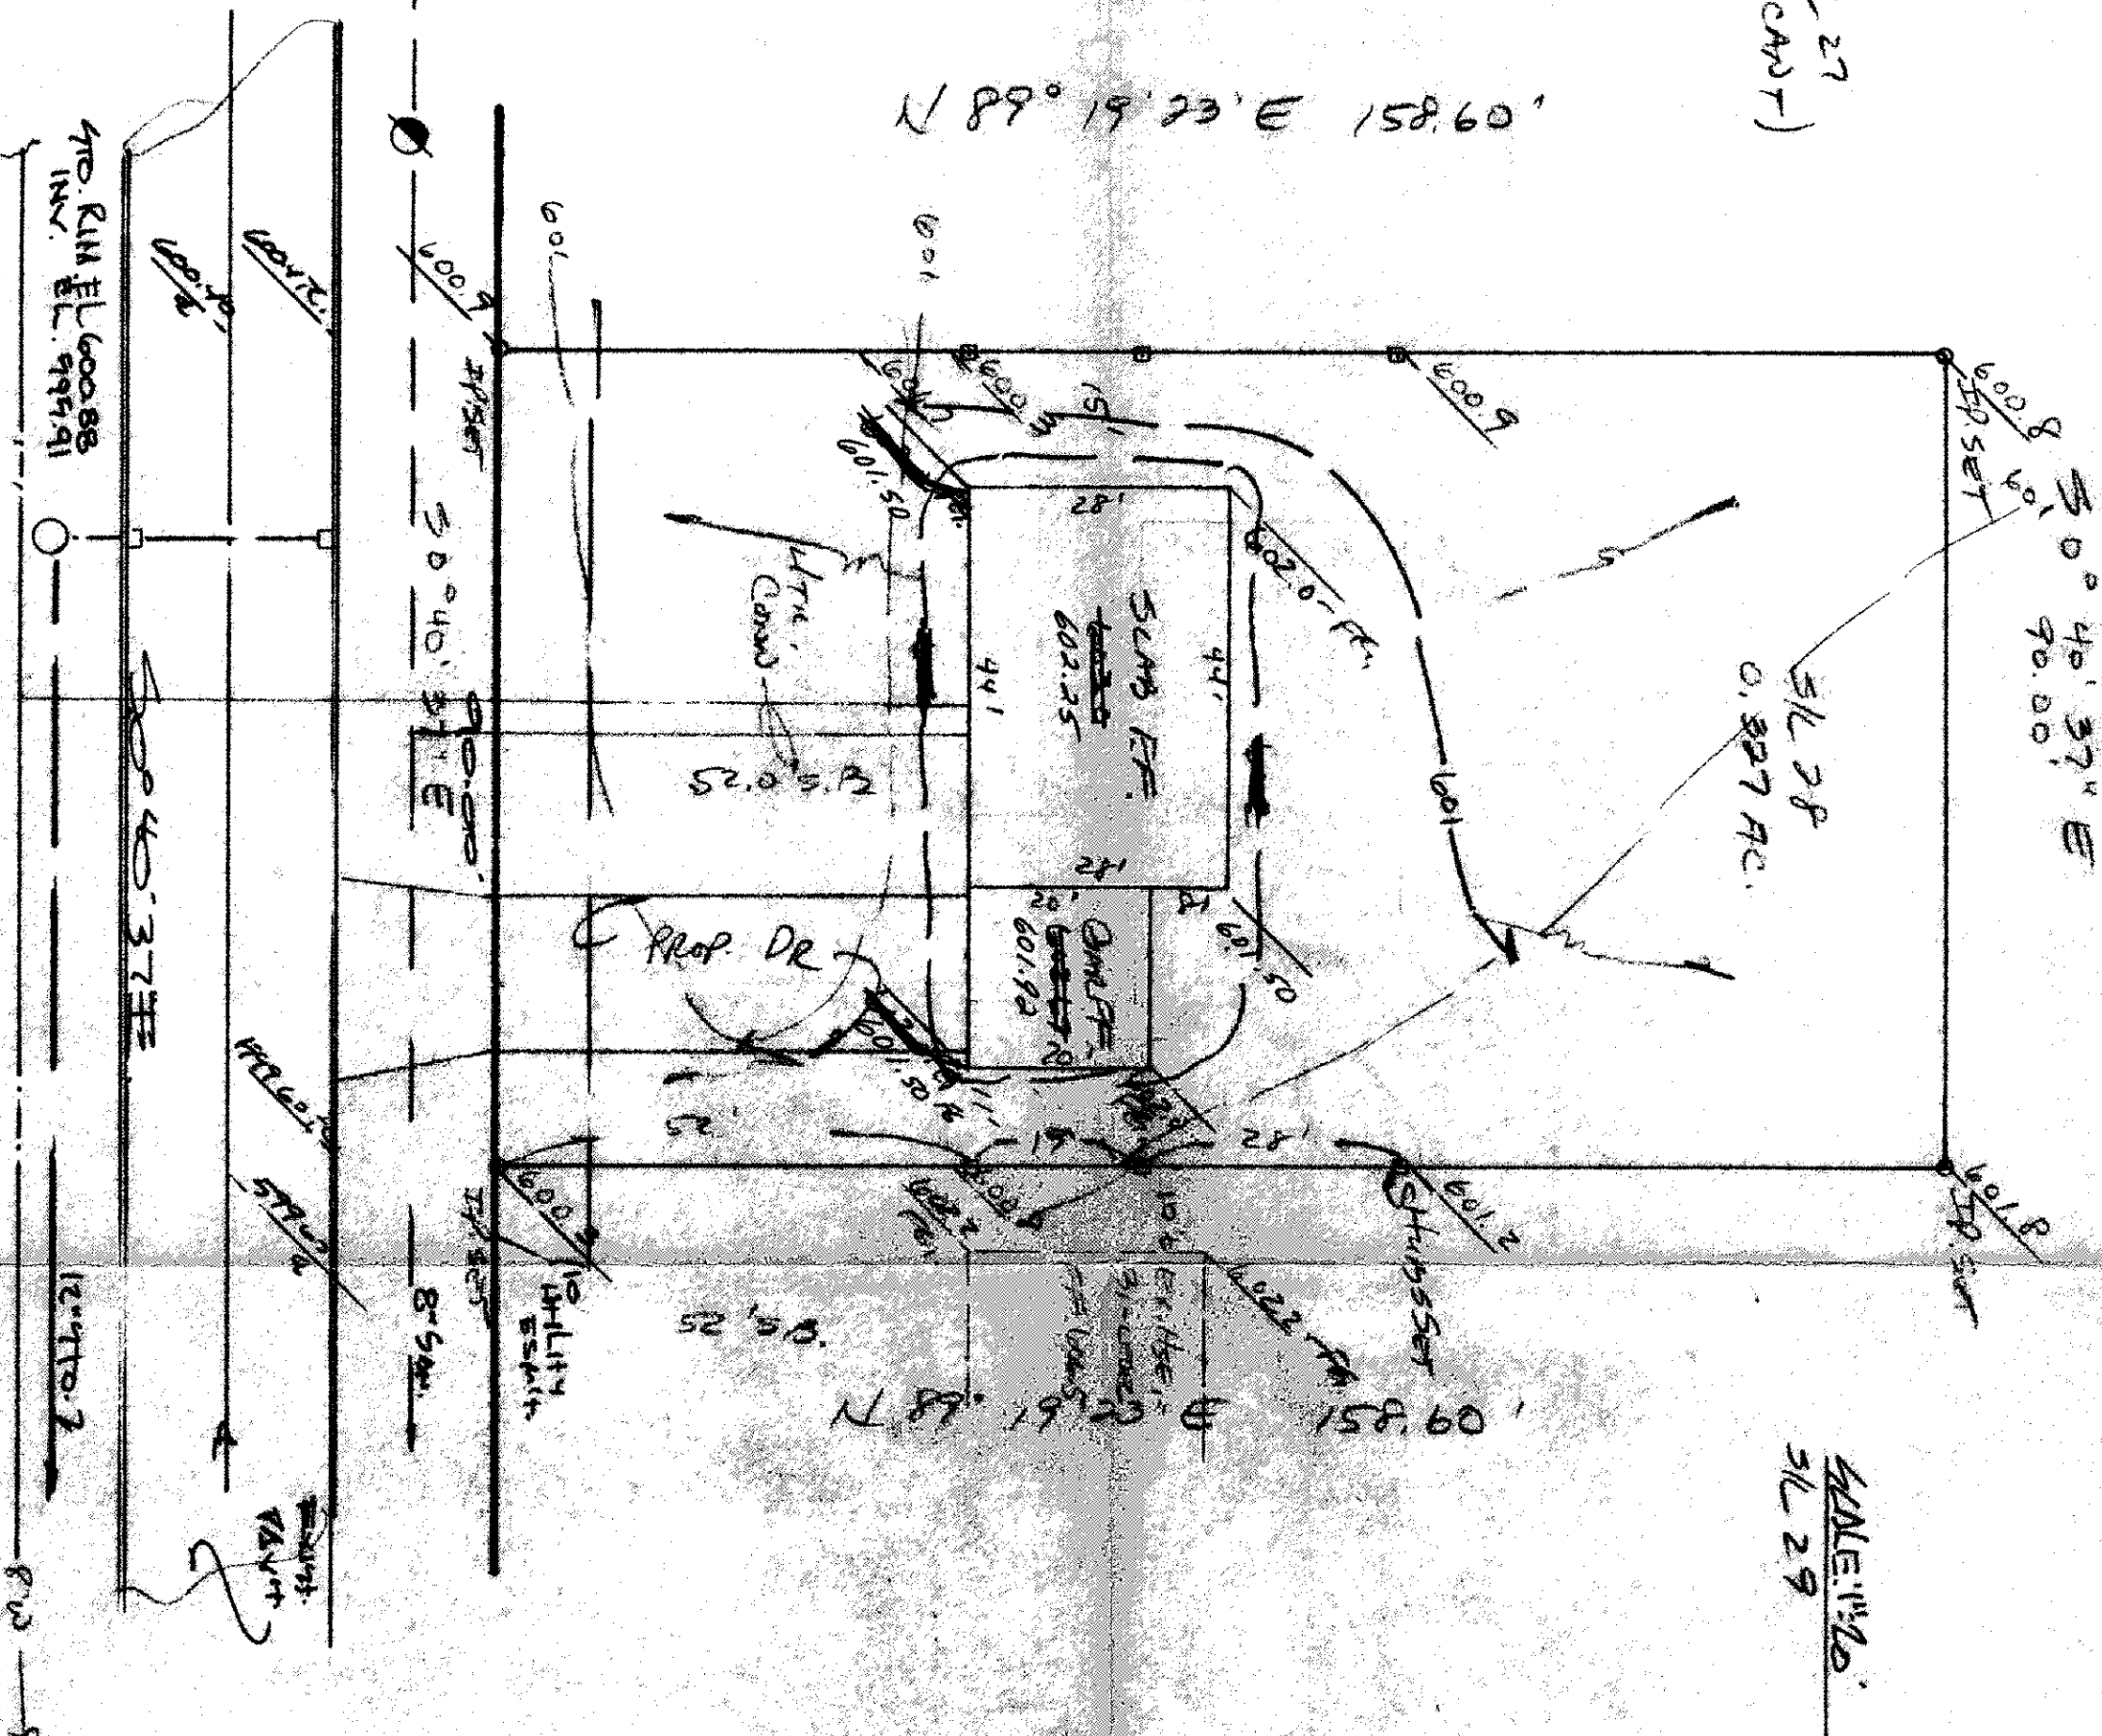

Grading Plan Approved
as shown and/or noted
THOMAS P. GILLES, P.E.
Lake County Engineer
By [Signature] Date 7/1/83