


MICHAEL D. HASLETT
VOL. 751 Pg. 1209

RICHARD R. EDWARDS M.
ROBINSON, VOL. 817 Pg. 1002

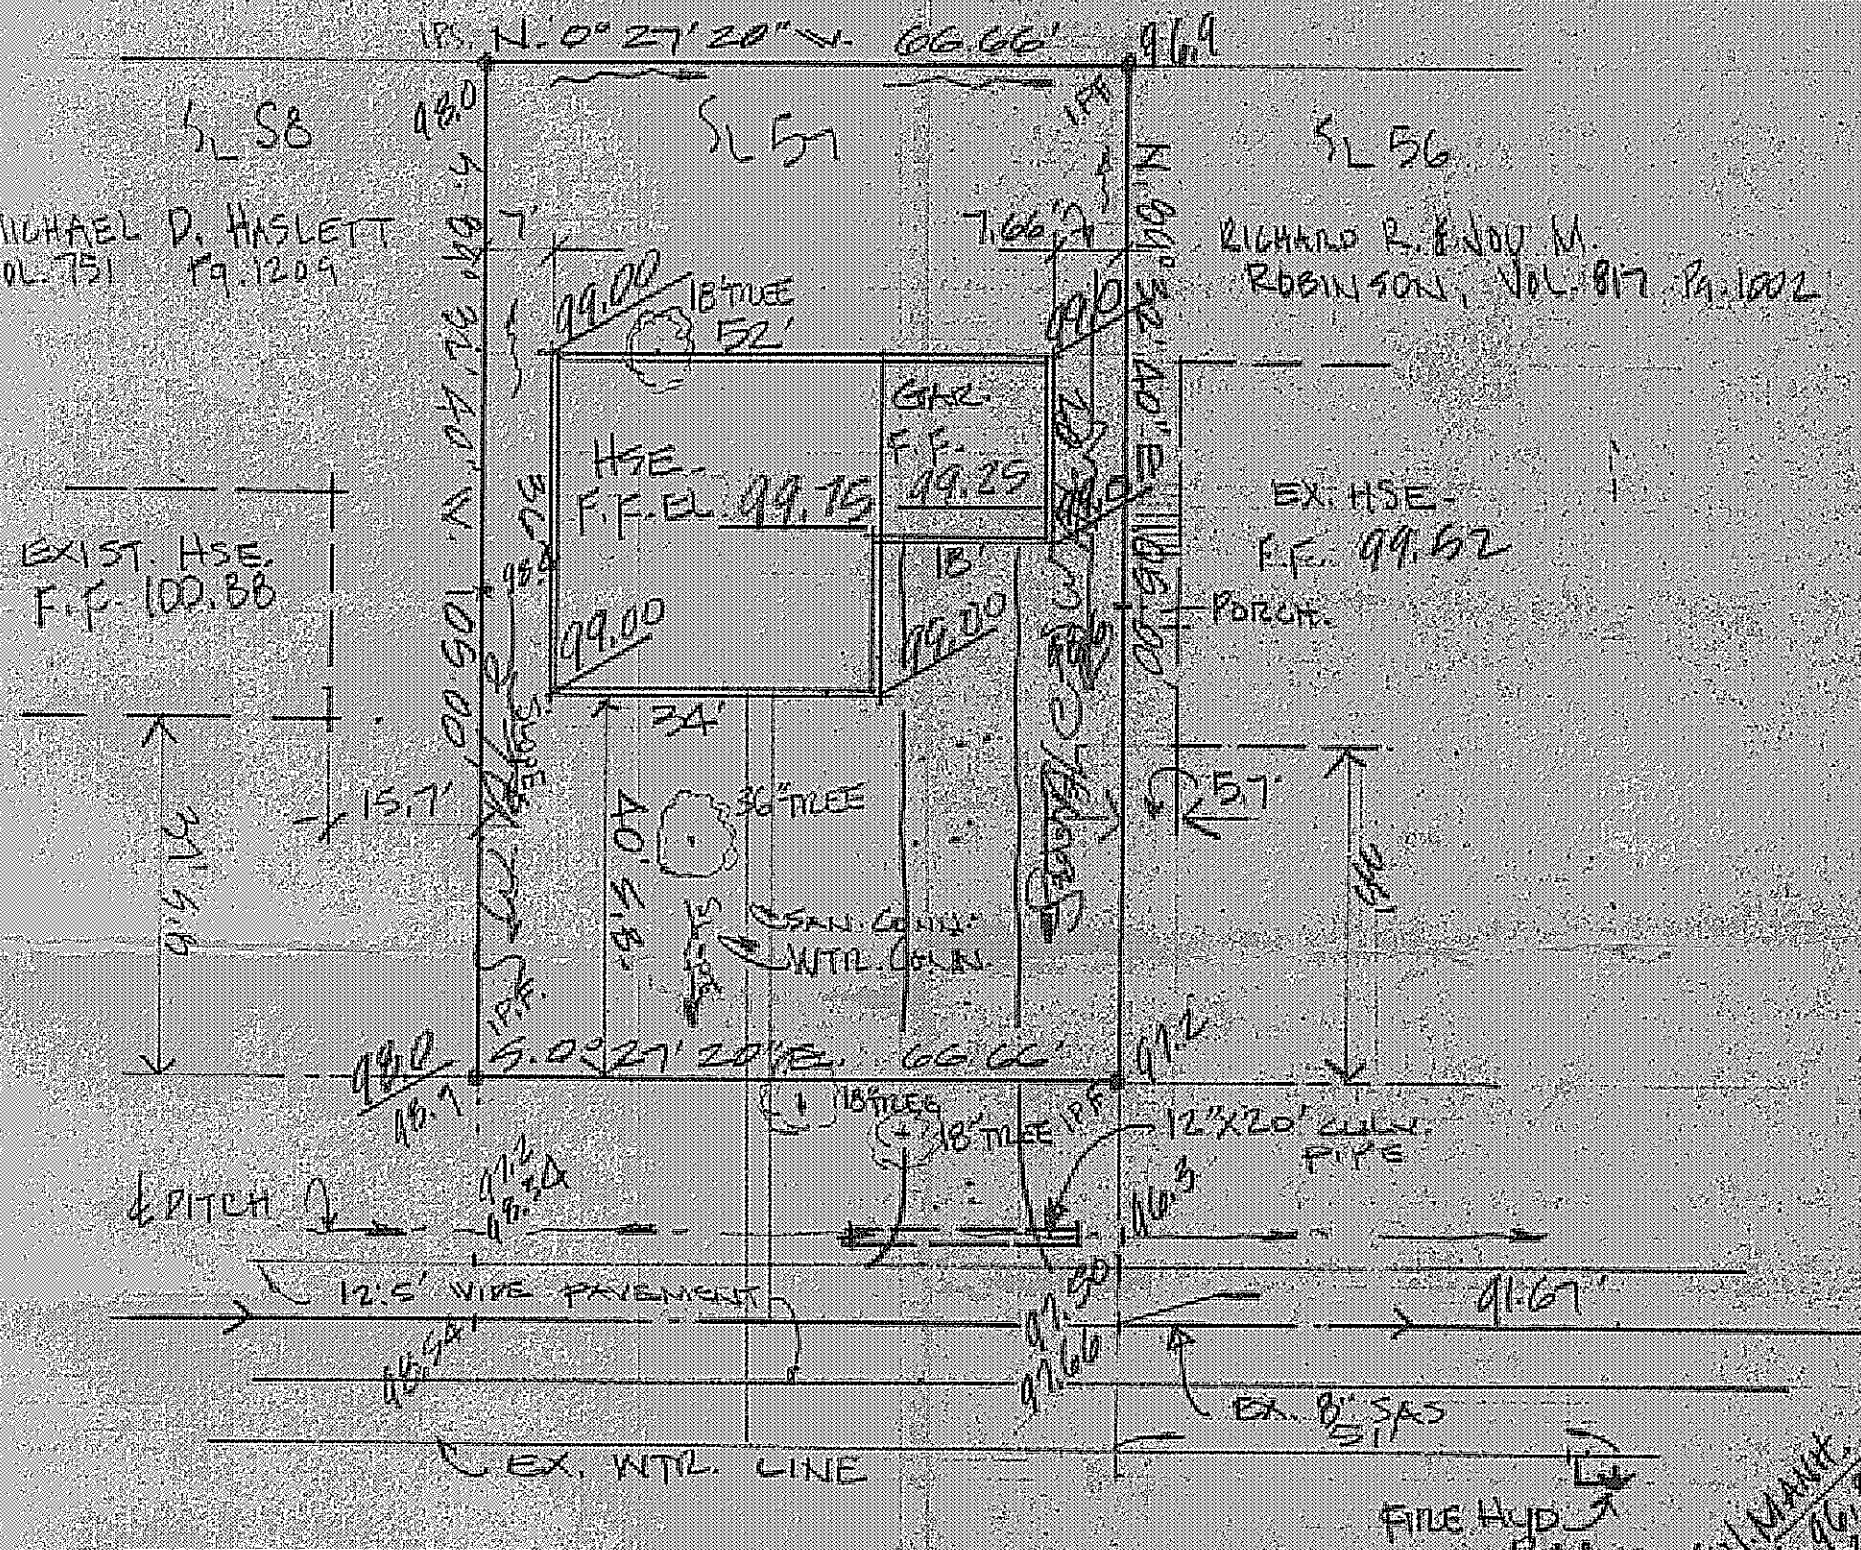

B.M. TOP OF FIRE HYD.
ELEV. 100.00

Tag Plan Approved
shown and/or noted
P. GILLES, P.E.
County Engineer
Date 20/1/17

APPROVED
MADISON ZONING
Permit 9900
Zoning Inspector RLB

FALKIRK ROAD 50'

DESIGN CERTIFICATION THIS PLAT WAS PREPARED BY ME AND IS CORRECT TO THE BEST OF MY KNOWLEDGE AND BELIEF. <i>[Signature]</i> REG. SURVEYOR NO. 4785	AS BUILT CERTIFICATION I HEREBY CERTIFY THAT THE CIRCLED GRADES ARE EXISTING FINISH GRADES CHECKED IN THE FIELD ON _____ AND THAT SURVEY IS CORRECT TO THE BEST OF MY KNOWLEDGE AND BELIEF. REG. SURVEYOR NO. _____	COLPETZER WOODS CONSULTANTS, INC. 180 SOUTH STATE STREET • PAINESVILLE, OHIO 44077 • (216) 357-7569	DATE 9/12/17 SCALE 1"=20' DRWN BY [Signature] CHKD BY [Signature] JOB NO. 17-020 FB 3/2 PG	SITE PLAN FOR WILLIAM SNYDER CHIPPENVA ROAD, BRUCEVILLE, OH BEING 3.15 AC. NO. 57 IN THE MADISON GOV. LANDS SIGNED NO. 1 IN MADISON TWP. OHIO.
---	--	---	---	---