


Grading Plan Approved
as shown and/or noted
THOMAS P. GILLES, P.E.
Lake County Engineer
Date 10-22-76

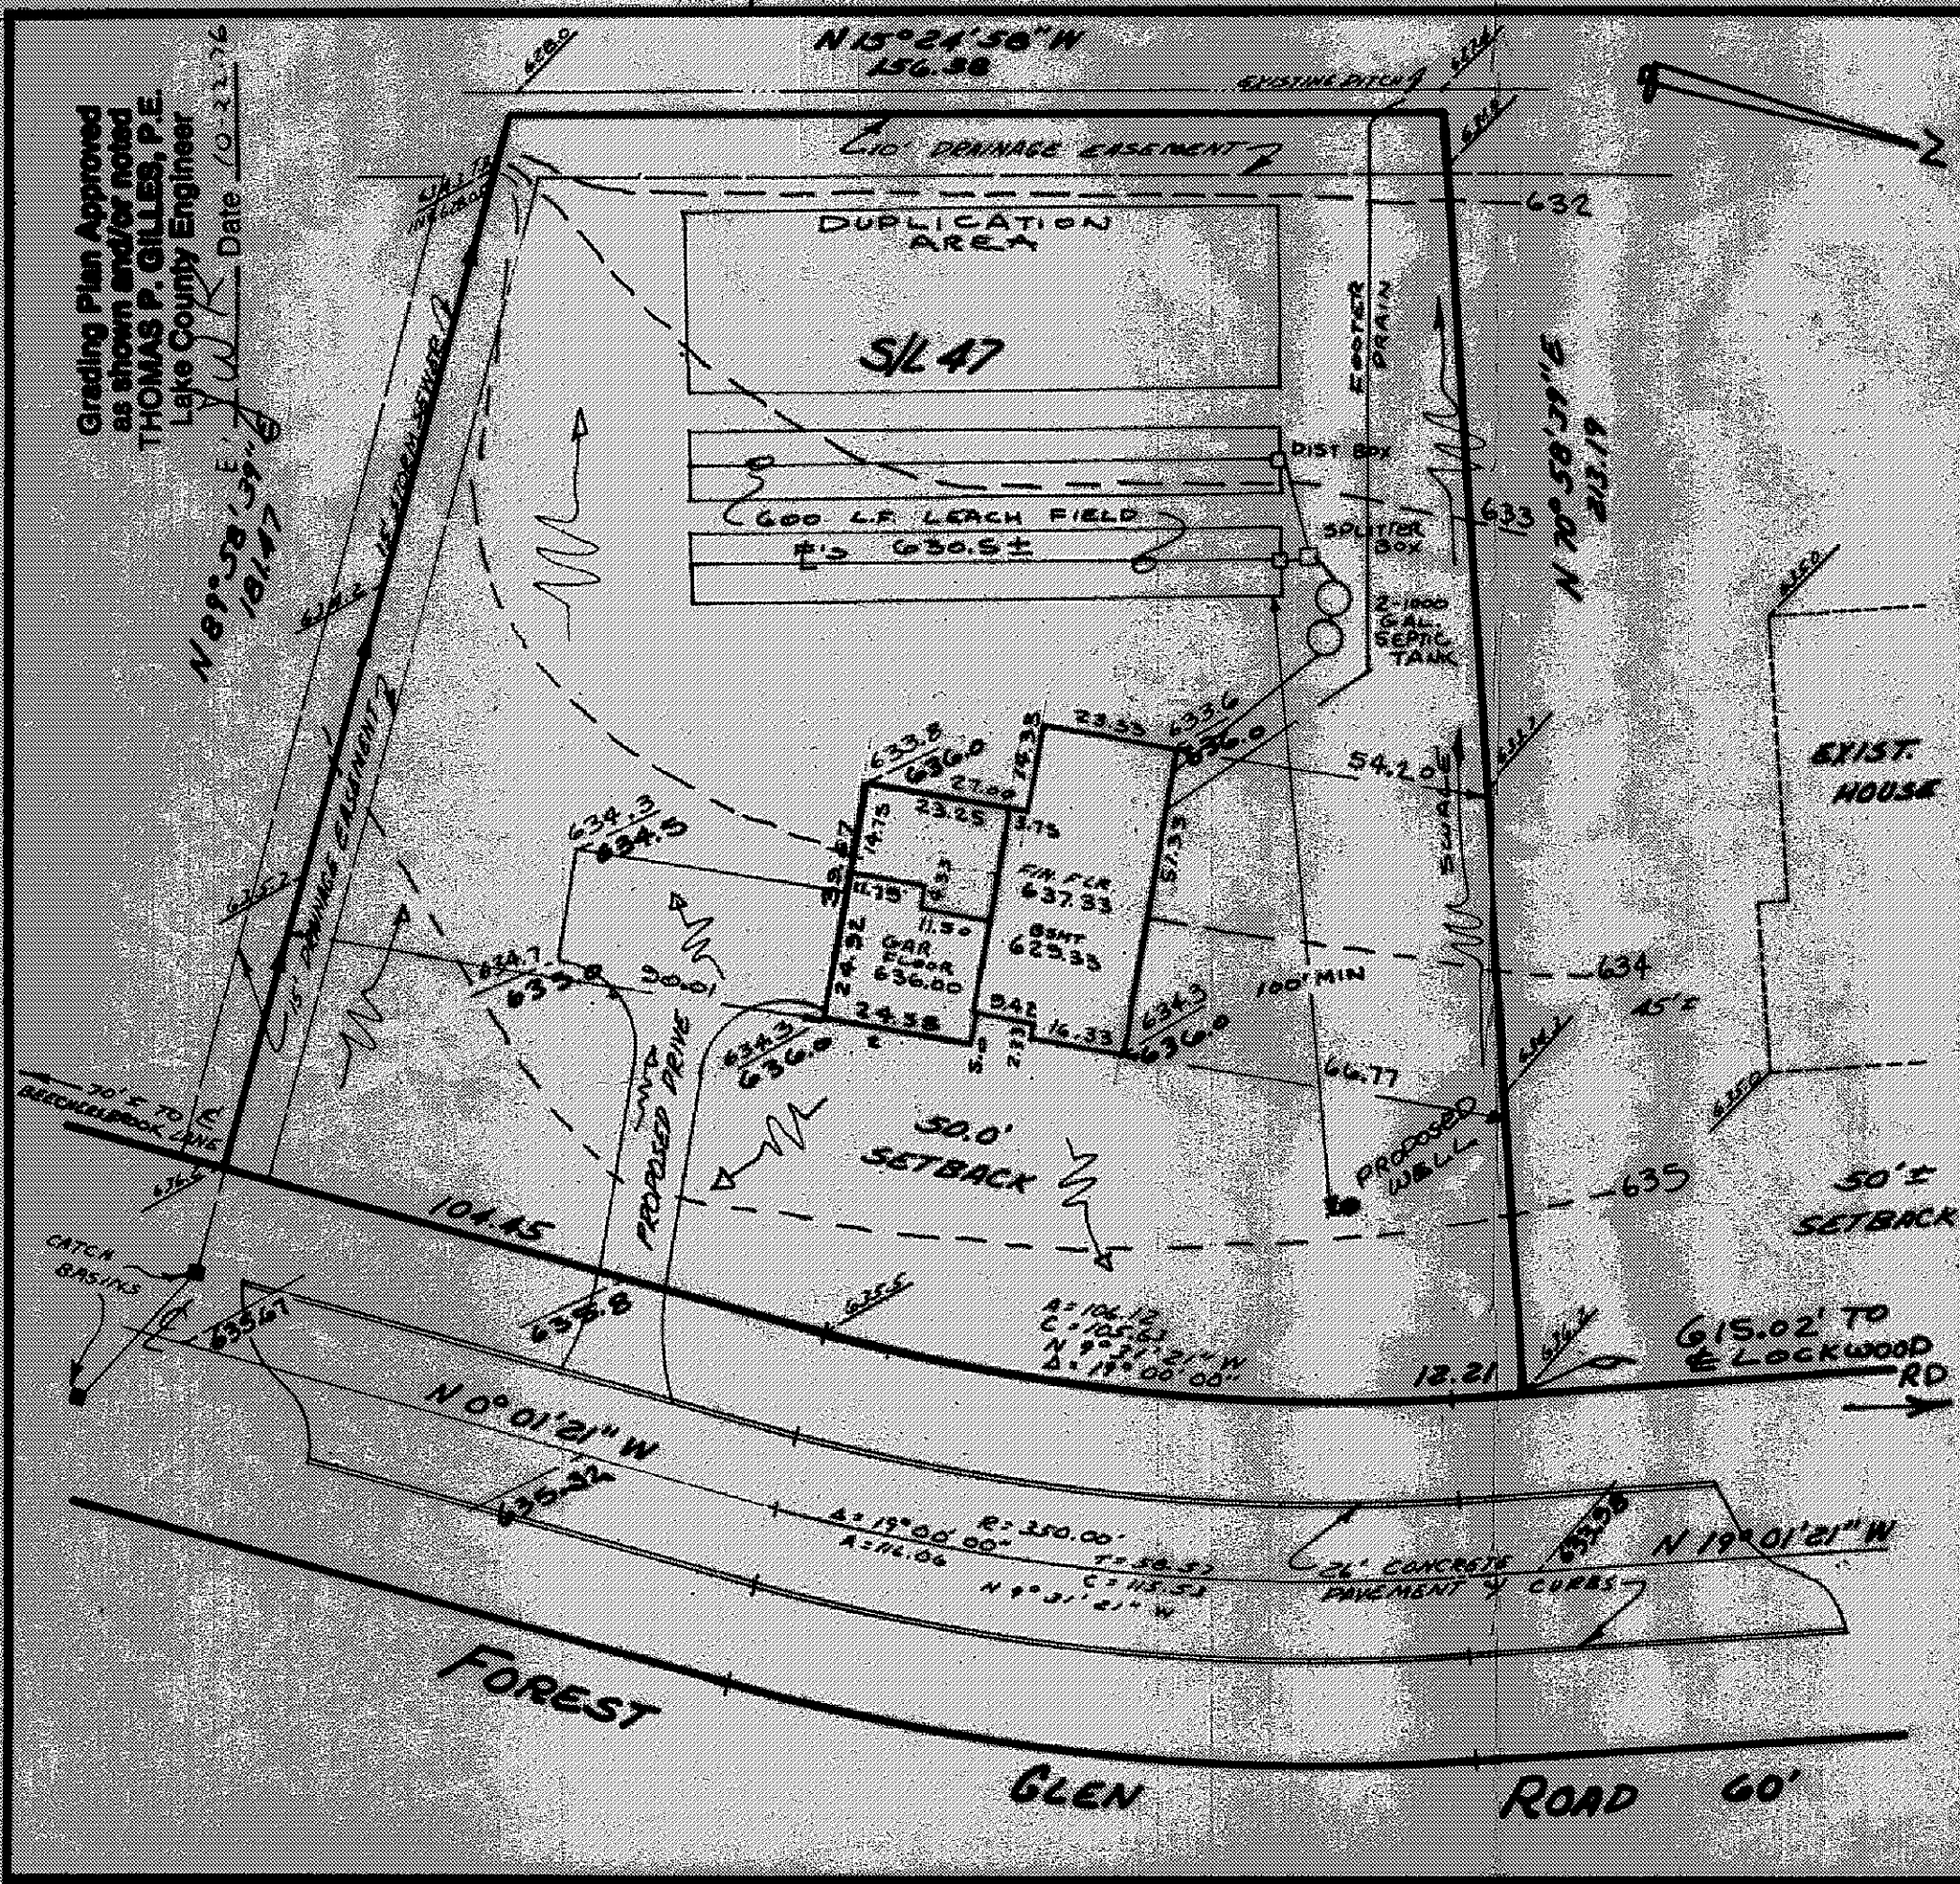

SITE PLAN

MADISON
TOWNSHIP

LAKE COUNTY, OHIO

for: **JERRY ONDRICK**
CLIENT OWNER

ADDRESS STREET CITY ZIP

FOREST GREENE		LOT	TRACT
SUBDIVISION	NAME	VOLUME	PAGE
47	FOREST GREEN	PERM. PARCEL NO.	STREET
SUBLOT NO.	STREET		

LEGEND

SANITARY MANHOLE	---	WATER VALVE (GAS)	---
STORM MANHOLE	---	WATER METER (GAS)	---
INLET OR CATCH BASIN	---	AS BUILT ELEVATION	---
HYDRANT	---		
EXISTING CONTOURS	---		
PROPOSED CONTOURS	---		
EXIST. ELEV.	---		
	100.0	PROP. ELEV.	100.0

REMARKS

ALL BOUNDARY DATA SHOWN WAS OBTAINED FROM (DEEDS, RECORDED SUBDIVISION PLAT OR OTHER PUBLIC RECORDS)
LOCATIONS AS SHOWN OF ADJACENT WELLS AND SEPTIC TANKS OBTAINED FROM LAKE COUNTY HEALTH DEPARTMENT

DESIGN CERTIFICATION

THIS PLAT WAS PREPARED BY ME, AND IS CORRECT TO THE BEST OF MY KNOWLEDGE AND BELIEF.

NAME **Robert J. Debevec** SURVEYOR REGISTRATION NO. **PS 5244**

CHECK LIST

NO. OF BEDROOMS	WATER MAIN SIZE, LOCATION
DIMENSIONS	SAN. SEWER SIZE & GR. LOC.
BEARINGS	SAN. MH. CAST. ELEV. INV. ELEV.
TIE TO NEAREST STREET	SAN. CONN. SIZE, LOC. DEPTH
SUBLOT NO. PARCEL NO.	STORM SEWER SIZE & GR. LOC.
SURROUNDING OWNERS	STORM MH. CAST. ELEV. INV. ELEV.
BLDG. DIMENSIONS FIN. GR.	PAV'T TYPE GRADE CURBS
BLDG. TIES FLTR. GRADES	GAS LINE LOC. SIZE PRESSURE
APRON TYPE WIDTH THICKNESS	SEPTIC TANK LOCATION & DUPLICATION AREA
SIDEWALK TYPE WIDTH THICKNESS	WELL LOCATION
CULVERT TYPE DIA. LENGTH	ISOLATION RADIUS FROM WELL
ROCK OUTCROPPINGS	

REVISIONS			PLAN PREPARED BY:		
NO.	DATE	BY	DEBEVEC - SALO & ASSOCIATES, INC.		
1			130 EAST JACKSON ST. PAINESVILLE, OHIO		
2			DRAWN BY LR	SCALE 1"=30'	PHONE NO. 332-9250
3			CHK'D DJB	DATE 9-9-76	DRAWING NO. 4256-47
4			CREW CHIEF	APP'D.	
5					