


Grading Plan Approved
as shown and/or noted
THOMAS P. GILLES, P.E.
Lake County Engineer


1. Scale as shown
2. Lower Fl. as noted
3. An ESC plan may be
required from LGSWCD

4. ROOF DRAINS
SHALL DISCHARGE
TO SPLASH BLOCKS


By TAM Date 3/20/2000

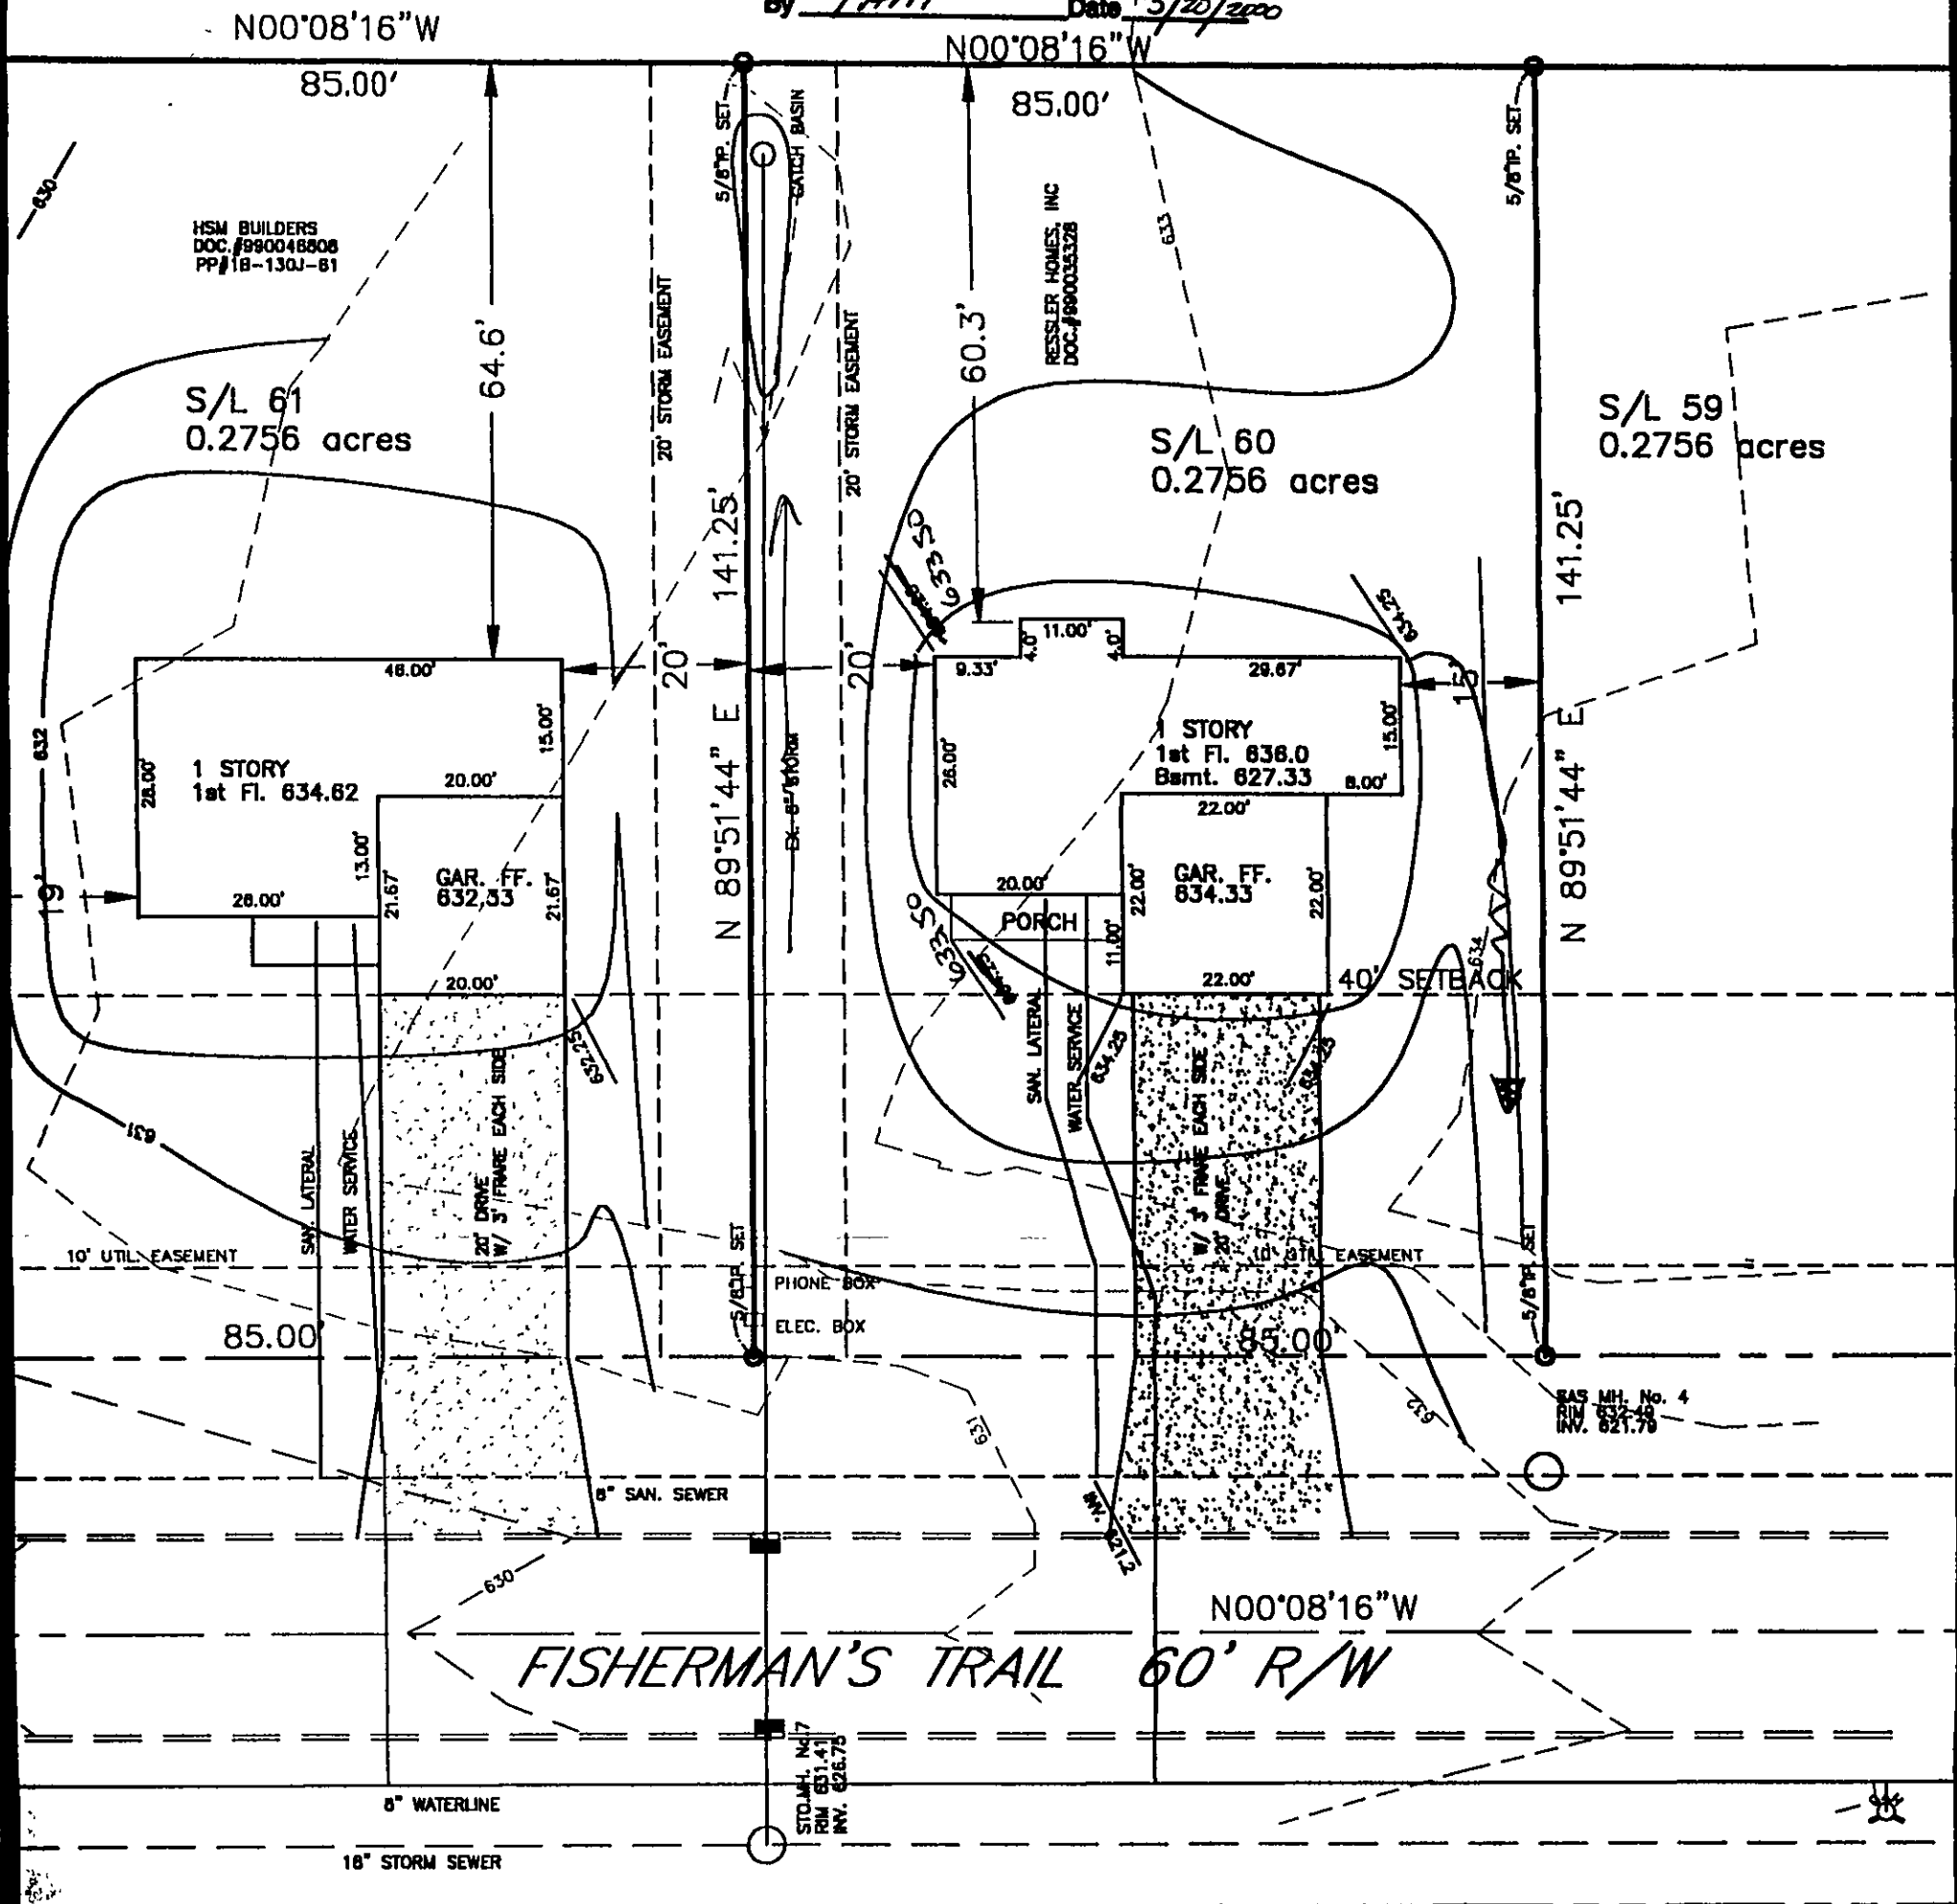

GRAPHIC SCALE

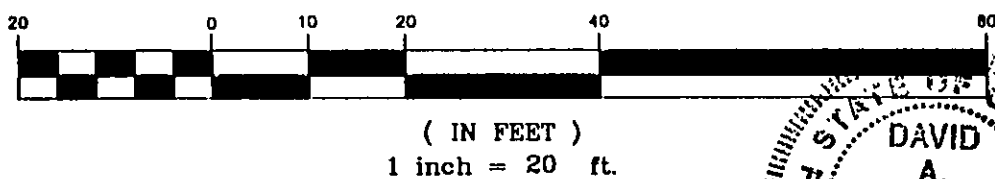

APPROVED
MADISON TOWNSHIP ZONING
DATE 3/20/00
DA 20043

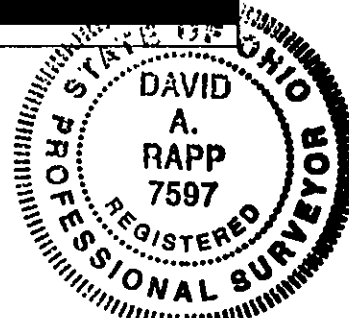

NOTES : 1. The Contractor Shall Verify the Following Before Starting:
Finish Floor Elevations and House Size.
Location and elevation of existing utility connections.
2. Contractor Shall Contact OUPS at least 2 Working
Days prior to construction, 1-800-362-2764.

"I, the undersigned hereby certify that
this topography, indicated by 1' contours
and elevations shown hereon represents an
actual field survey made by me in March, 2000
and that the elevations were taken at appropriate
intervals and that as of that date they existed
as indicated hereon."

David A. Rapp 3-9-2000
Reg. No. 7597

20025

COR Consultants, Inc.
23 S. Forest Street Geneva, Ohio 44041
440-466-8085

DATE: MARCH, 2000
DRAWN BY: DAR
CHECKED BY: RMO
APPROVED BY: DAR
P.S. No. 7597

HSM BUILDERS
Windjammer Bay Sub. Phase 2
Site Plan For Sublot 60