


SITE PLAN
TROY OAKS HOMES
LOT 1 TRACT 3
MADISON TOWNSHIP

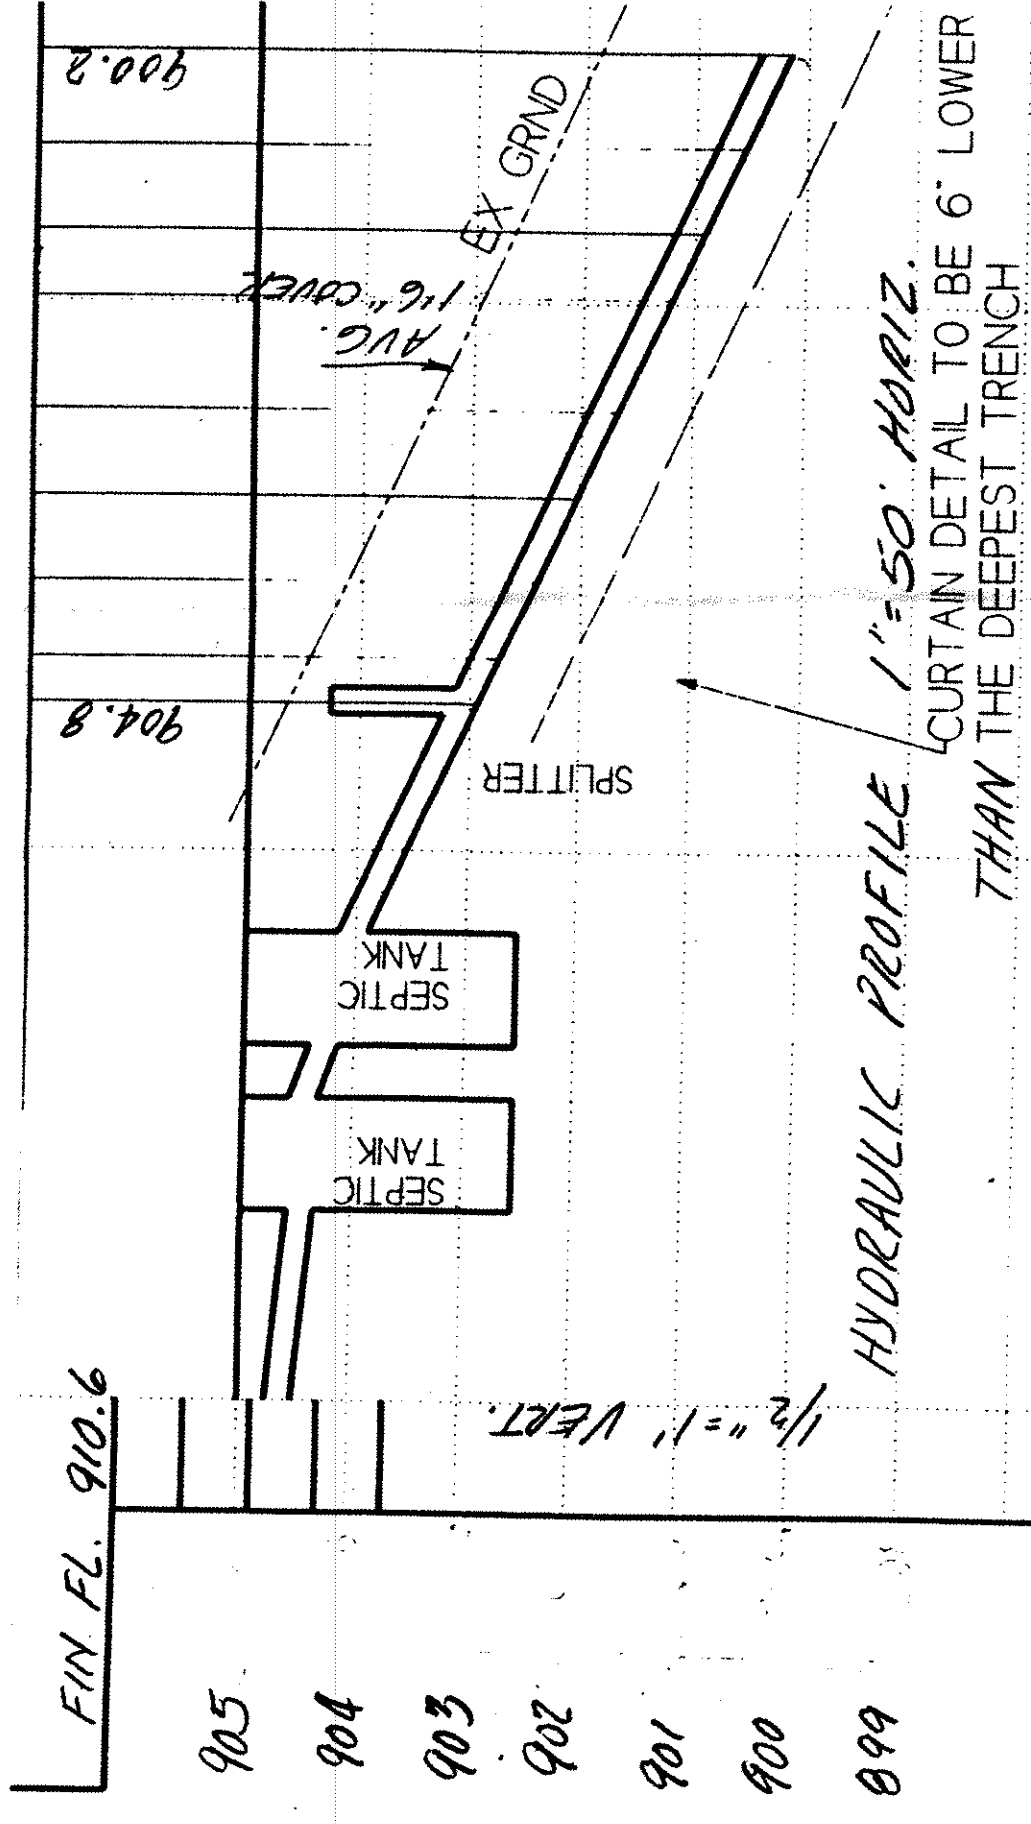

FILE 1"=50' HORIZ.
CURTAIN DETAIL TO BE 6" LOWER
THAN THE DEEPEST TRENCH

S 00° 22' 30" W

2767.51


N00° 22' 30" E

OCAPPED IRON PIN FOUND
SCALE 1"=30'

1. THE UNDERSIGNED HEREBY CERTIFY THAT THE TOPOGRAPHY SHOWN HEREON AS INDICATED BY 1" CONTOURS AND ELEVATIONS REPRESENTS AN ACTUAL FIELD TOPOGRAPHIC SURVEY MADE BY ME ON THE 15TH DAY OF JULY, 1906 AND THAT THE ELEVATIONS WERE TAKEN AT APPROPRIATE INTERVALS AND THAT AS OF THAT DATE THEY EXISTED AS INDICATED HEREON.

Wm. H. Ferry
Ferry, Gay
Ohio Surveyor Number 5298

I hereby certify that I have surveyed this parcel and that the same is true and correct. This parcel was surveyed in accordance with the provisions of Chapter 4733-37 of the Ohio Administrative Code.

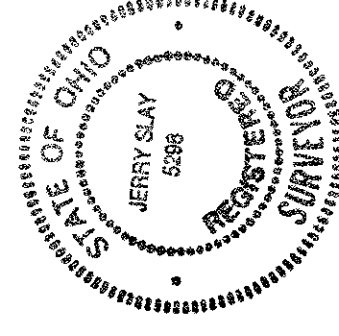


Reviewed and Accepted _____
LAKE COUNTY GENERAL HEALTH DISTRICT
Date 8-30-96
JOEL LUCIA, R. S. M. P. H.
Health Commissioner
BY J. Lucia


- A. To be brought to finished grade
 1. Septic tank manhole covers
 2. Splitter box cover
 3. Distribution box cover
- B. No footer drains or downspouts to be discharged into septic tanks
- C. All waste water to be discharged into septic tanks

**LOW YIELD WATER
FIXTURES REQUIRED
ON ALL:
Shower Head
Toilet**

**SERVICE DISJUNCTIONAL PERMIT MUST BE
OBTAINED BY A LAKE COUNTY LICENSED
INSTALLER BEFORE INSTALLATION IS
STARTED.**

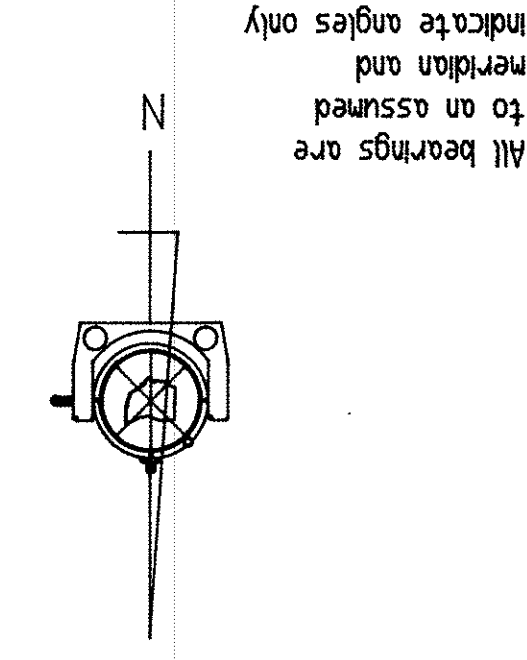

08/20/96

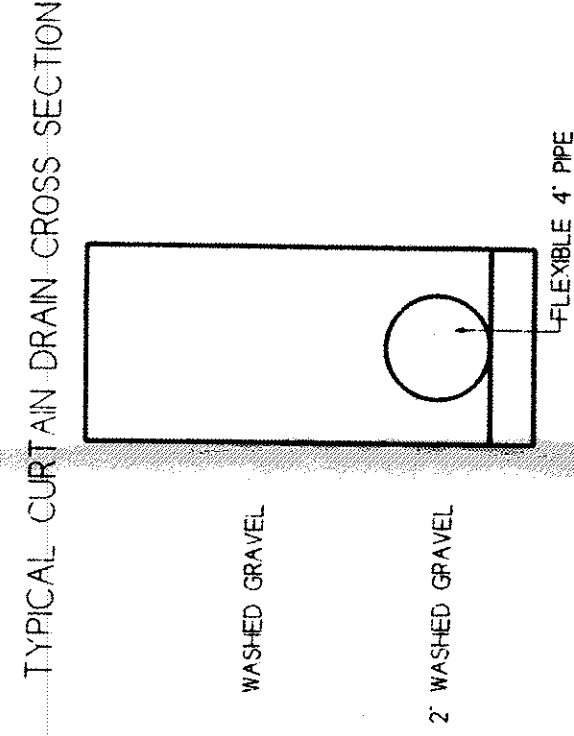

TYPICAL E.T. CROSS SECTION NO SCALE

24"

MINIMUM 2" TOPSOIL

10" MEDIUM COARSE SAND

2" MEDIUM COARSE SAND

8" GRAVEL

2" MEDIUM COARSE SAND

4" 3 HOLE ABS. OR PVC. PIPE

BOARD OF LAKE CO. COMM. 681-502


STONE DRIVE

OK, WELL

1/2" five Colvert

3900.000000

354, 48

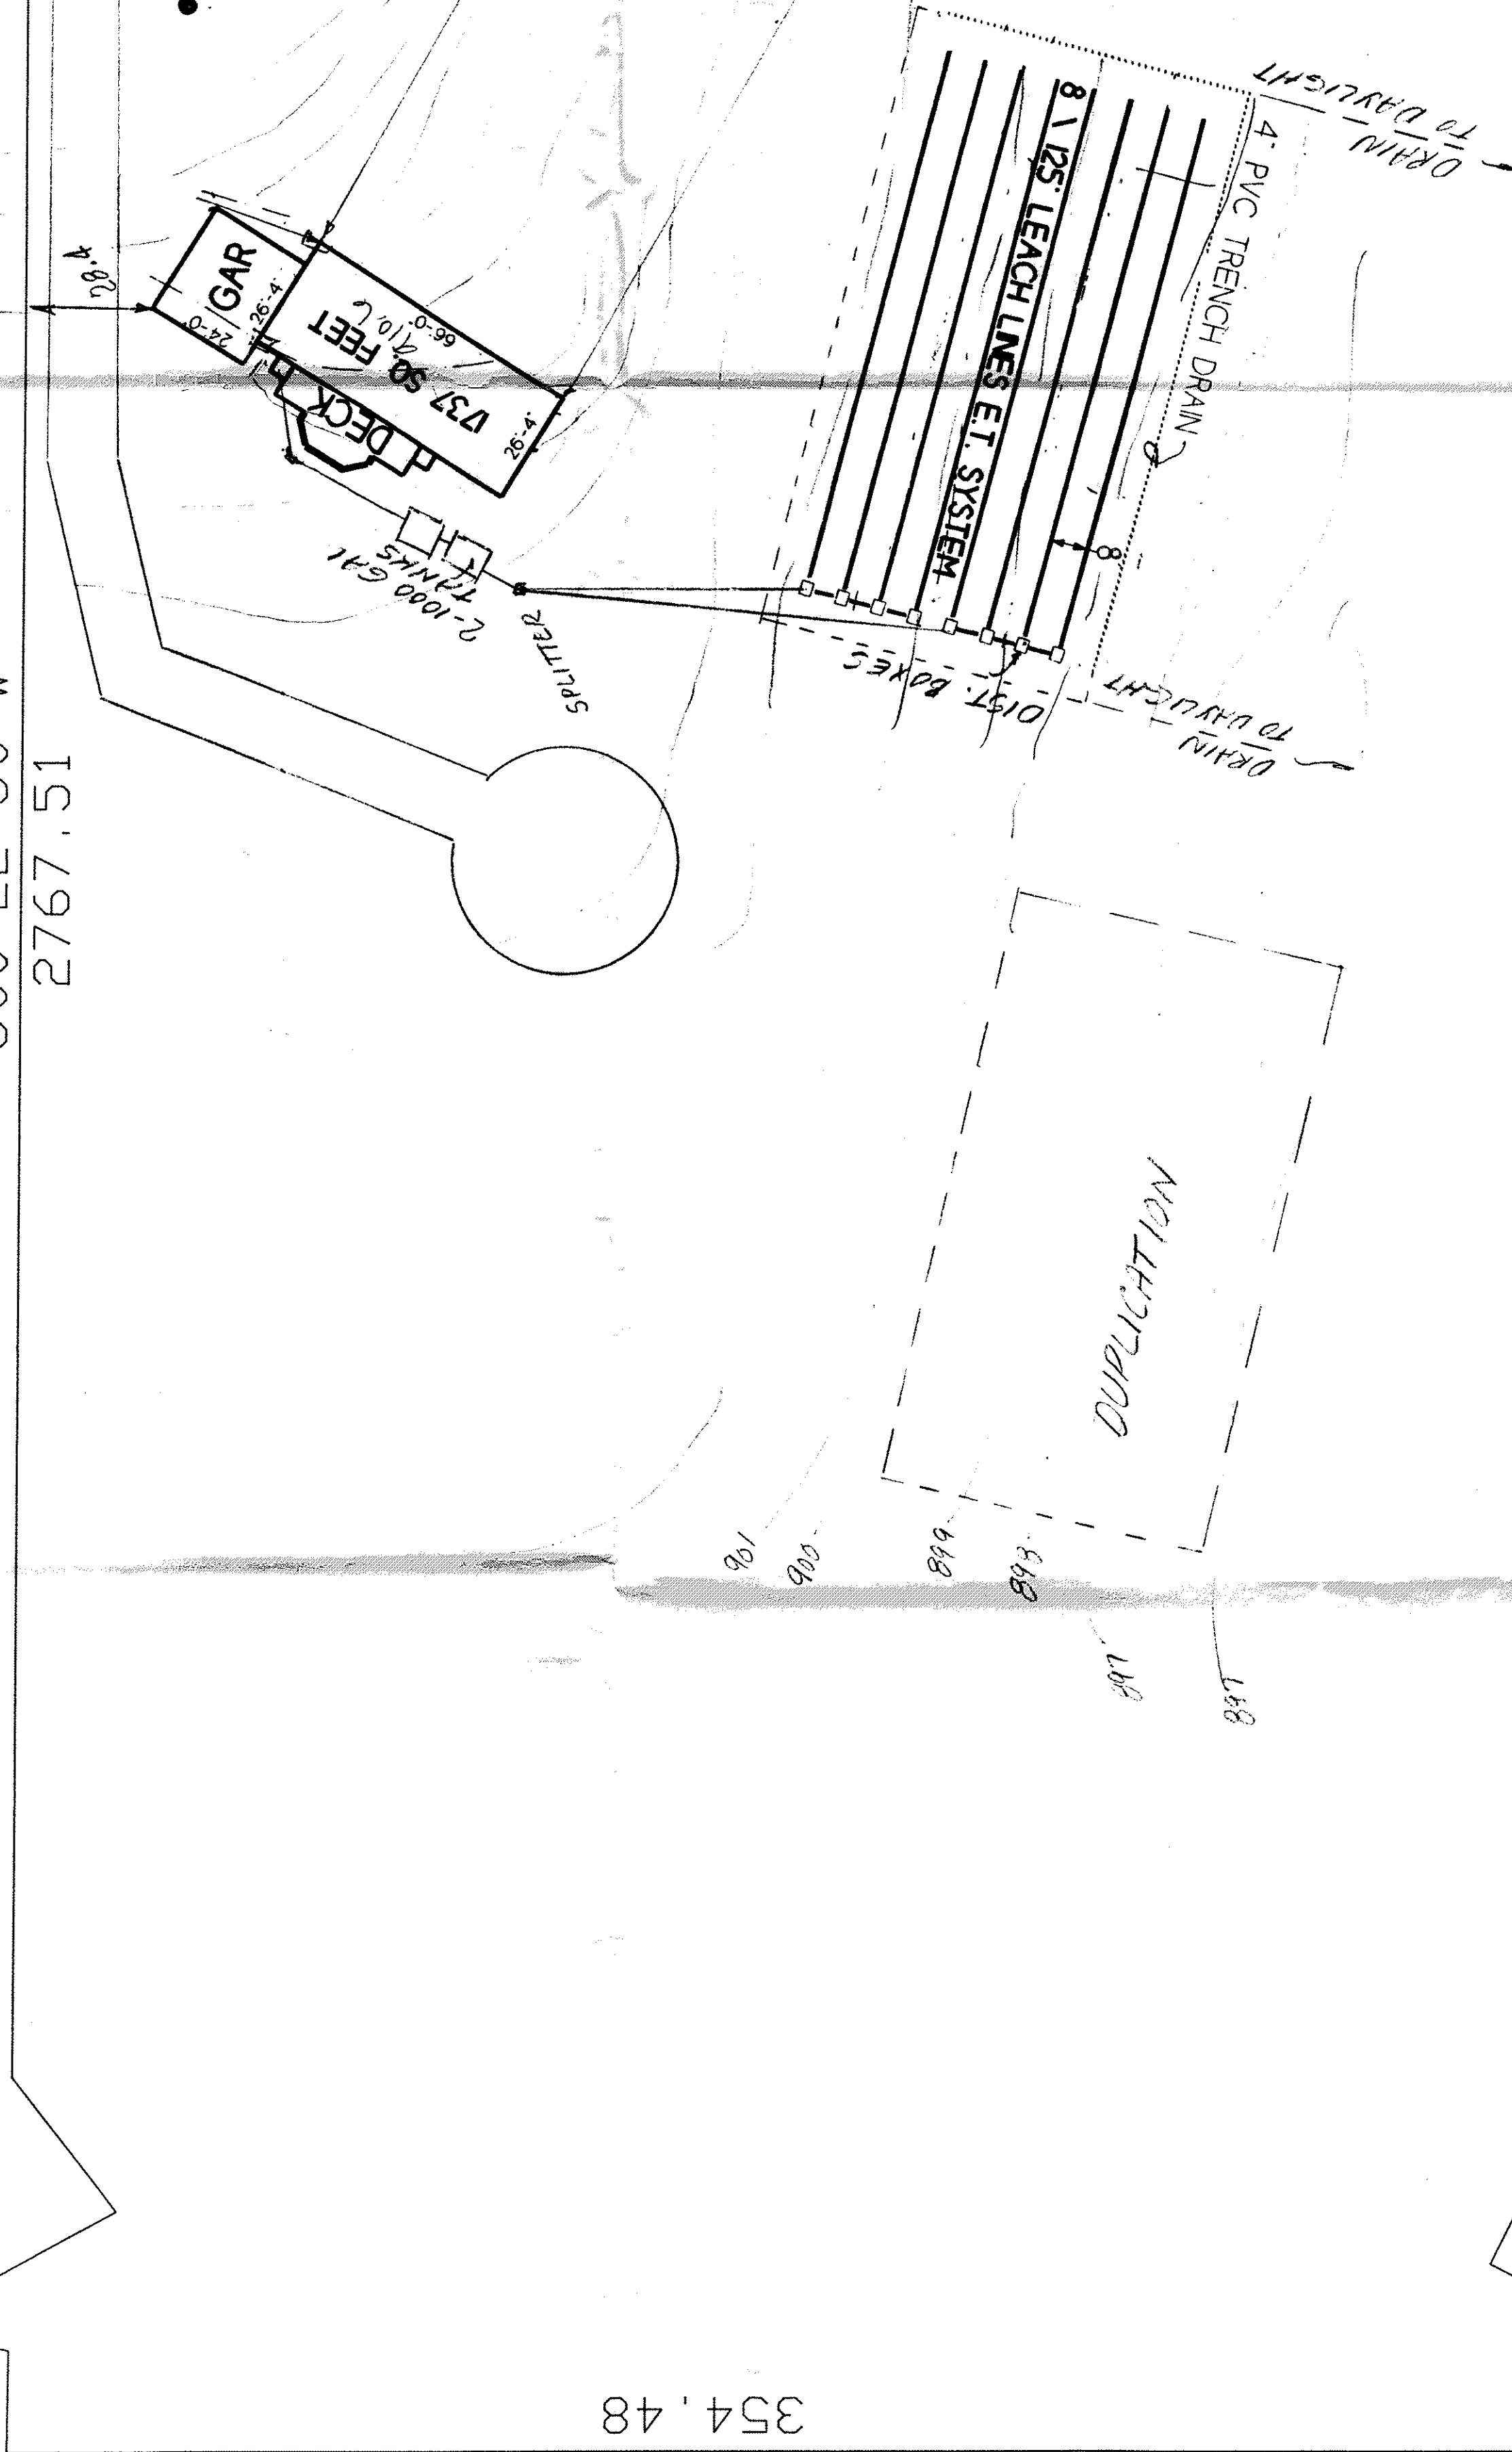

52

Graduate Program in
 Leadership Studies
 The College of William & Mary
 Williamsburg, Virginia 23187-8700
 Phone: 800-541-2222
 Fax: 800-541-2222
 E-mail: gradinfo@wm.edu

6514 9-13-96