

**CRABBS'**  
**SURVEYING**  
**SERVICE**

WESTERN RESERVE BUILDING  
70 NORTH ST. CLAIR STREET SUITE 300  
PANESVILLE, OHIO 44077  
PHONE: (216) 357-3941  
FAX: (216) 357-1816  
1-800-488-3968

72 S. CHESTNUT STREET  
JEFFERSON, OHIO 44047  
PHONE (216) 576-3488  
FAX (216) 576-3511


JOB 1460PLOT

**APPROVED**  
MADISON TOWNSHIP ZONING

SEP 6 1996


**SITE PLAN \ TOPO**  
FOR SUBLOTS 1130 AND 1132 HOLIDAY CONSTRUCTION  
1 STORY FRAME DWELLING 1200 SQ FT

DETAILS & PLAT BEARINGS  
INSPECTOR *dk*

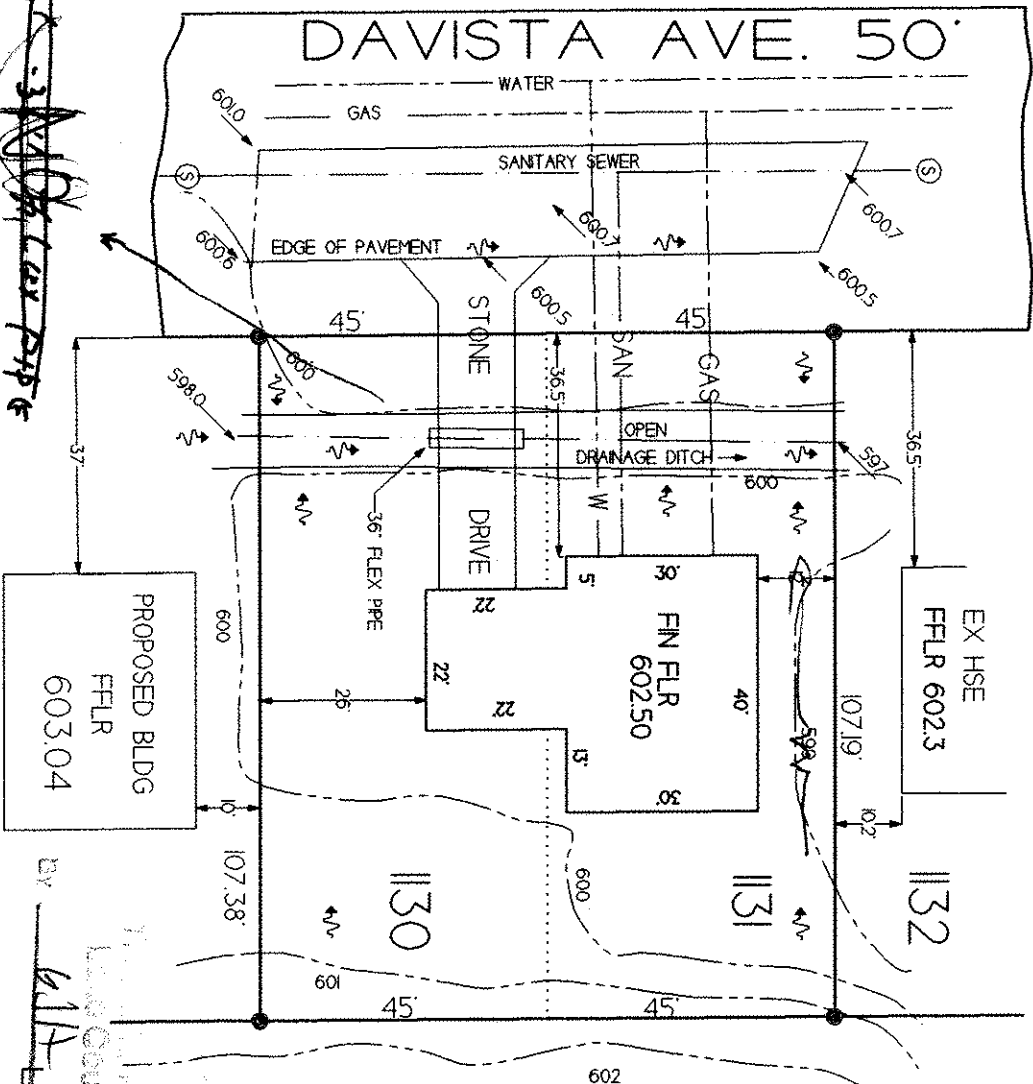


*FEMA Approval Required*

TOWNSHIP OF MADISON  
COUNTY OF LAKE  
STATE OF OHIO  
PLAT VOL. F PAGE 50  
THIS SURVEY WAS PERFORMED TO  
AN ACCURACY SET FORTH IN THE  
OHIO ADMINISTRATIVE CODE  
4733.37 AND ALTA SUBURBAN  
ACCURACY

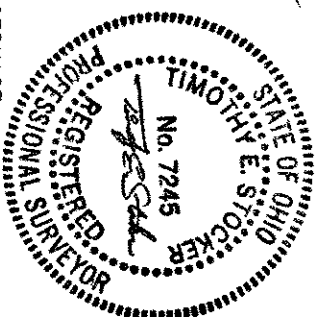

COPYRIGHT 1996 CRABBS' SURVEYING SERVICE  
ORDER AS SAVED 1460PLOT  
AUGUST 1996

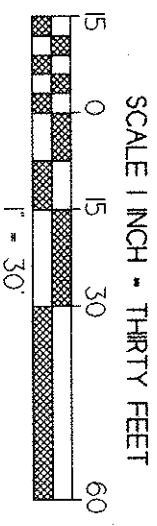

- PK. NAIL WITH SHINER SET
- IRON PIN MONUMENT
- IRON PIPE
- ⊕ MONUMENT BOX
- ⊕ UTILITY POLE
- ↗ RUNOFF DIRECTION