

CRABBS'
SURVEYING
SERVICE

WESTERN RESERVE BUILDING
70 NORTH ST. CLAIR STREET SUITE 300
PANESVILLE, OHIO 44077
PHONE: (261) 357-5941
FAX: (261) 357-8816
1-800-488-3968


72 S. CHESTNUT STREET
JEFFERSON, OHIO 44047
PHONE: (261) 576-3488
FAX: (261) 576-3511

JOB 1460PLOT

SITE PLAN \ TOPO

FOR SUBLOTS 1130 AND 1132 HOLIDAY CONSTRUCTION
1 STORY FRAME DWELLING 1200 SQ FT

PLAT BEARINGS

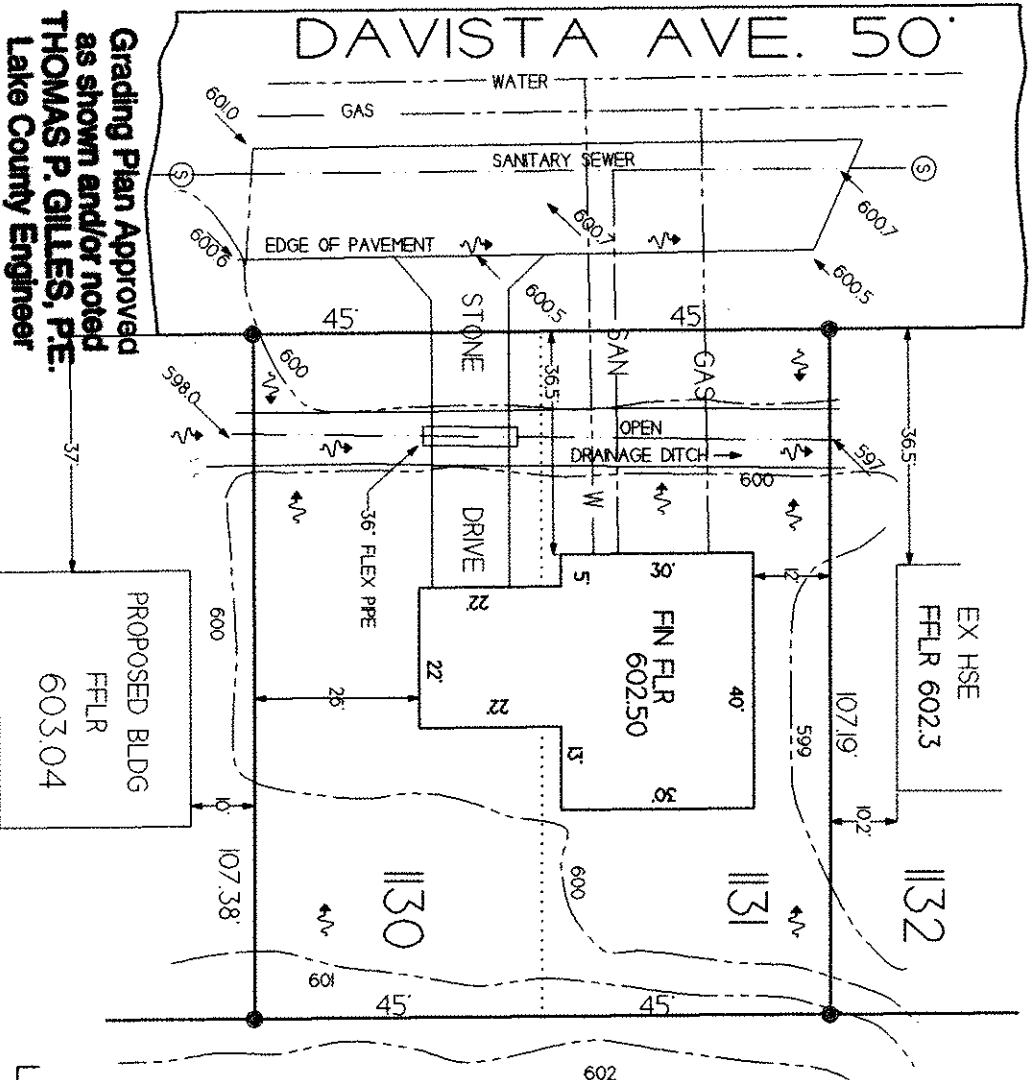


Grading Plan Approved
as shown and/or noted
THOMAS P. GILLES, P.E.
Lake County Engineer

LEGEND


- P.K. NAIL WITH SHANKER SET
- R.O.N. PIN MONUMENT
- R.O.N. P.P.E.
- ⊕ MONUMENT BOX
- ⊕ UTILITY POLE
- ↗ RUNOFF DIRECTION

SCALE 1 INCH = THIRTY FEET

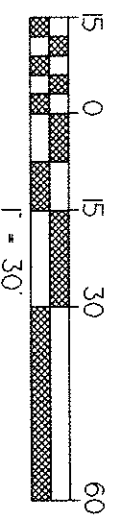

By 6/14 Date 10-4-96

TOWNSHIP OF MADISON
COUNTY OF LAKE
STATE OF OHIO
PLAT VOL. F PAGE 50
THIS SURVEY WAS PERFORMED TO
AN ACCURACY SET FORTH IN THE
OHIO ADMINISTRATIVE CODE
4733.37 AND ALTA SUBURBAN
ACCURACY

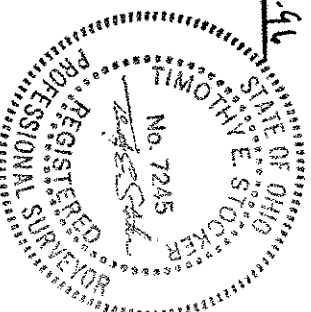

COPYRIGHT 1996 CRABBS' SURVEYING SERVICE
ORDER AS SAVED 1460PLOT
AUGUST 1996