
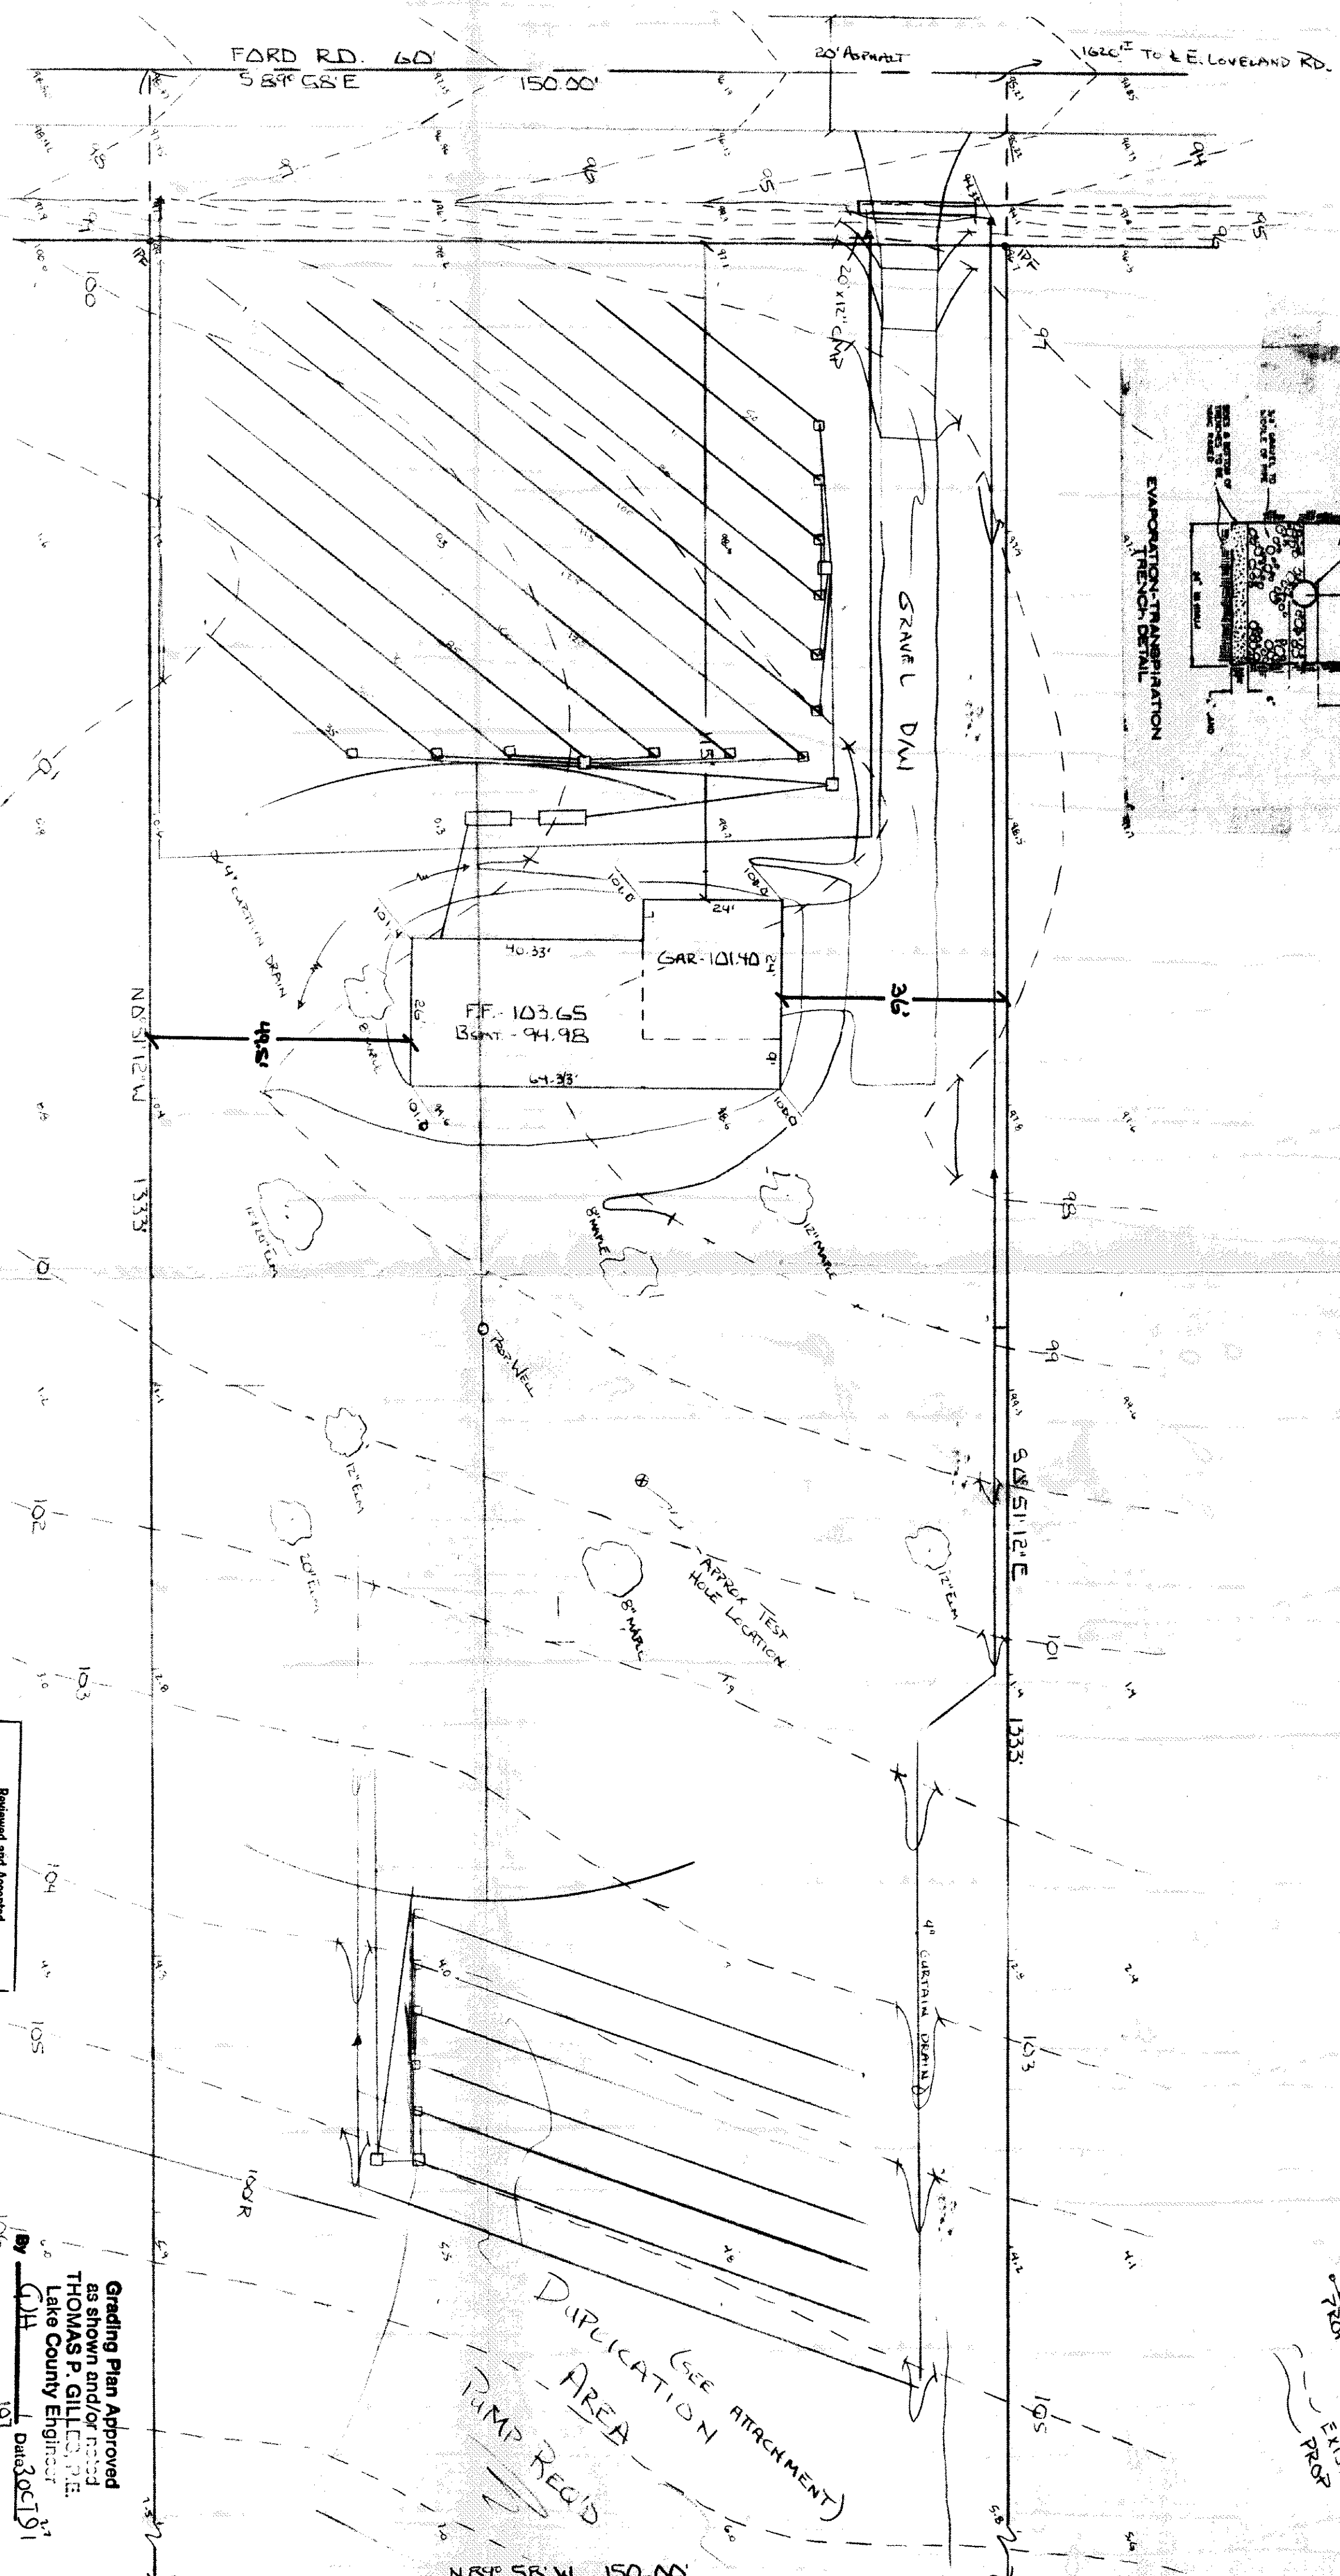


FOR CONSTRUCTION
ANGELORO TRACT, IN THE
TOWNSHIP OF MADISON COUNTY, ILL. CHIC

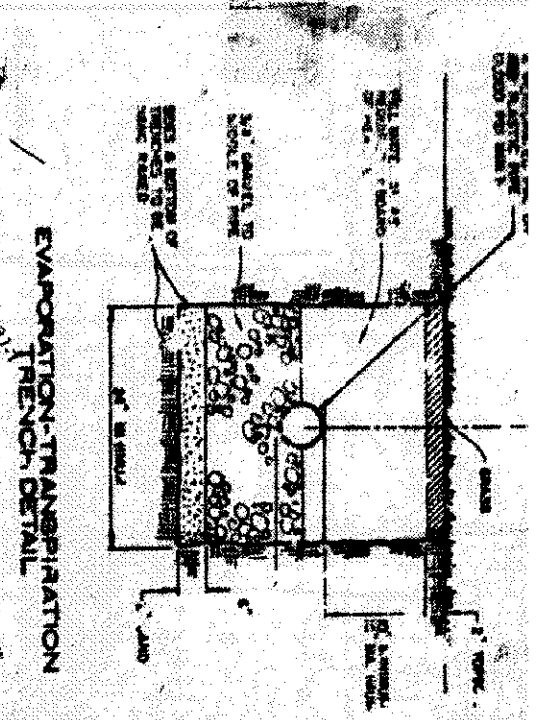

I, the undersigned hereby certify that this topography, indicated by '1' contours, and elevations shown hereon represent an actual field survey made by me on June 24, 1991, and that the elevations were taken at appropriate intervals and that as of that date they existed as indicated hereon.

ANGELORO TRACT
REV. 8-28-91
1-30-91

VILLAGE SURVEYING CO.
202 TOWN ST. FAIRPORT HRS. OHIO 44137
(216) 357-1359

Spring #101309
11/10/91
11/10/91

36 ROOM HOUSE
FF-103.65
GRINDER PUMP
HEAD IN BENT
BENT-94.98

1000 GAL TANK
TANK-98.9
1000 GAL TANK
TANK-98.1

HYDRAULIC PROFILE
HORIZ. 1" = 30' VERT. 1" = 3'


LOW YIELD WATER
FIXTURES REQUIRED
ON ALL:
Shower Head
Toilet

Reviewed and Accepted
LAKE COUNTY GENERAL HEALTH DISTRICT
Date 10/1/91
JOEL LUCIA, R.S., M.P.H.
Health Commissioner
BY N. Nichols

- A. To be brought to finished grade
- 1. Septic tank manhole covers
- 2. Splitter box cover
- 3. Distribution box cover

B. No footer drains or downspouts
to be discharged into septic tanks
C. All waste water to be discharged into
septic tanks

SEWAGE DISPOSAL PERMIT MUST BE
OBTAINED BY A LAKE COUNTY LICENSED
INSTALLER BEFORE INSTALLATION IS
STARTED.

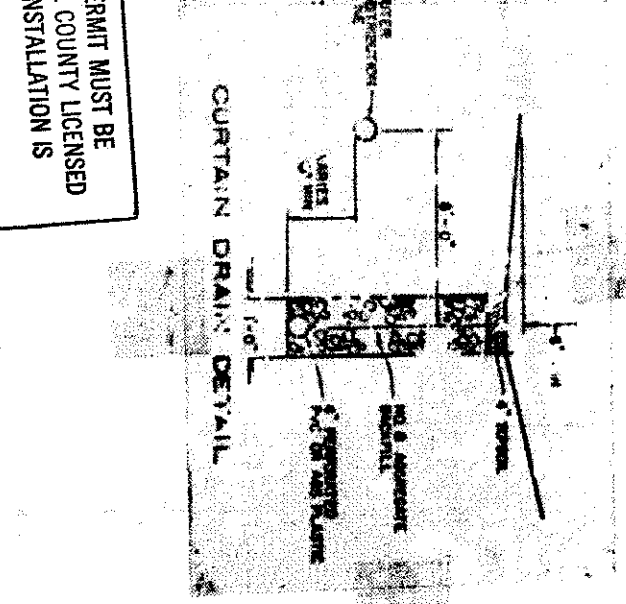

Grading Plan Approved
as shown and/or noted
THOMAS P. GILLES, P.E.
Lake County Engineer
By TGH Date 3/21/91

DUPLICATION (SEE ATTACHMENT)
PUMP REQ'D
AREA

EXIST
PROB