
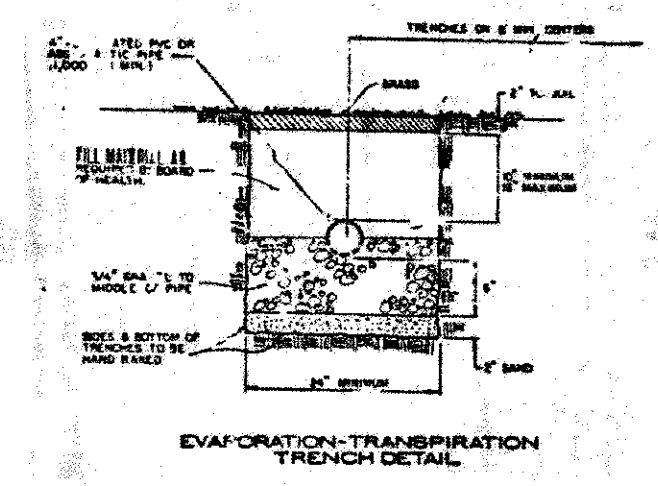


SITE PLAN
FOR
R.C. REED CONST
BEING PART OF LOT 14, TOWNSHIP 14 N.,
RANGE 10 E., COUNTY OF MADISON, STATE OF OHIO

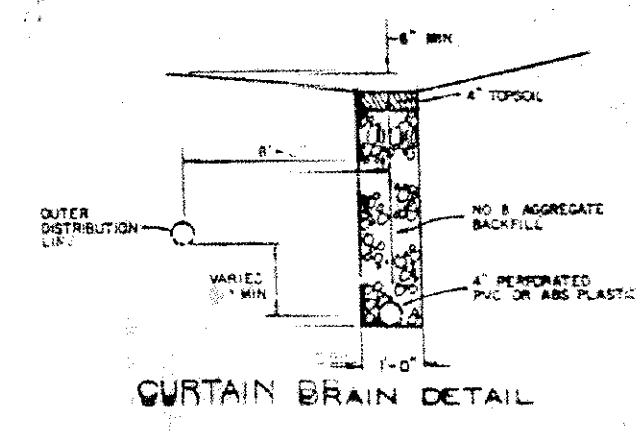

BENCHMARK-100.00 (ASSUMED)
NAIL IN PILE # 3507001

R.M. # J.A. JESSWEIN
Vol 161-1171

ANDREW G. & SANDRA E. BEHM
Vol 101E-155
9.409AC.

Reviewed and Accepted
LAKE COUNTY GENERAL HEALTH DISTRICT
Date 7-20-94
see notes in red
JOEL LUCIA, R.S., M.P.H.
Health Commissioner
BY J. Lucia

Grading Plan Approved
as shown and/or noted
THOMAS P. GILLES, P.E.
Lake County Engineer
By 614 Date 85


- A. To be brought to finished grade
- 1. Septic tank manhole covers
- 2. Splitter box cover
- 3. Distribution box cover
- B. No footer drains or downspouts to be discharged into septic tanks
- C. All waste water to be discharged into septic tanks

SEWAGE DISPOSAL PERMIT MUST BE OBTAINED BY A LAKE COUNTY LICENSED INSTALLER BEFORE INSTALLATION IS STARTED.


LOW YIELD WATER FIXTURES REQUIRED ON ALL:
Shower Head
Toilet

Dist Box Inv 105.4
Dist Box Inv 106.2
Summit Inv 106.4

N 00° 51' 12" W 1333.87
HYDRAULIC PROFILE
VERT 1-5 H 1-41 30
3.000000000

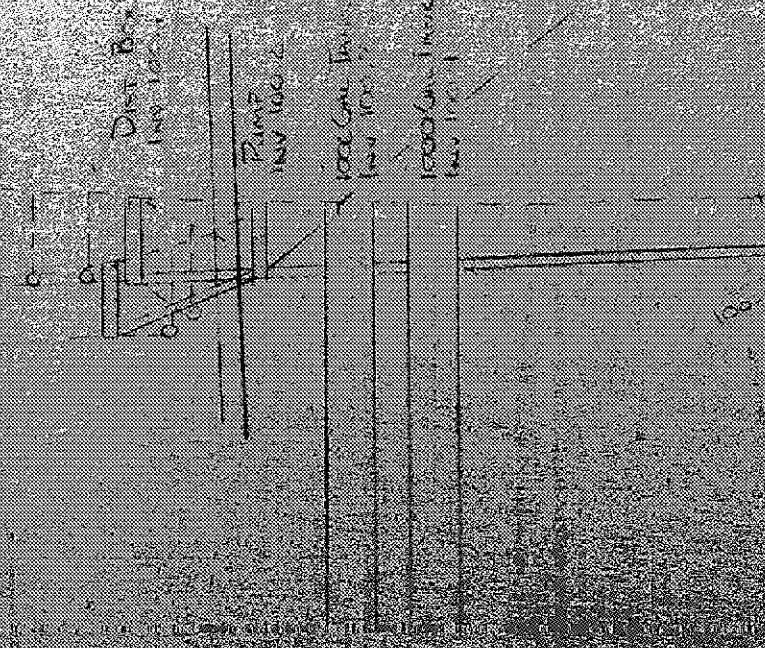

APPROVED
BOSCH TWP ENGINEER
THOMAS P. GILLES, P.E.
Lake County Engineer

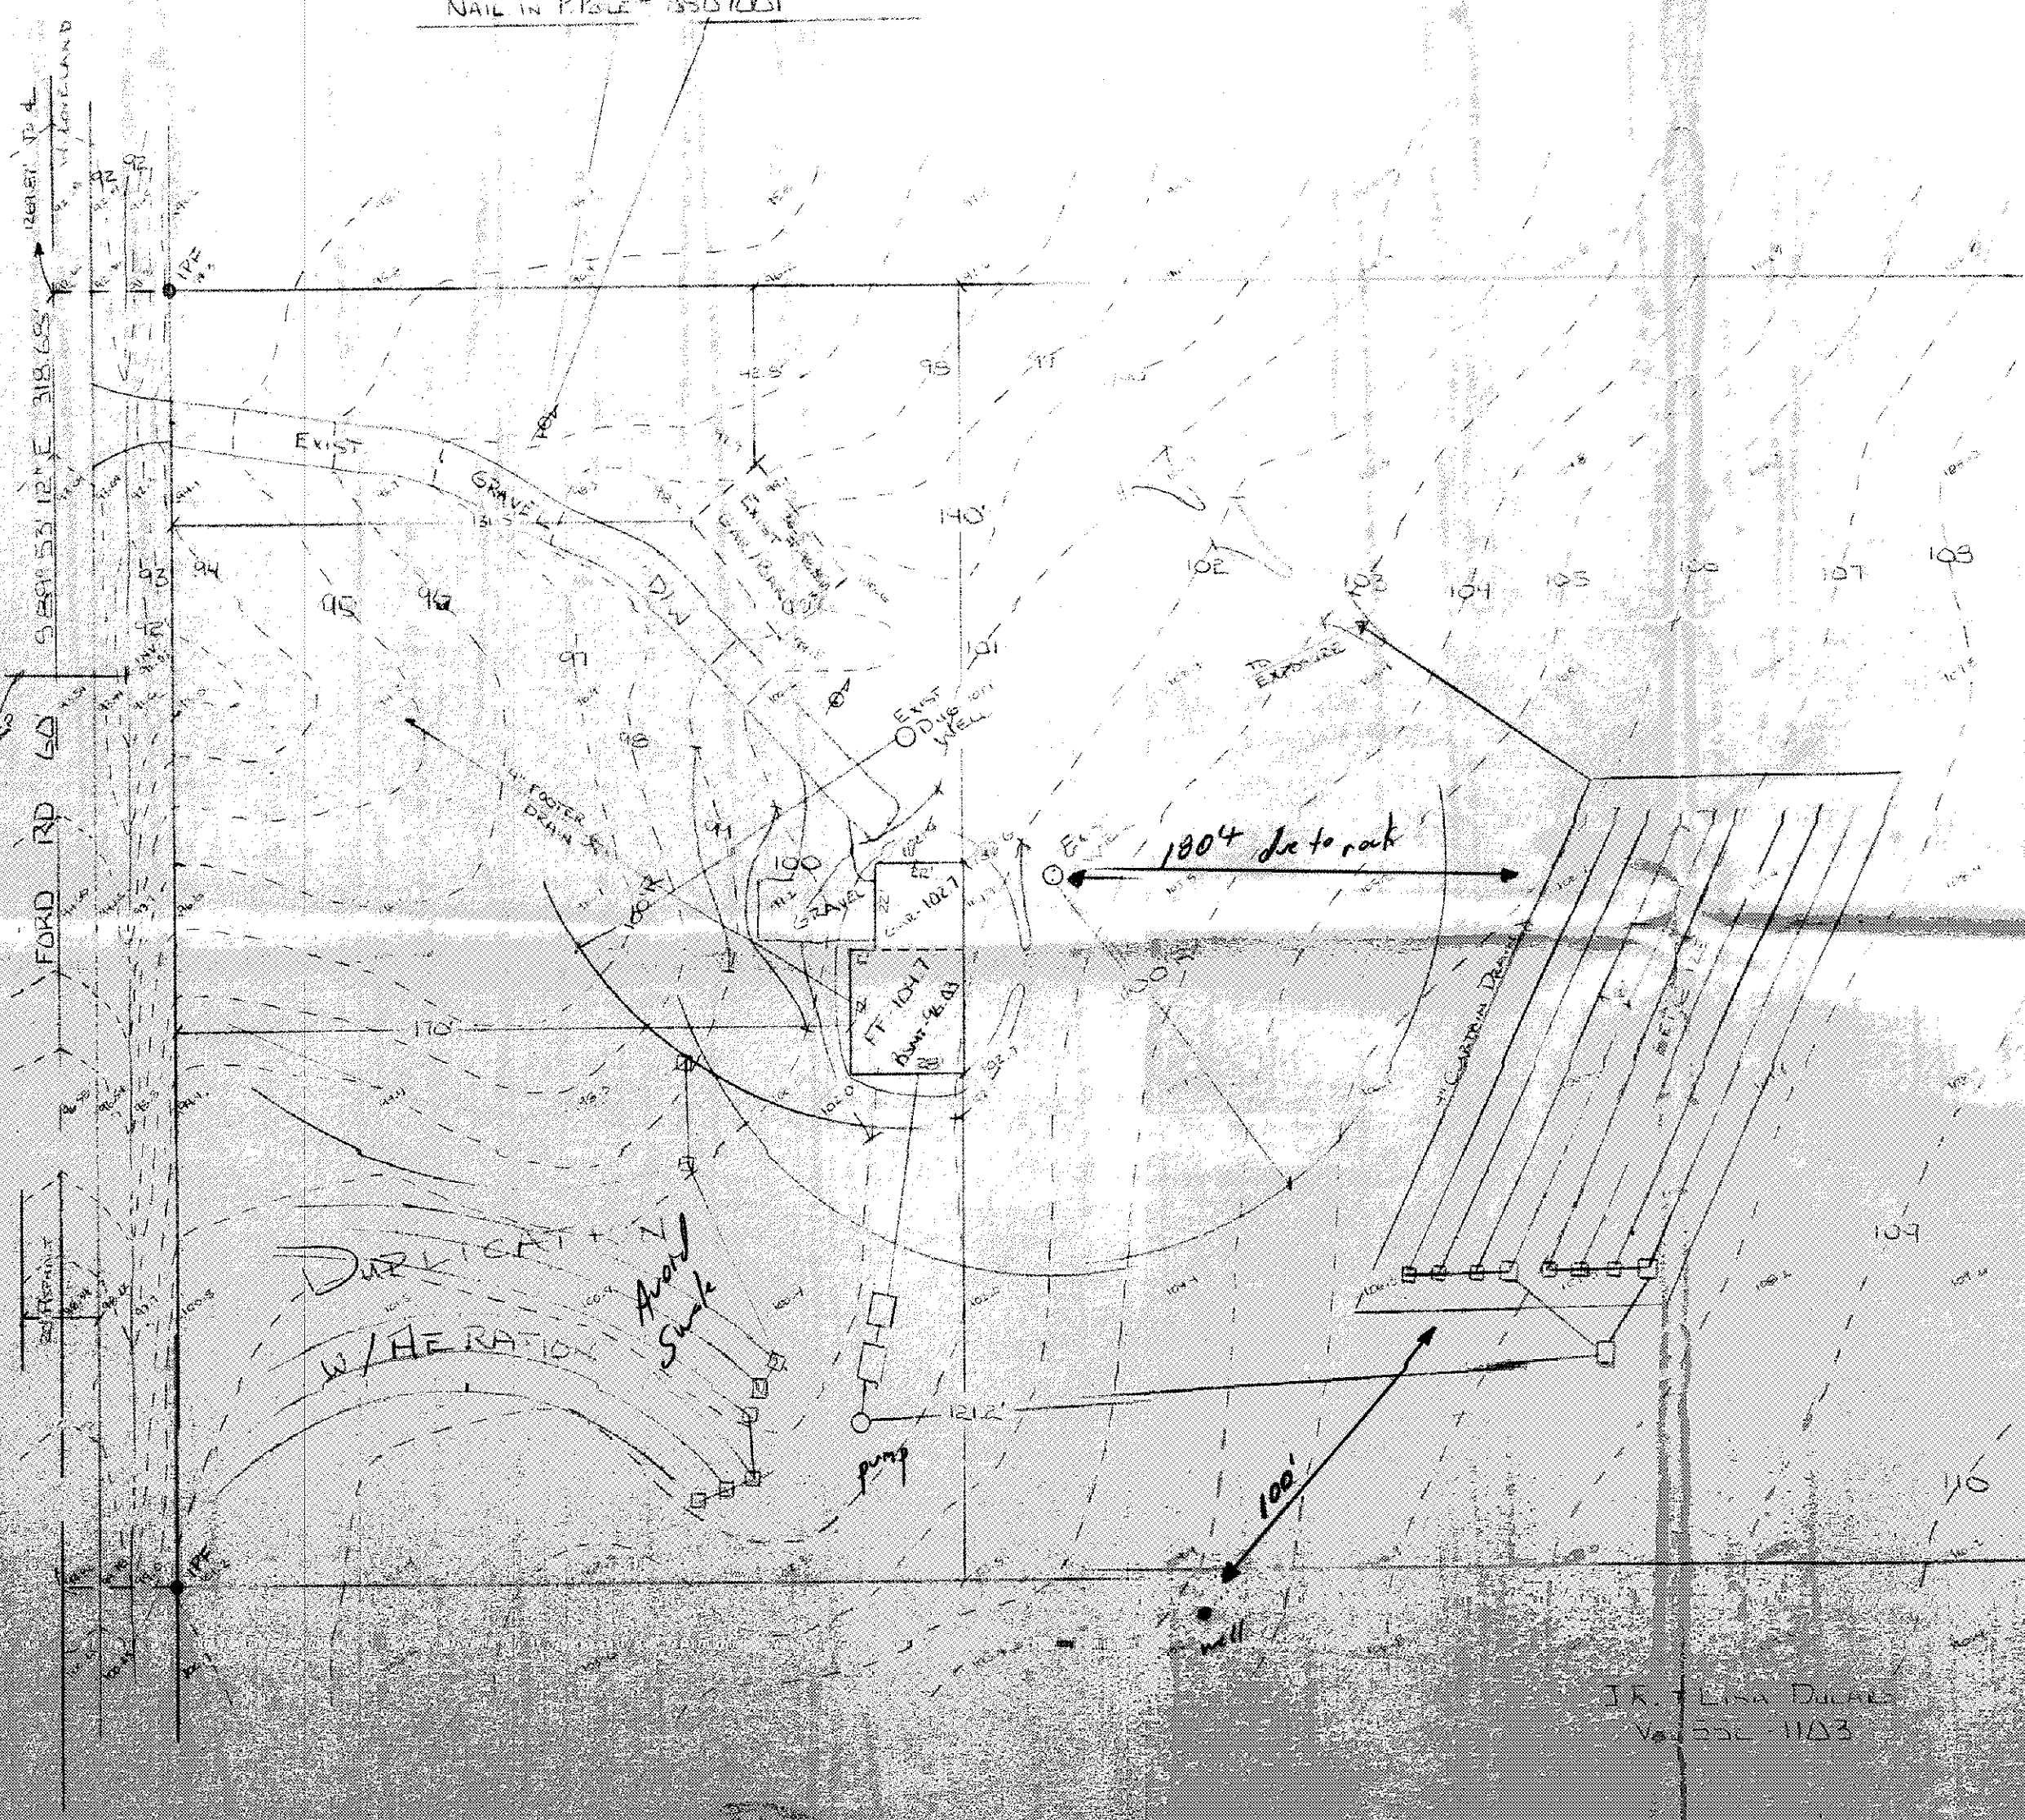

VILLAGE SURVEYING CO
RD Box 1046 Fairport HSE. OH 44131
(416) 351-1389

I, the undersigned, hereby certify that this topography, indicated by 1' contours and elevations shown herein represent an actual field survey made by me on 7-1-94 and that the elevations were taken at appropriate intervals and that as of that date they related as indicated herein.