


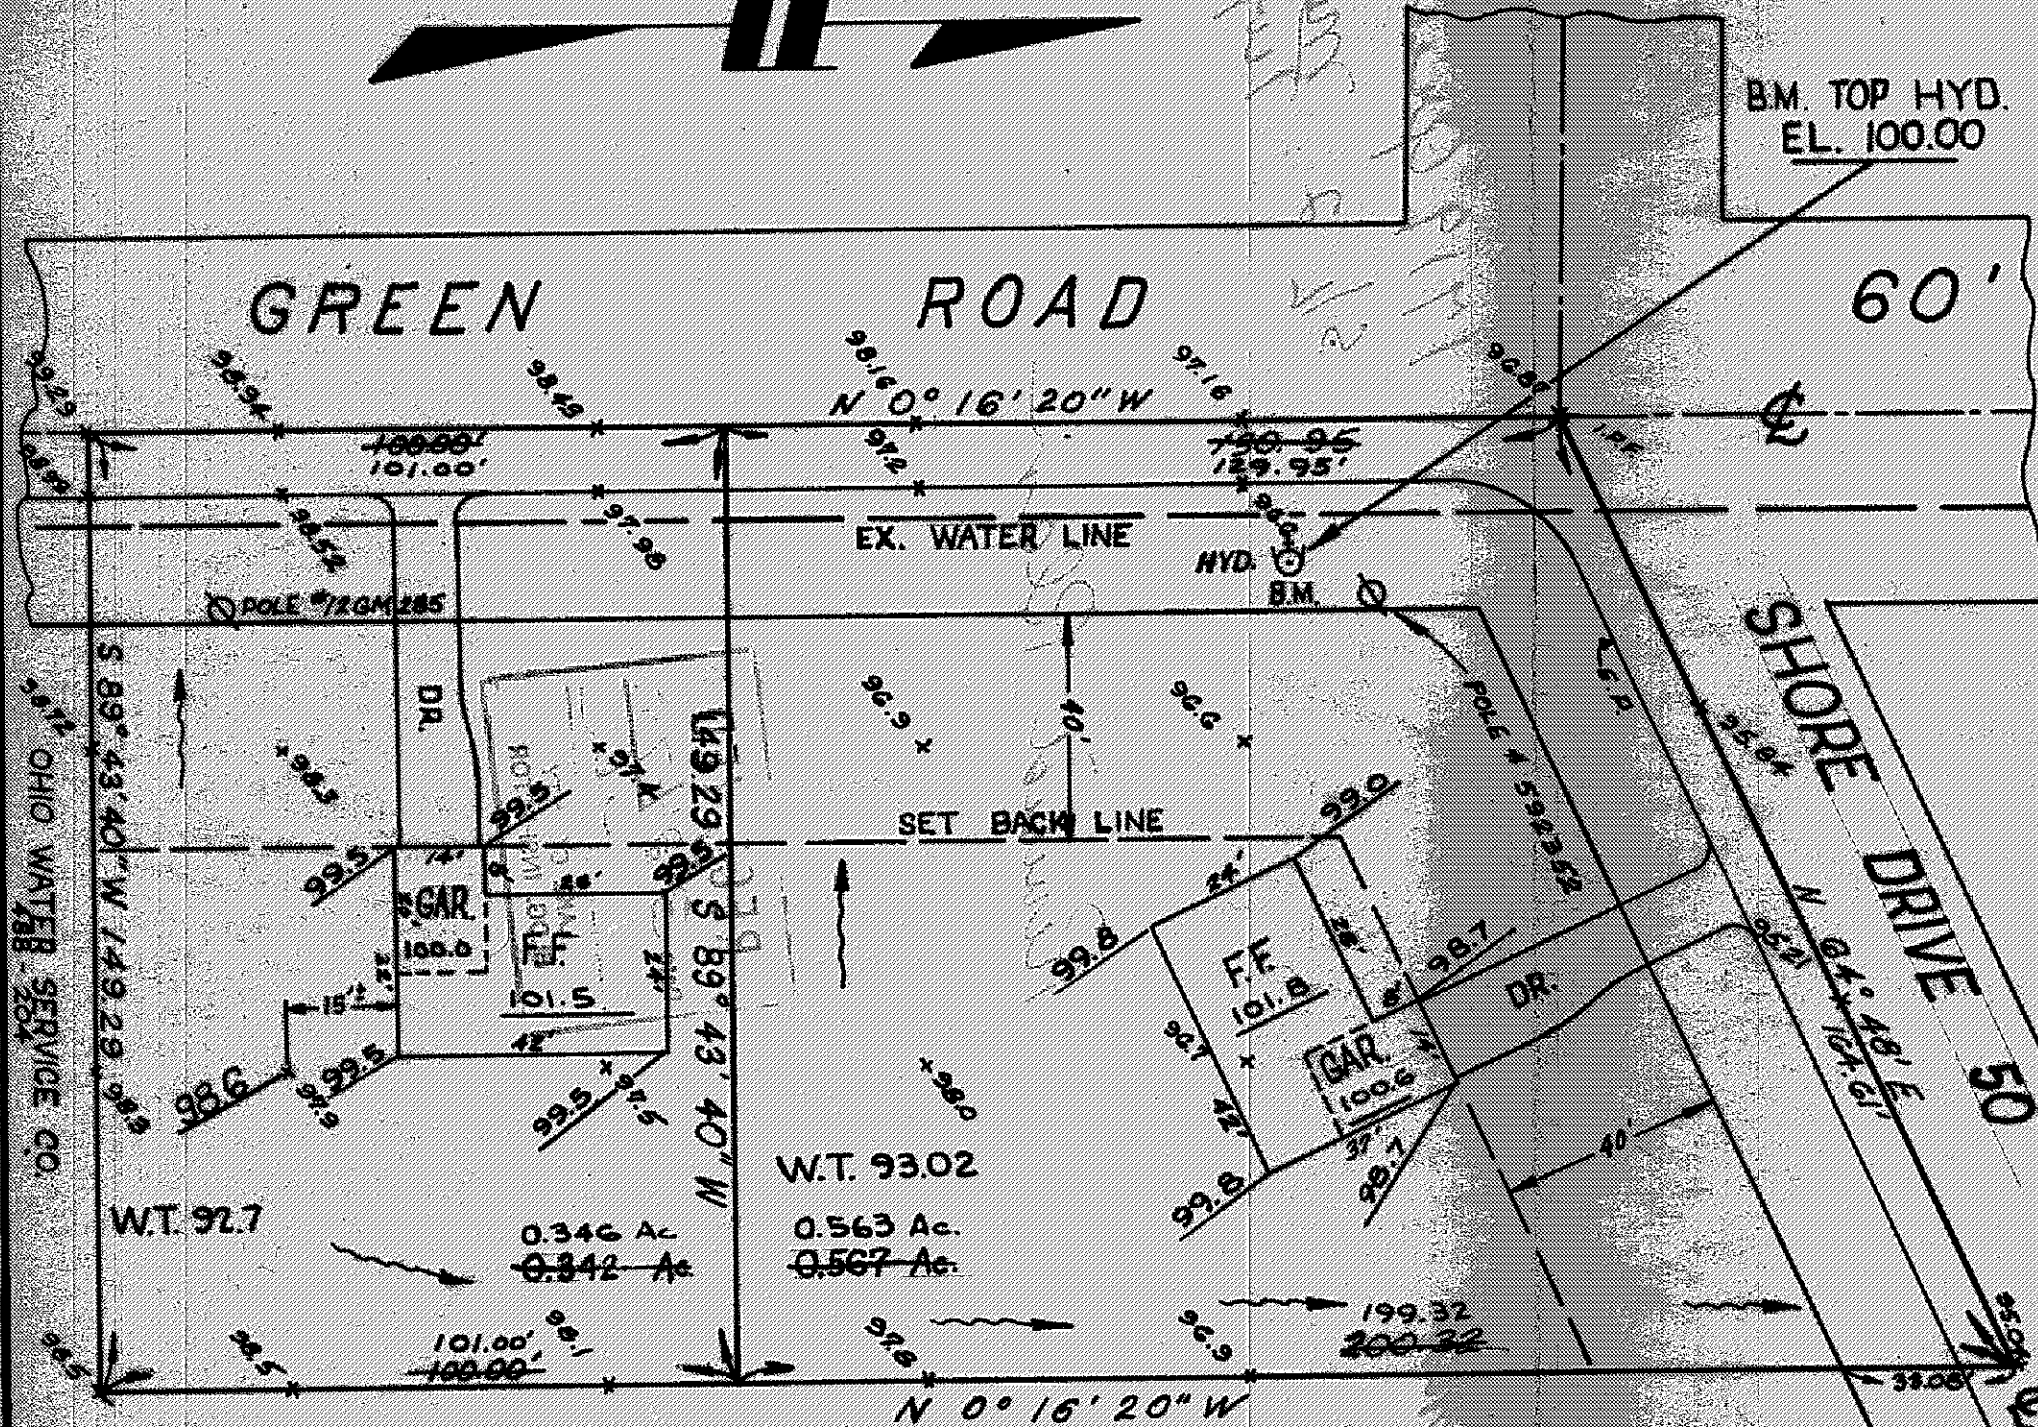

SITE PLAN

MADISON TWP. LAKE COUNTY, OHIO
FOR GINGER HOMES INC.
PO. BOX 537 MENTOR 44060
ADDRESS STREET CITY ZIP

SUBDIVISION	NAME	LOT	TRACT
	VOL. PG. GREEN RD.		
SUB LOT NO.	STREET	VOLUME	PAGE
		PERM PARCEL	STREET

LEGEND	
SANITARY MANHOLE	●
STORM MANHOLE	○
INLET OR CATCH BASIN	⊙
HYDRANT	⊕
EXISTING CONTOURS	---
PROPOSED CONTOURS	---
EXIST. ELEV.	100.0
PROPELEV.	100.0
WATER VALVE (GAS)	⊗
WATER METER (GAS)	⊞
AS BUILT ELEVATION	100.0
INDICATES DIRECTION OF SURFACE DRAINAGE	

DESIGN CERTIFICATION
THIS PLAT WAS PREPARED BY ME, AND IS CORRECT TO THE BEST OF MY KNOWLEDGE AND BELIEF

REGISTERED SURVEYOR NO.

CHECK LIST	
DIMENSIONS	WATER MAIN SIZE LOCATION
BEARING	SAN SEWER SIZE % GR LOC
TIE TO NEAREST STREET	SAN MH CAST ELEV INV ELEV
SUBLOT NO. PARCEL NO.	SAN CONN SIZE LOC DEPTH
SURROUNDING OWNERS	STORM SEWER SIZE % GR LOC
BLDG DIMENSION FIN GR.	STORM MH CAST ELEV INV ELEV
BLDG TIES FLR GRADES	PAVT TYPE GRADE CURBS
APRON TYPE WIDTH THICKNESS	GASLINE LOC SIZE PRESSURE
SIDEWALK TYPE WIDTH THICKNESS	SEPTIC TANK SIZE LOC
CULVERT TYPE DIA LENGTH	WELL LOCATION

PLAN PREPARED
COLPETZER WOODS CONSULTANTS INC.
CONSULTING ENGINEERS & SURVEYORS
180 S. STATE STREET
PAINESVILLE, OHIO 44077
TEL: 357-7569

REVISIONS			DRAWN BY	SCALE	DRAWING NUMBER
NO	DATE	BY			
1			CHK'D	DATE	
2			CREW	FEB 75	
			CHIEF	APPD	

Revised Grading Plan Approved as shown and/or noted
WILLIAM E. & MARY RABE
V G26-413
Revised Lot Dimensions as per
Gottwig 3-14-75
Date 3-24-75 "AS BUILT" CERTIFICATION
I HEREBY CERTIFY THAT THE CIRCLED GRADES ARE EXISTING FINISH
GRADES CHECKED IN FIELD ON 19
SURVEY IS CORRECT TO THE BEST OF MY KNOWLEDGE AND BELIEF
FB #237 REGISTERED SURVEYOR NO.