

Grading Plan Approved
as shown and/or noted
THOMAS P. GILLES, P.E.
Lake County Engineer

SITE PLAN

FOR


BILL BARBIS

By 614 Date 3/17/93 BEING SUBLOT NO 327, MADISON-

LAKELAND SUBD., TOWNSHIP OF
MADISON, LAKE COUNTY, OHIO.


MARVIN & GOLDIE HOFFMAN

VOL 177-1256

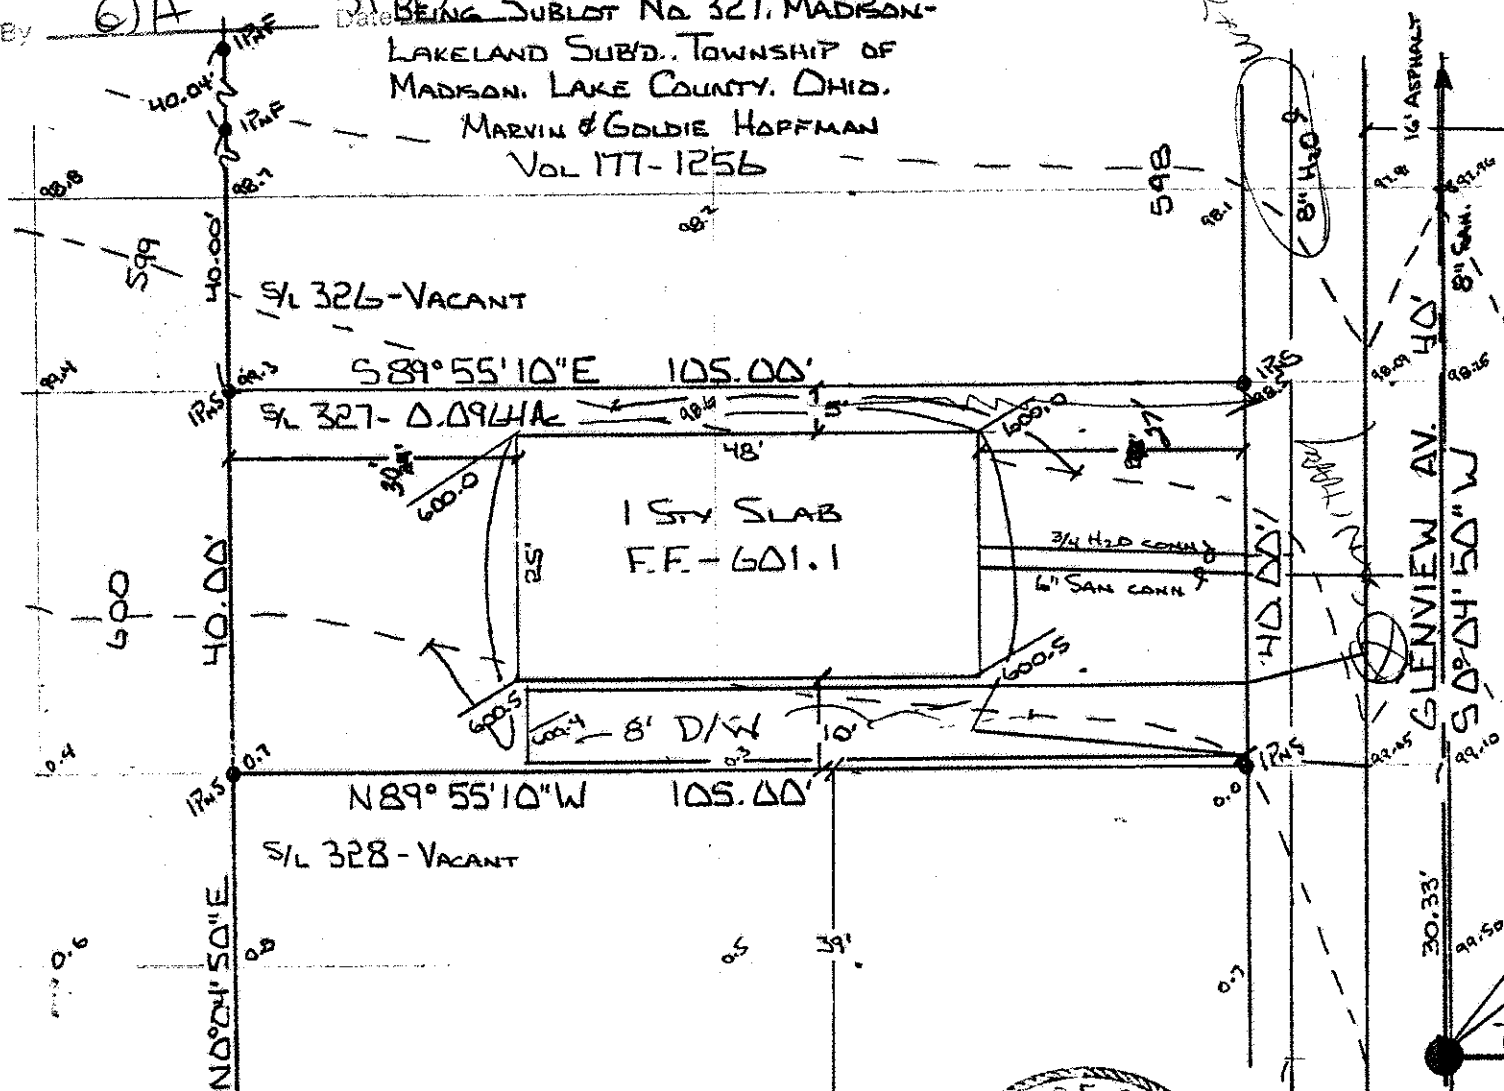


ADDRESS	SETBACK
S/L 328	37'
" 326	30'
" 325	21'
799	28.3' (25.3' TO PORCH)
777	21.3'
774	23'

F.F.-601.74

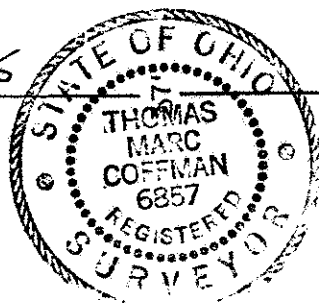

MARCH 2, 1993

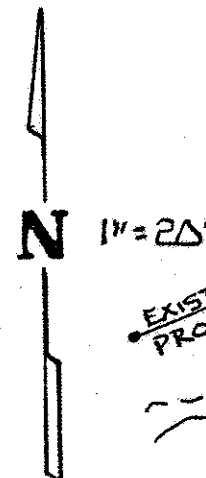

APPROVED
MADISON TWP. ZONING

Permit 13699

Zoning Inspector: chl

MAR 05 1993

BENCHMARK-599.72
N. RIM SAN M.H.: INV. 539.85

TARBELL AVE 40'
8" SAN

I, the undersigned hereby certify that this topography, indicated by 1' contours, and elevations shown hereon represent an actual field survey made by me on FEB. 4, 1993 and that the elevations were taken at appropriate intervals and that as of that

J.M. Coffman P.S.