


GREEN ROAD

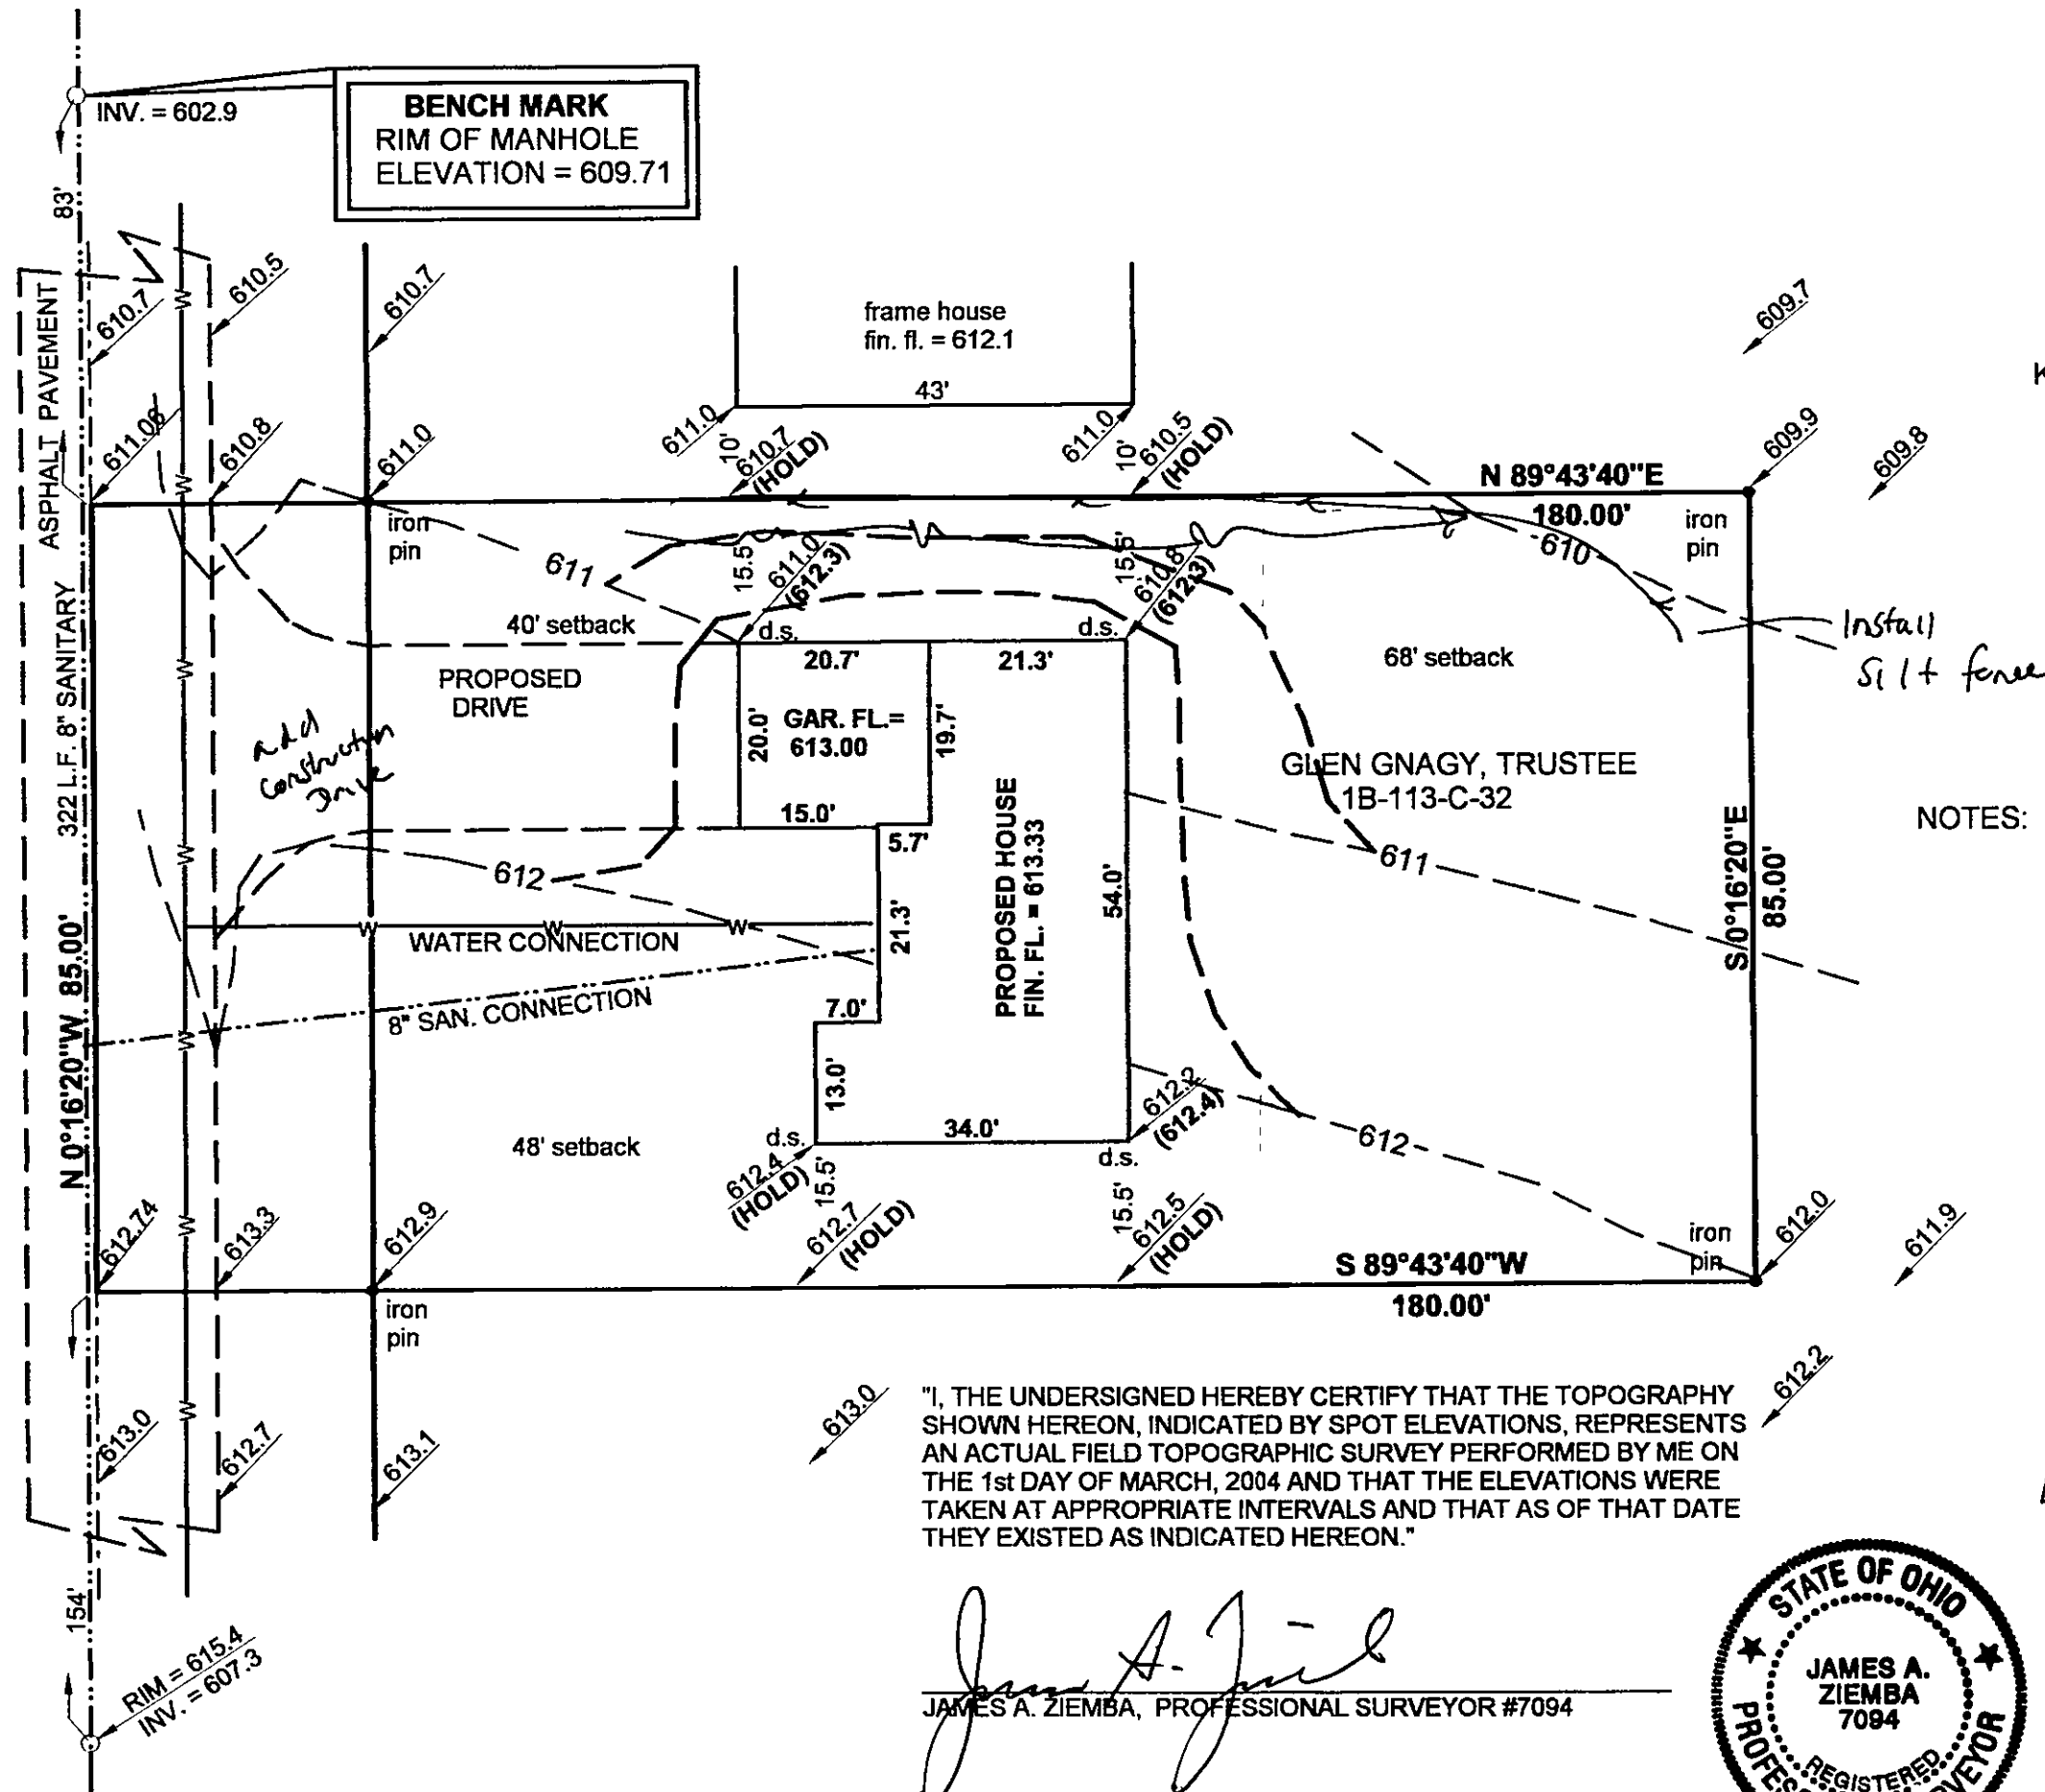

SITE PLAN
FOR
A.B.C. BUILDERS

KNOWN AS BEING PART OF LOT 1, TRACT 3
IN RANGE 6, TOWNSHIP 12 OF THE
CONNECTICUT WESTERN RESERVE

TOWNSHIP OF MADISON
COUNTY OF LAKE STATE OF OHIO

This project is exempt from
ESC Plan Review
Date 3-9-04
Lake SWCD pyh


NOTES: WATER AND SEWER CONNECTIONS ARE TO
BE VERIFIED AT TIME OF CONSTRUCTION.

d.s. = DOWNSPOUTS WITH SPLASHBLOCKS.

Stormwater Management Plan
Approved as shown and/or noted
JAMES R. GILLS, P.E.
County Drainage Engineer

By 614 Date 03/11/04

See attached ESC plans.

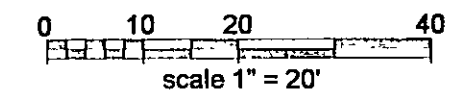

BENCHMARK SURVEY COMPANY
5964 SOUTH RIDGE ROAD
MADISON, OHIO 44057
MARCH 2, 2004
1-440-428-8599

APPROVED
MADISON TOWNSHIP ZONING

DATE 3/8/04

BY Mr 21701

"I, THE UNDERSIGNED HEREBY CERTIFY THAT THE TOPOGRAPHY
SHOWN HEREON, INDICATED BY SPOT ELEVATIONS, REPRESENTS
AN ACTUAL FIELD TOPOGRAPHIC SURVEY PERFORMED BY ME ON
THE 1st DAY OF MARCH, 2004 AND THAT THE ELEVATIONS WERE
TAKEN AT APPROPRIATE INTERVALS AND THAT AS OF THAT DATE
THEY EXISTED AS INDICATED HEREON."

James A. Ziemba
JAMES A. ZIEMBA, PROFESSIONAL SURVEYOR #7094

