

TOPOGRAPHICAL SURVEY

BUD HOPKINS

KNOWN AS BEING SUBLOT NUMBERS 448 AND 449 IN THE MADISON GOLF LAKELANDS ALLOTMENT RECORDED IN VOLUME E, PAGE 71 OF THE LAKE COUNTY RECORDED PLATS, NOW IN THE: TOWNSHIP OF MADISON COUNTY OF LAKE - STATE OF OHIO

APPROVED
MADISON TOWNSHIP ZONING
JUN 4 1997

PERMIT # 15396
ZONING INSPECTOR JPA

SEWER AND WATER CONNECTIONS TO BE VERIFIED AT TIME OF CONSTRUCTION.


PREPARED BY:
BENCHMARK SURVEY CO.
5964 S. RIDGE RD.
MADISON, OHIO 44057
428-8599

0' 10' 20' 40'
SCALE 1"=20'



BEARINGS SHOWN HEREON ARE TO AN ASSUMED MERIDIAN AND ARE USED TO DENOTE ANGLES ONLY. DISTANCES ARE GIVEN IN FEET AND DECIMAL PARTS THEREOF, ALL OF WHICH ARE CORRECT.

James H. Ziemba
JAMES H. ZIEMBA P.S. #7094

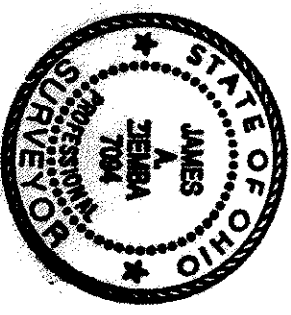

Grading Plan Approved as shown and/or noted
THOMAS P. GILLES, P.E.
Lake County Engineer

Date 6-6-97

Lower north finish
Grade to 97.0
H.N. 1836
1 STR.
FEM. DWG.

