


I, the undersigned hereby certify that the boundary survey represented by this plat and that all monumentation set has been done in accordance with the specifications set forth in Chapter 4733-37 of the Ohio Administrative Code.

I, further certify that the topography, indicated by 1 foot contours and elevations shown hereon represent an actual field survey made by me on March 16, 2002 and the elevations were taken at the appropriate intervals and that as of that date they existed as indicated hereon.

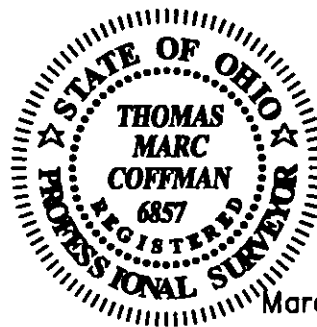

March 21, 2002

SITE PLAN FOR GLENN GNAGY

Being Split No. 5 of the Irma & Leslie Gnagy Green Road Lot Split, of part of Lot No. 1, Tract No. 3, in the Township of Madison, Lake County, Ohio.

D. A. AYERS
Vol. 1122 - Page 1185



SCALE IN FEET

Prop.
Exist.

Prop.
Exist.

IRMA & LESLIE GNAGY
Vol. 397 - Page 371

APPROVED
MADISON TOWNSHIP ZONING

DATE 3/28/02

BY UHL 20810


NOTES:

- 1) Sanitary lateral 8.5' deep & 26' off main per plan.
- 2) Downspouts to splashblocks.

Grading Plan Approved
as shown and/or noted
JAMES R. GILLS, P.E.
Lake County Engineer

By GH Date 3/28/02
as noted

BENCHMARK - 630.00: INV. 615.81
N. RIM SAN. MH C/L DOUGLAS

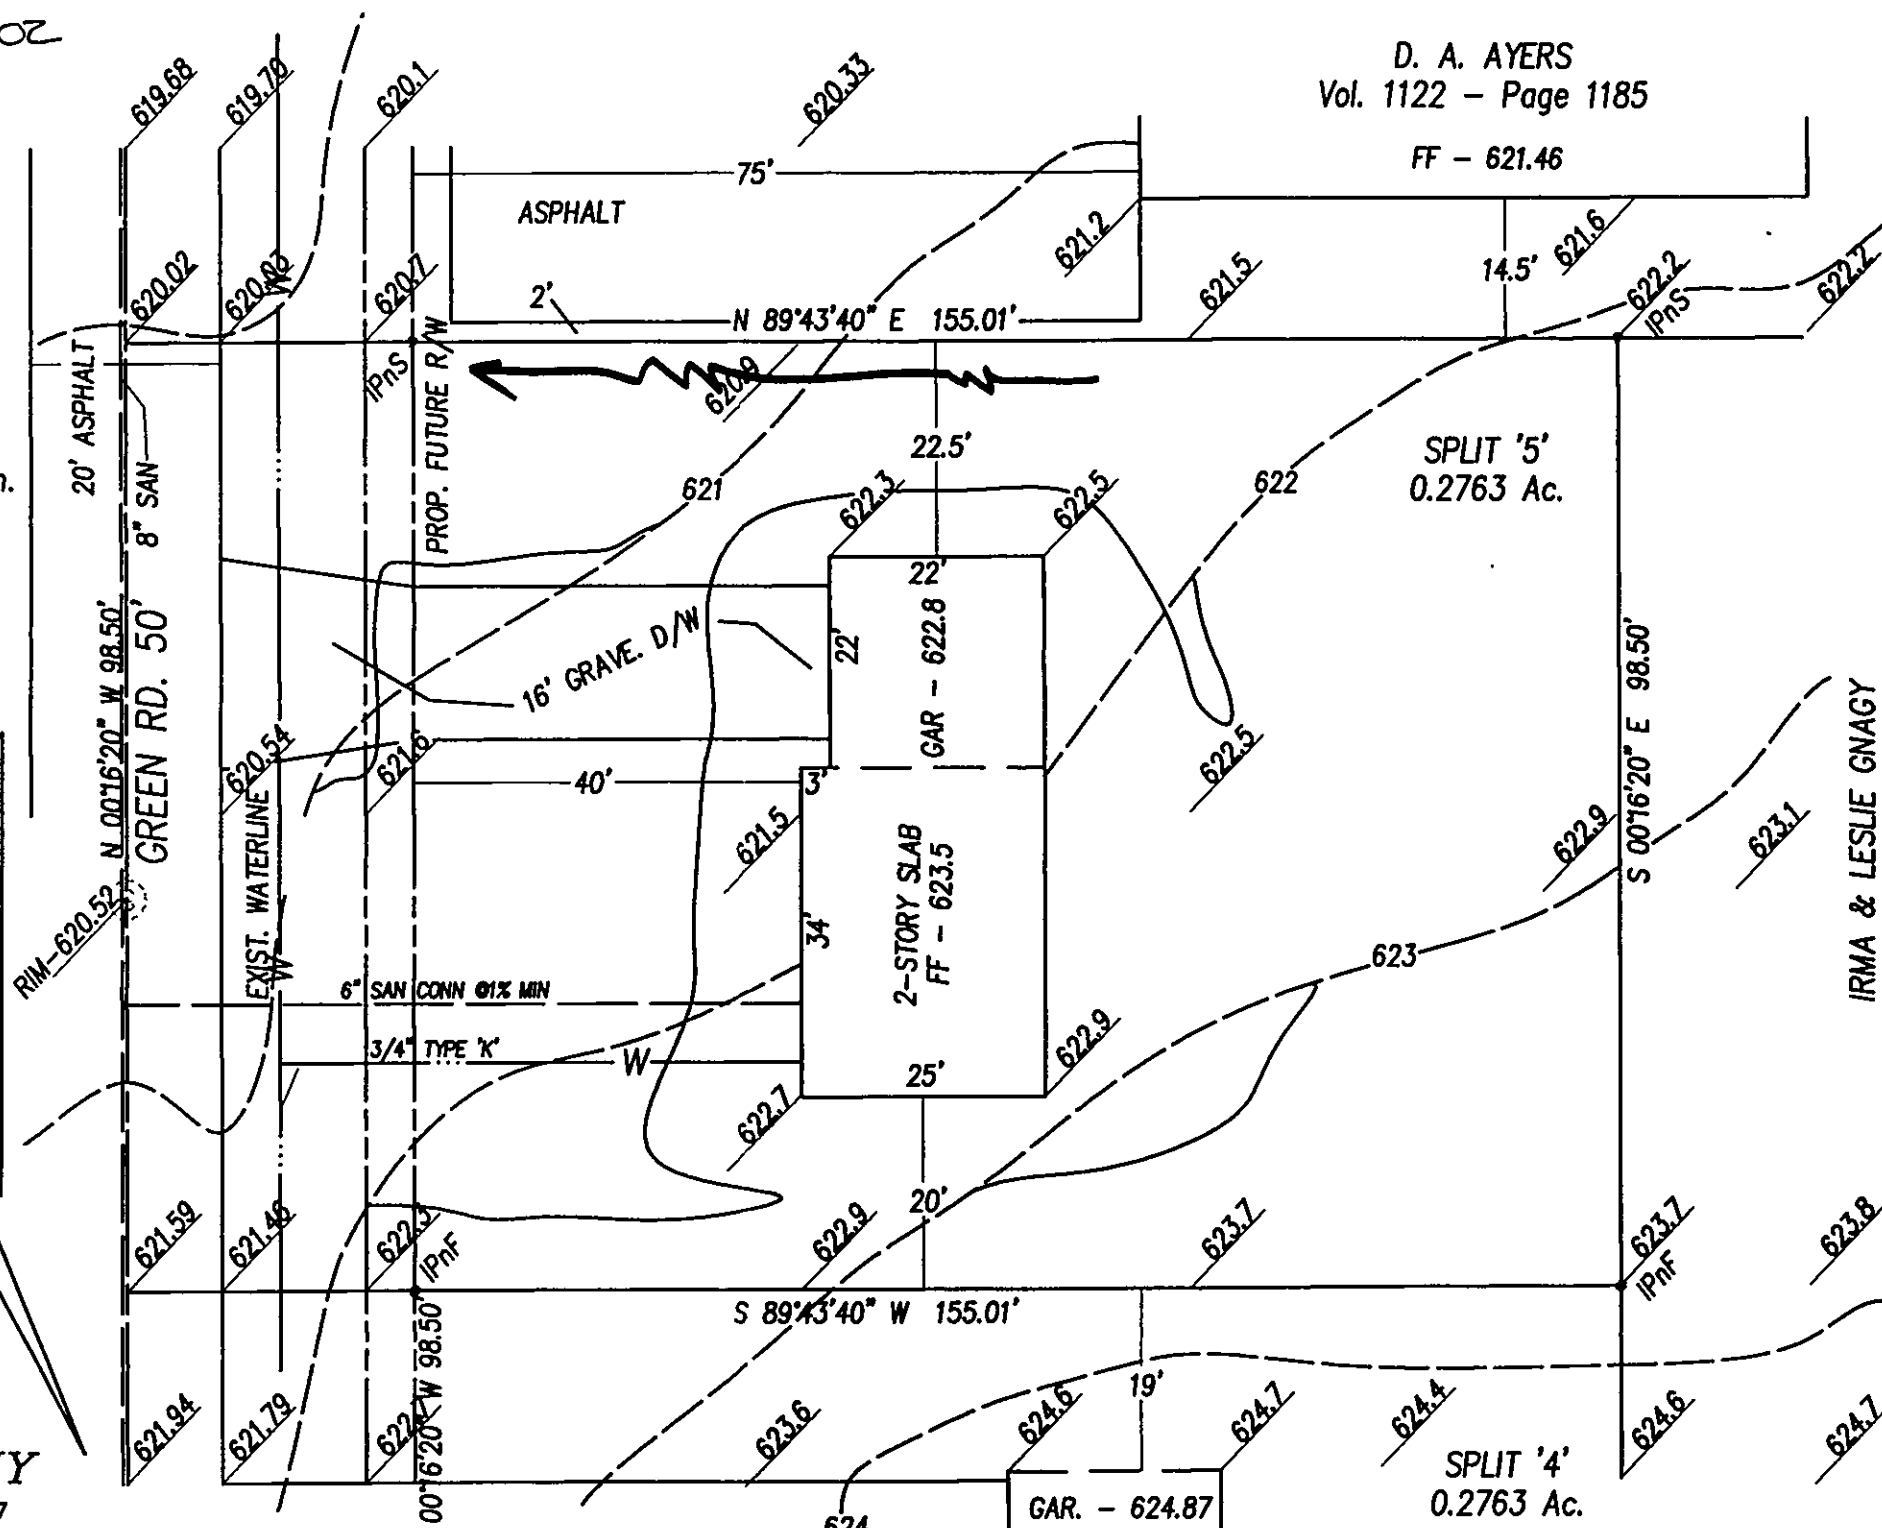

VILLAGE SURVEYING COMPANY

605 VILLA EAST DR., FAIRPORT HARBOR, OH 44077

(440) 357-1359 - CELL (440) 413-0527