


"AS BUILT" CERTIFICATION  
I, HELEN COLTUP, THAT THE CIRCLED  
GRADES ARE EXISTING FINISH  
GRADES CHECKED IN 1980 ON  
19 BY SURVEYING AND  
ARE CORRECT TO THE BEST OF MY  
KNOWLEDGE AND BELIEF.


REGISTERED SURVEYOR #

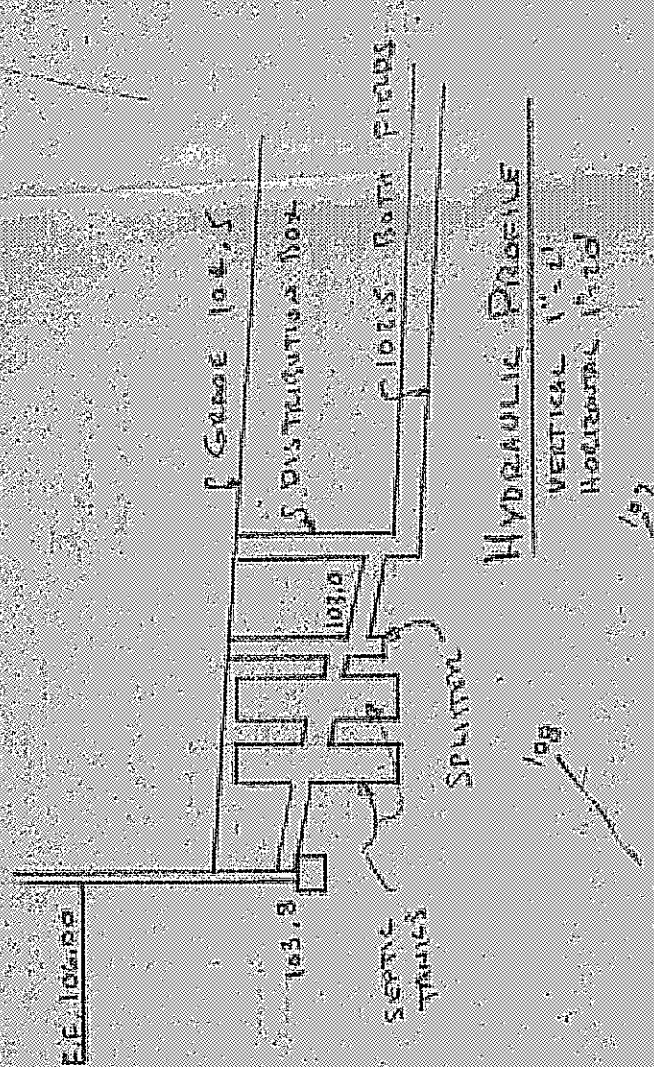

APPROVED  
MADISON TWP. ZONING

Permit: 10167

Zoning Inspector: *[Signature]*

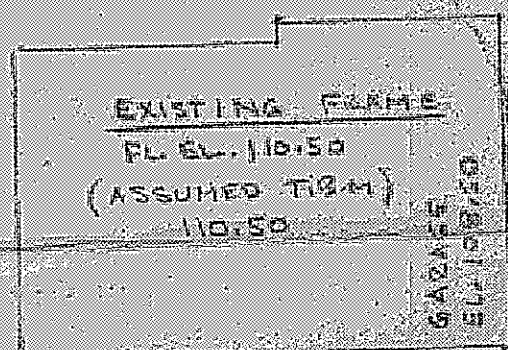

HOUSE NUMBER  
2756 HAINES


Grading Plan Approved  
"as shown and/or noted"  
THOMAS P. GILLES, P.E.  
Lake County Engineer  
By *[Signature]* Date 12 Jun 78

# TOPOGRAPHIC PLAN FOR HAROLD LYNN

SITUATED IN THE TOWNSHIP OF  
MADISON, COUNTY OF LAKE AND  
STATE OF OHIO AND KNOWN AS  
BEING PART OF LOT 3, TRACT 4  
IN SAID TOWNSHIP.  
MAY 1978 SCALE 1" = 20'

THIS PLAN WAS PREPARED BY ME, AND IS CORRECT  
TO THE BEST OF MY KNOWLEDGE AND BELIEF.

*[Signature]*  
REGISTERED SURVEYOR # 5661

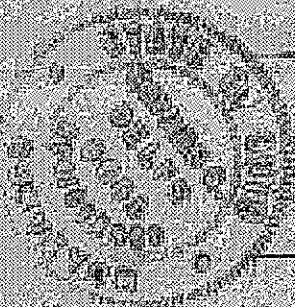

EXISTING GRADE  
PROPOSED GRADE

HAINES ROAD

632.50' TO E. HORTHBIDGE RD. (RTE. 20)

MACADAM ROAD

100.00  
N 2°-30' E

