


Grading Plan Approved
 as shown and/or noted
 THOMAS P. GILLES, P.E.
 Lake County Engineer

By *J.W.R.* Date 8-22-73

BYRON ROAD GO'

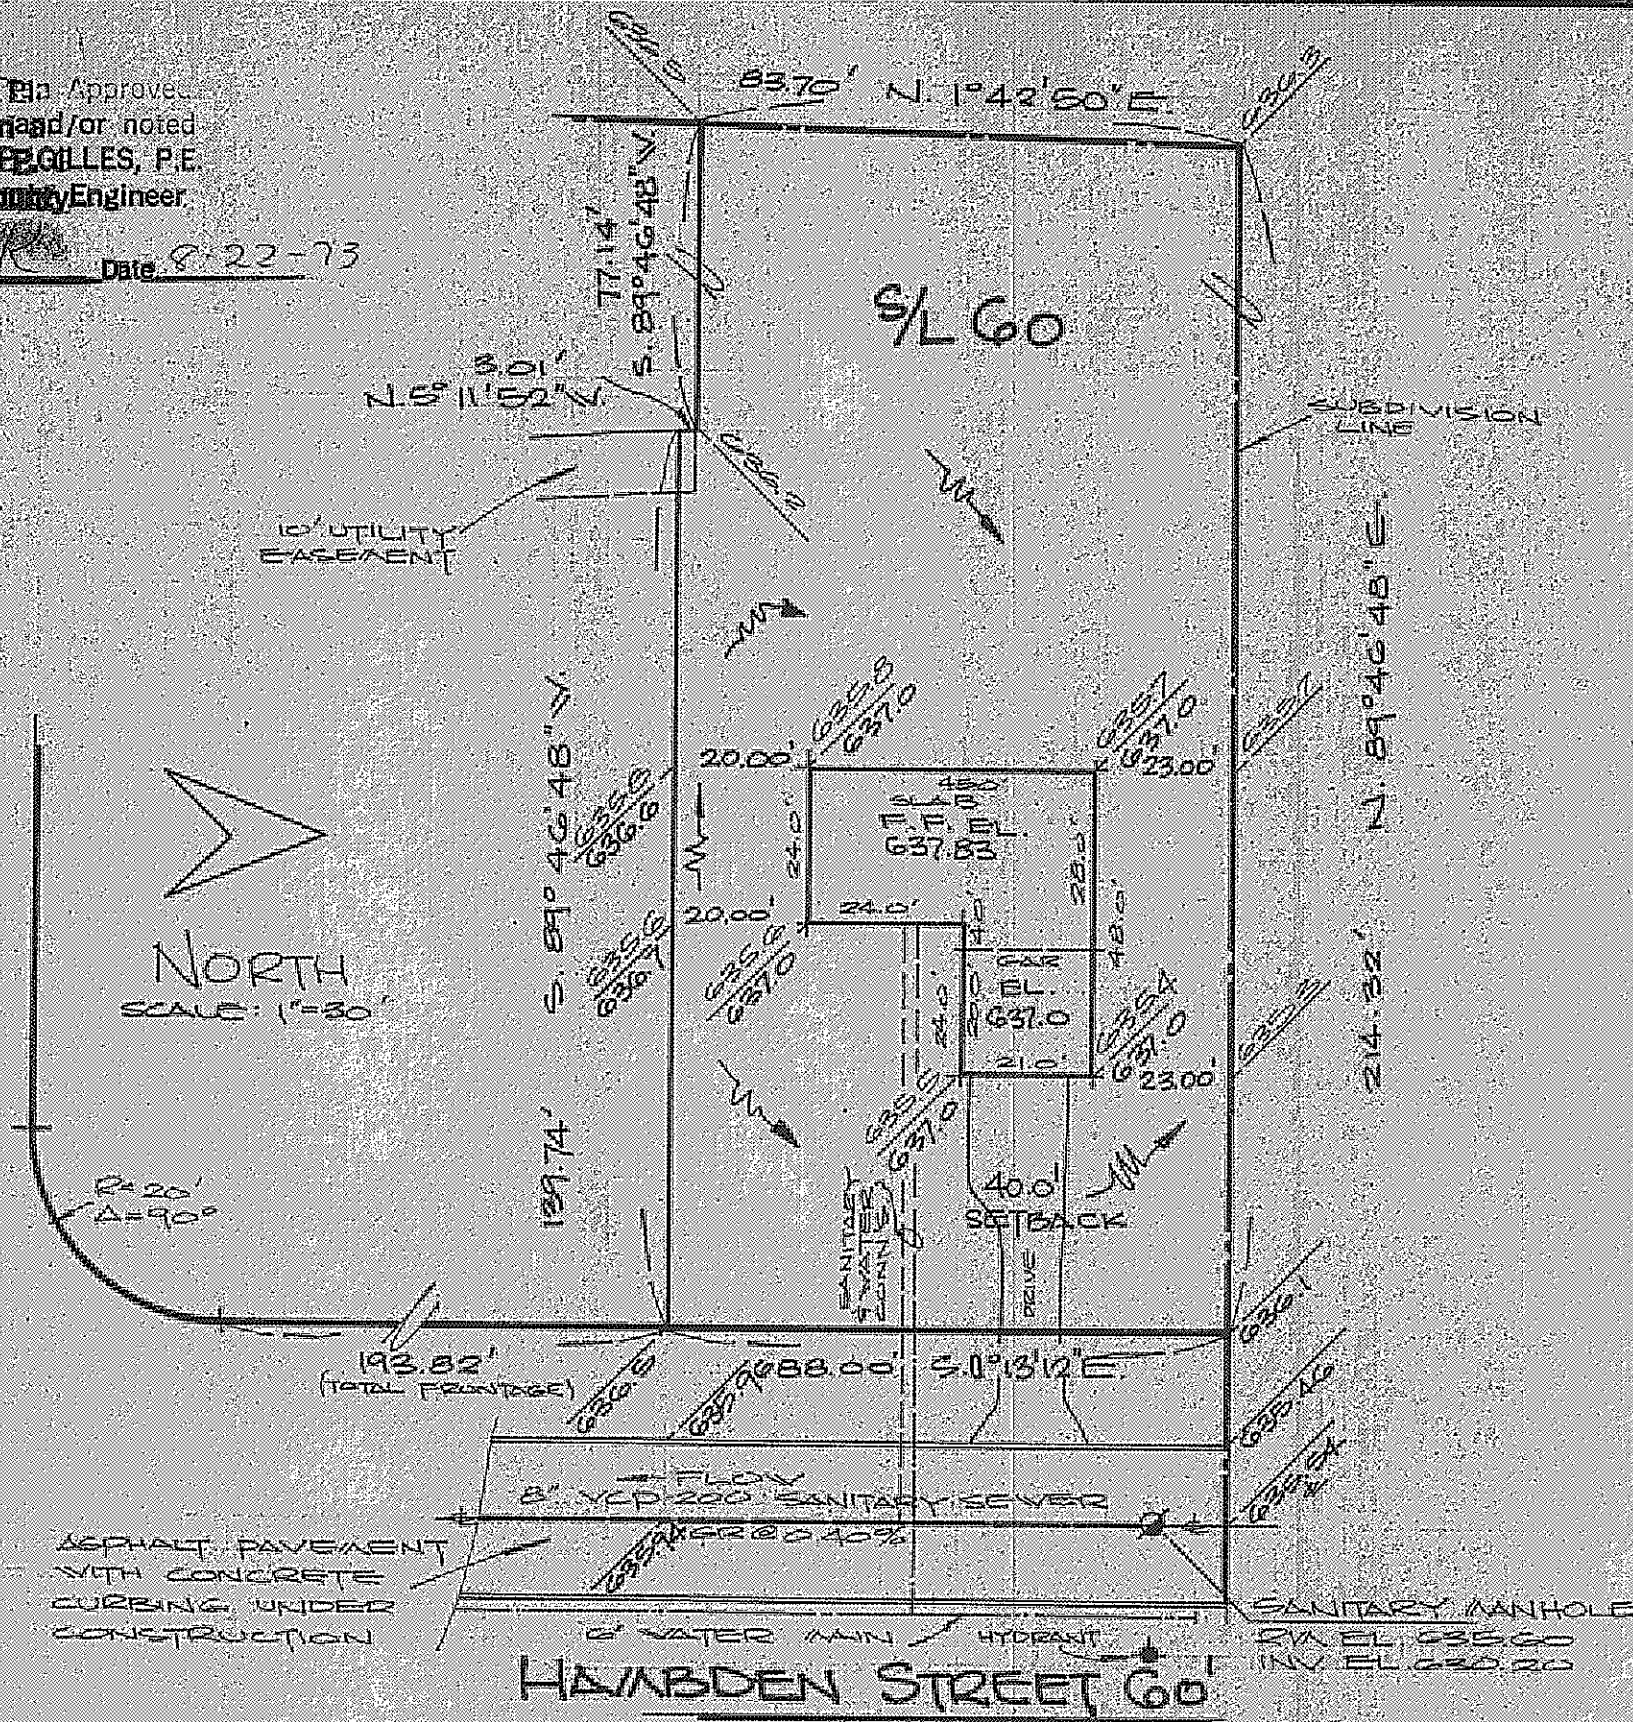

ASPHALT PAVEMENT
 WITH CONCRETE
 CURBING UNDER
 CONSTRUCTION

HAMBDEN STREET GO'

"AS BUILT" CERTIFICATION

I HEREBY CERTIFY THAT THE CIRCLED GRADES ARE EXISTING FINISH GRADES CHECKED IN FIELD ON 19 BY SURVEYING AND ARE CORRECT TO THE BEST OF MY KNOWLEDGE AND BELIEF

REGISTERED SURVEYOR NO.

SITE PLAN

MADISON TOWNSHIP LAKE COUNTY, OHIO
 for: PURITAN HOMES CLIENT OWNER

ADDRESS	STREET	CITY	ZIP
CHADEL GROVE SUBDIVISION			
S/L GO			
SUBJECT NO.	VOLUME - PAGE HAMBDEN STREET	LOT	TRACT
		VOLUME	PAGE
		PARCEL #	STREET

LEGEND

SANITARY MANHOLE	---	○	WATER VALVE (GAS)	---	⊥
STORM MANHOLE	---	●	WATER METER (GAS)	---	○
INLET OR CATCH BASIN	---	■	AS BUILT ELEVATION	---	100.0
HYDRANT	---	◇	INDICATES DIRECTION OF SURFACE DRAINAGE	---	⚡
EXISTING CONTOUR	---	---			
PROPOSED CONTOURS	---	---			
EXIST. ELEV.	---	---			
					100.0 - PROP. ELEV.

REMARKS

ALL BOUNDARY DATA SHOWN WAS OBTAINED FROM (DEEDS, RECORDED SUBDIVISION PLAT, OR OTHER PUBLIC RECORDS)

DESIGN CERTIFICATION

THIS PLAN WAS PREPARED BY ME, AND IS CORRECT TO THE BEST OF MY KNOWLEDGE AND BELIEF
Richard DeBevec #5244
 NAME SURVEYOR REGISTRATION NO.

CHECK LIST

DIMENSIONS	WATER MAIN SIZE	LOCATION
BEARINGS	SAN SEWER SIZE	% GR LOC
NEAREST STREET	SAN MH CAST ELEV	INV. ELEV.
NEAREST PARCEL NO.	SAN L IN SIZE	LOC. WITH
OWNER	STORM SEWER SIZE	% GR LOC
BOUNDARY DIMENSIONS	STORM MH CAST ELEV	INV. ELEV.
BOUNDARY TIES	FLR GRADER	PAV. TYPE
APRON TYPE	WIDTH THICKNESS	GAS LINE
SI WALK TYPE	WIDTH THICKNESS	SEWER
CULVERT TYPE	SIZE	LOC.

NO.	DATE	BY
3		
4		

PLAN PREPARED BY
 DEBEVEC-SALO & ASSOC., INC.
 NAME
 130 E. JACKSON ST. PAINESVILLE, O.
 ADDRESS

DRAWN	AG	SCALE	1"=30'
CHK		DATE	6/11/73
CREW CHIEF		APP'D	
		DRAWING NO.	3854
			60