

SITE PLAN FOR:

PAC HOMES

812 NERING CIRCLE
GENEVA, OHIO

BEING SUBLOTS 575 AND 576
IN THE MADISON LAKELAND
SUBDIVISION IN MADISON TOWNSHIP,
LAKE COUNTY, OHIO

PREPARED BY

WM. R. GRAY ASSOC. INC.

7547 MENTOR AVE
MENTOR OHIO

SCALE: 1"=20'

DATE: AUG 18, 1977


CERTIFICATION

I HEREBY CERTIFY THAT
THIS PLAT IS CORRECT TO THE
BEST OF MY KNOWLEDGE

BY Wm. R. Gray
WM. R. GRAY REG. SURV. # 2752

Grading Plan Approved
as shown and/or noted
THOMAS P. GILLES, P.E.
Lake County Engineer

By D.J.L. Date 8/25/77

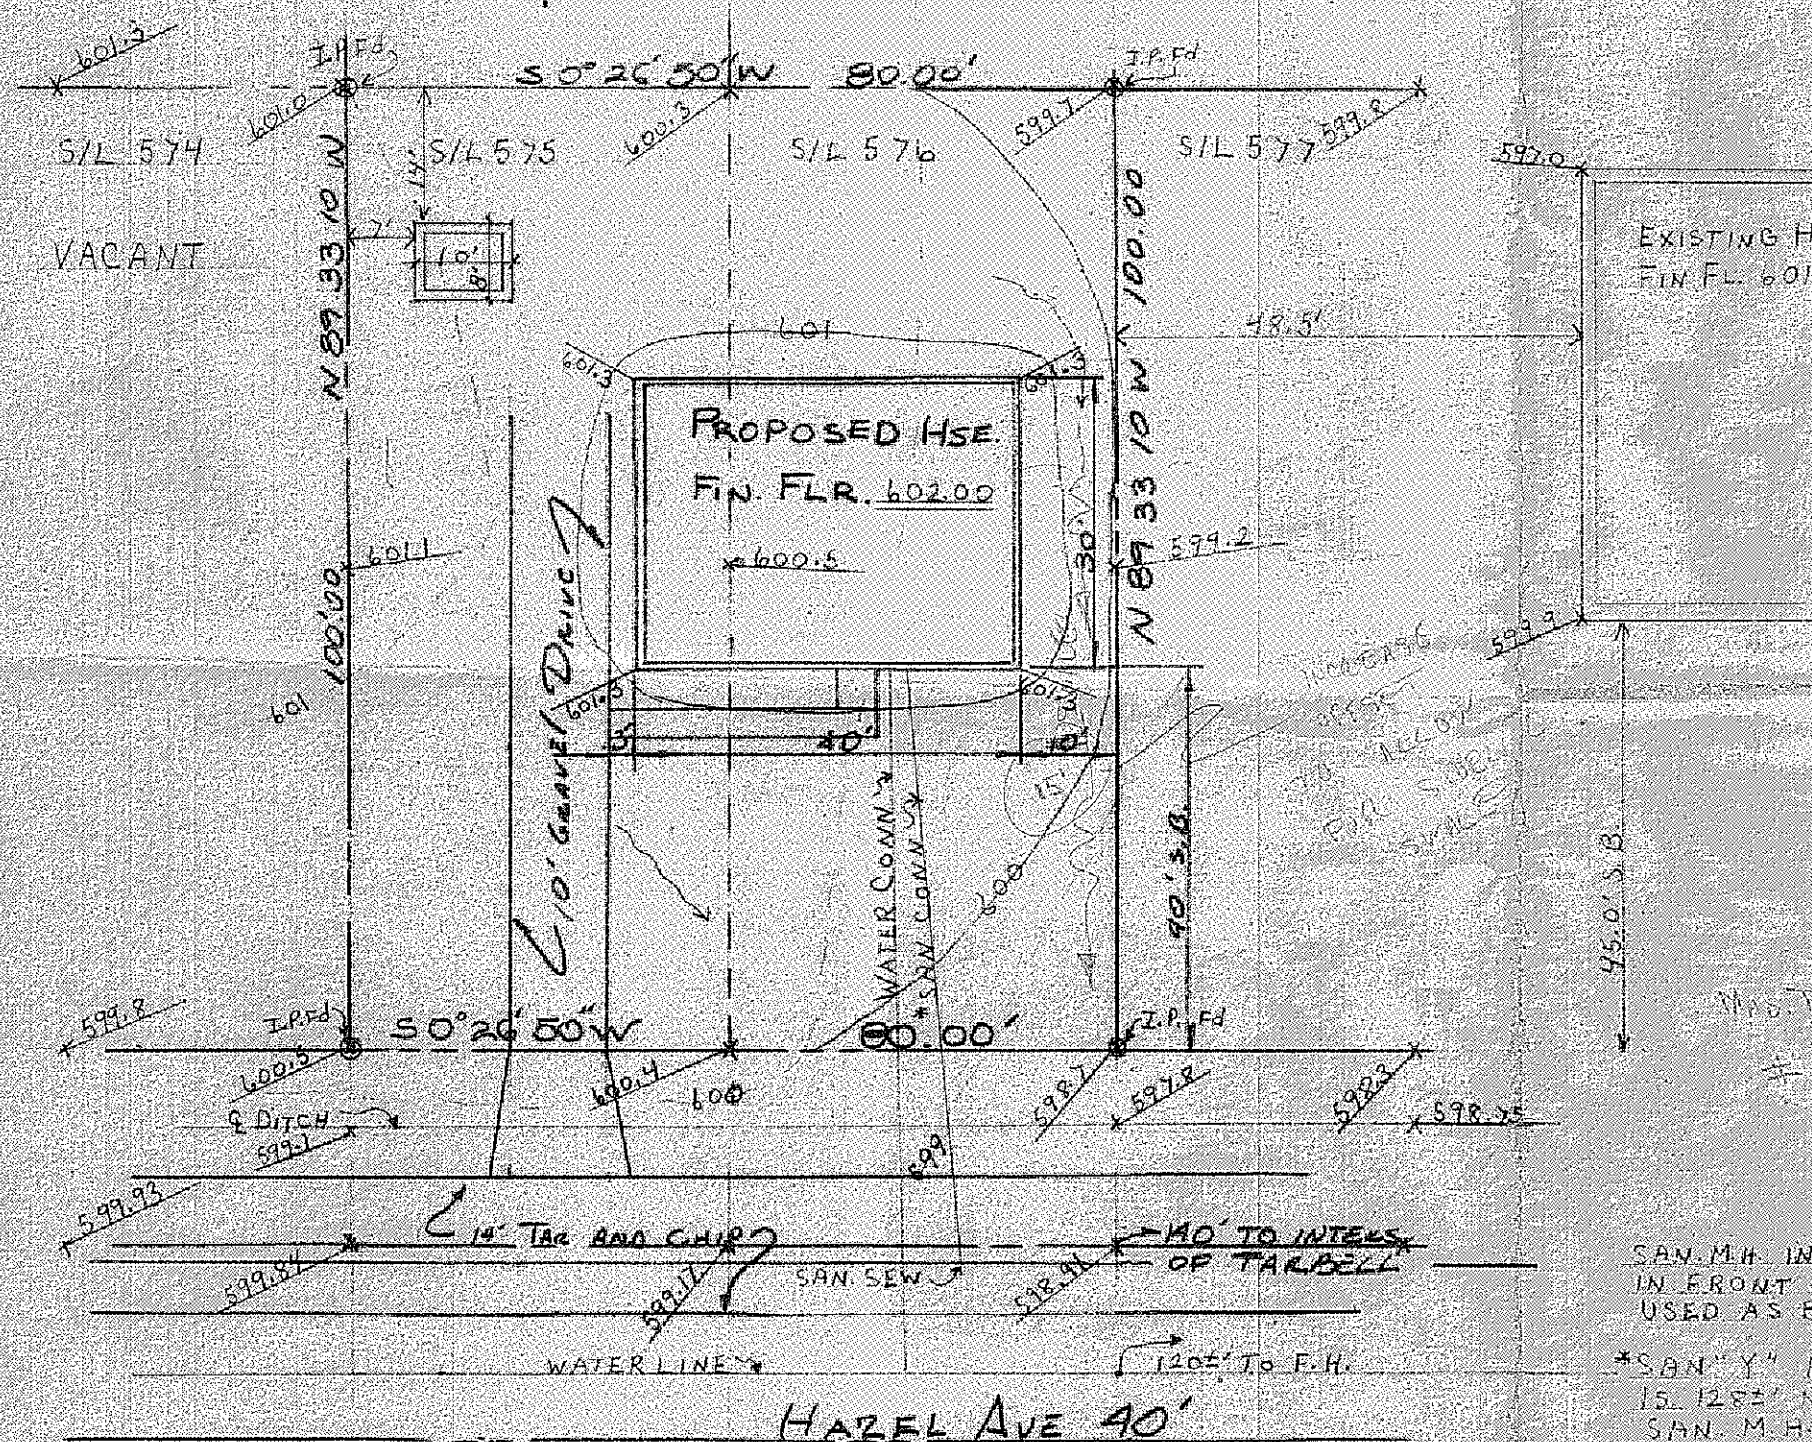

SAN. M.H. INV. = 592.80
IN FRONT OF S/L 579
USED AS B.M.

*SAN. Y" FOR S/L 576
IS 1283' NORTH OF
SAN. M.H.