


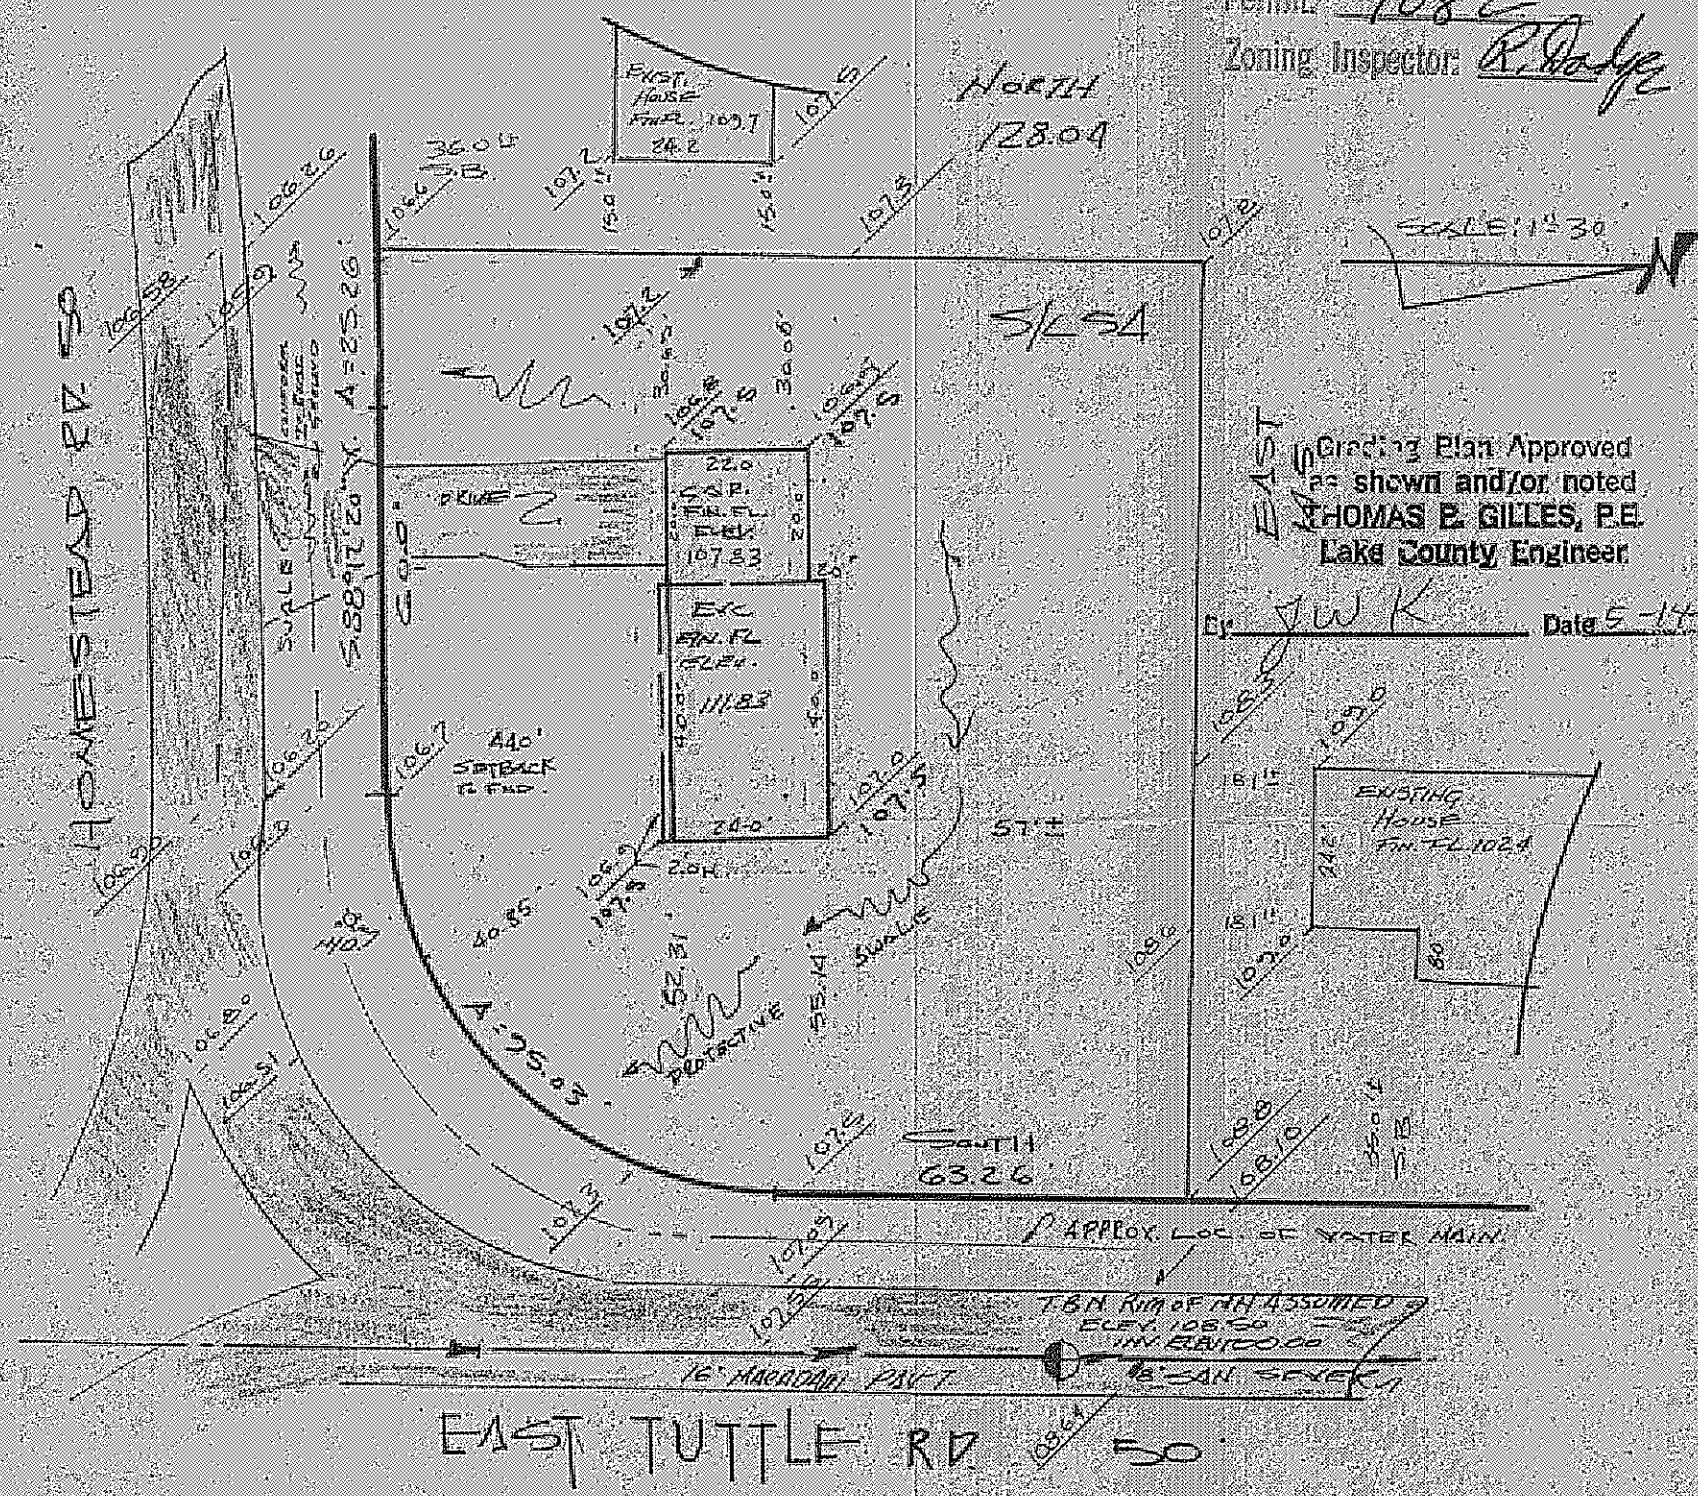

APPROVED
MADISON TWP. ZONING
Permit: 9082
Zoning Inspector: R. D. Galt

SITE PLAN
MADISON TOWNSHIP
LAKE COUNTY, OHIO
for: ARTCRAFT
CLIENT OWNER

ADDRESS	STREET	CITY	ZIP
NORTHERN LIGHTS SUBD			
SUBDIVISION	ED NAME	LOT	TRACT
IT 54	VOL. - PG.	VOLUME	PAGE
SUBLOT NO.	STREET	PERM. PARCEL #	STREET

LEGEND	
SANITARY MANHOLE	--- (1) ---
STORM MANHOLE	--- (2) ---
INLET OR CATCH BASIN	--- (3) ---
HYDRANT	--- (4) ---
EXISTING CONTOURS	--- (5) ---
PROPOSED CONTOURS	--- (6) ---
EXIST. ELEV.	100.0
PROP. ELEV.	100.0
WATER VALVE (GAS)	--- (7) ---
WATER METER (GAS)	--- (8) ---
AS BUILT ELEVATION	--- (9) ---
INDICATES DIRECTION OF SURFACE DRAINAGE	--- (10) ---

REMARKS
ALL BOUNDARY DATA SHOWN WAS OBTAINED FROM (DEEDS, RECORDED SUBDIVISION PLAT OR OTHER PUBLIC RECORDS)

DESIGN CERTIFICATION
THIS PLAT WAS PREPARED BY ME, AND IS CORRECT TO THE BEST OF MY KNOWLEDGE AND BELIEF.
NAME: [Signature] PS # 5244
SURVEYOR REGISTRATION NO.

CHECK LIST	
DIMENSIONS	WATER MAIN SIZE LOCATION
BEARINGS	SAN SEWER SIZE % GR. LOC.
TIE TO NEAREST STREET	SAN MH CAST ELEV. INV. ELEV.
SUBLOT NO. PARCEL NO.	SAN CONN. SIZE LOC. DEPTH
SURROUNDING OWNERS	STORM SEWER SIZE % GR. LOC.
BLDG DIMENSIONS FIN. GR.	STORM MH CAST ELEV. INV. ELEV.
BLDG TIES FLR GRADES	PAVT TYPE GRADE CURBS
APRON TYPE WIDTH THICKNESS	GASLINE LOC. SIZE PRESSURE
SIDEWALK TYPE WIDTH THICKNESS	SEPTIC TANK SIZE LOC.
CULVERT TYPE DIA. LENGTH	WELL LOCATION

"AS BUILT" CERTIFICATION
I, HEREBY CERTIFY THAT THE CIRCLED GRADES ARE EXISTING FINISH GRADES CHECKED IN FIELD ON 19 BY SURVEYING AND ARE CORRECT TO THE BEST OF MY KNOWLEDGE AND BELIEF
REGISTERED SURVEYOR REG. NO.

REVISIONS			PLAN PREPARED BY:		
NO	DATE	BY	DEBEVEC-SALO & ASSOC, INC.		
1			130 EAST JACKSON ST. PAINESVILLE		
2					
3			DRAWN BY	SCALE 1" = 30'	PHONE NO.
4			CHK'D	DATE 10/14/70	DRAWING NO.
5			CREW CHIEF	APPD	4146-54