


Grading Plan Approved
as shown and/or noted
THOMAS P. GILLES, P.E.
Lake County Engineer

By JWK Date 5-30-74

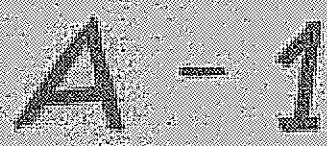

REV. 5-30-74
REV. 5-13-74

SITE PLAN
 FOR
 ASHTABULA SAVINGS & LOAN CO.
 PART OF COMLEX LOT
 MADISON TOWNSHIP, LAKE COUNTY, OHIO TRACT 2
 Colpetzer • Woods Consultants, Inc.
 CONSULTING ENGINEERS AND SURVEYORS
 PAINESVILLE, OHIO 44077
 DATE 10/2/83
 SCALE 1" = 40'
 DRAWN BY
 CHK'D BY
 P.S. 2/22

DATE MARCH 1974
SCALE 1"=20'
DRAWN BY B.C.
CHK'D BY [Signature]
F.B.# 252 PG. 30

4082-4-6