


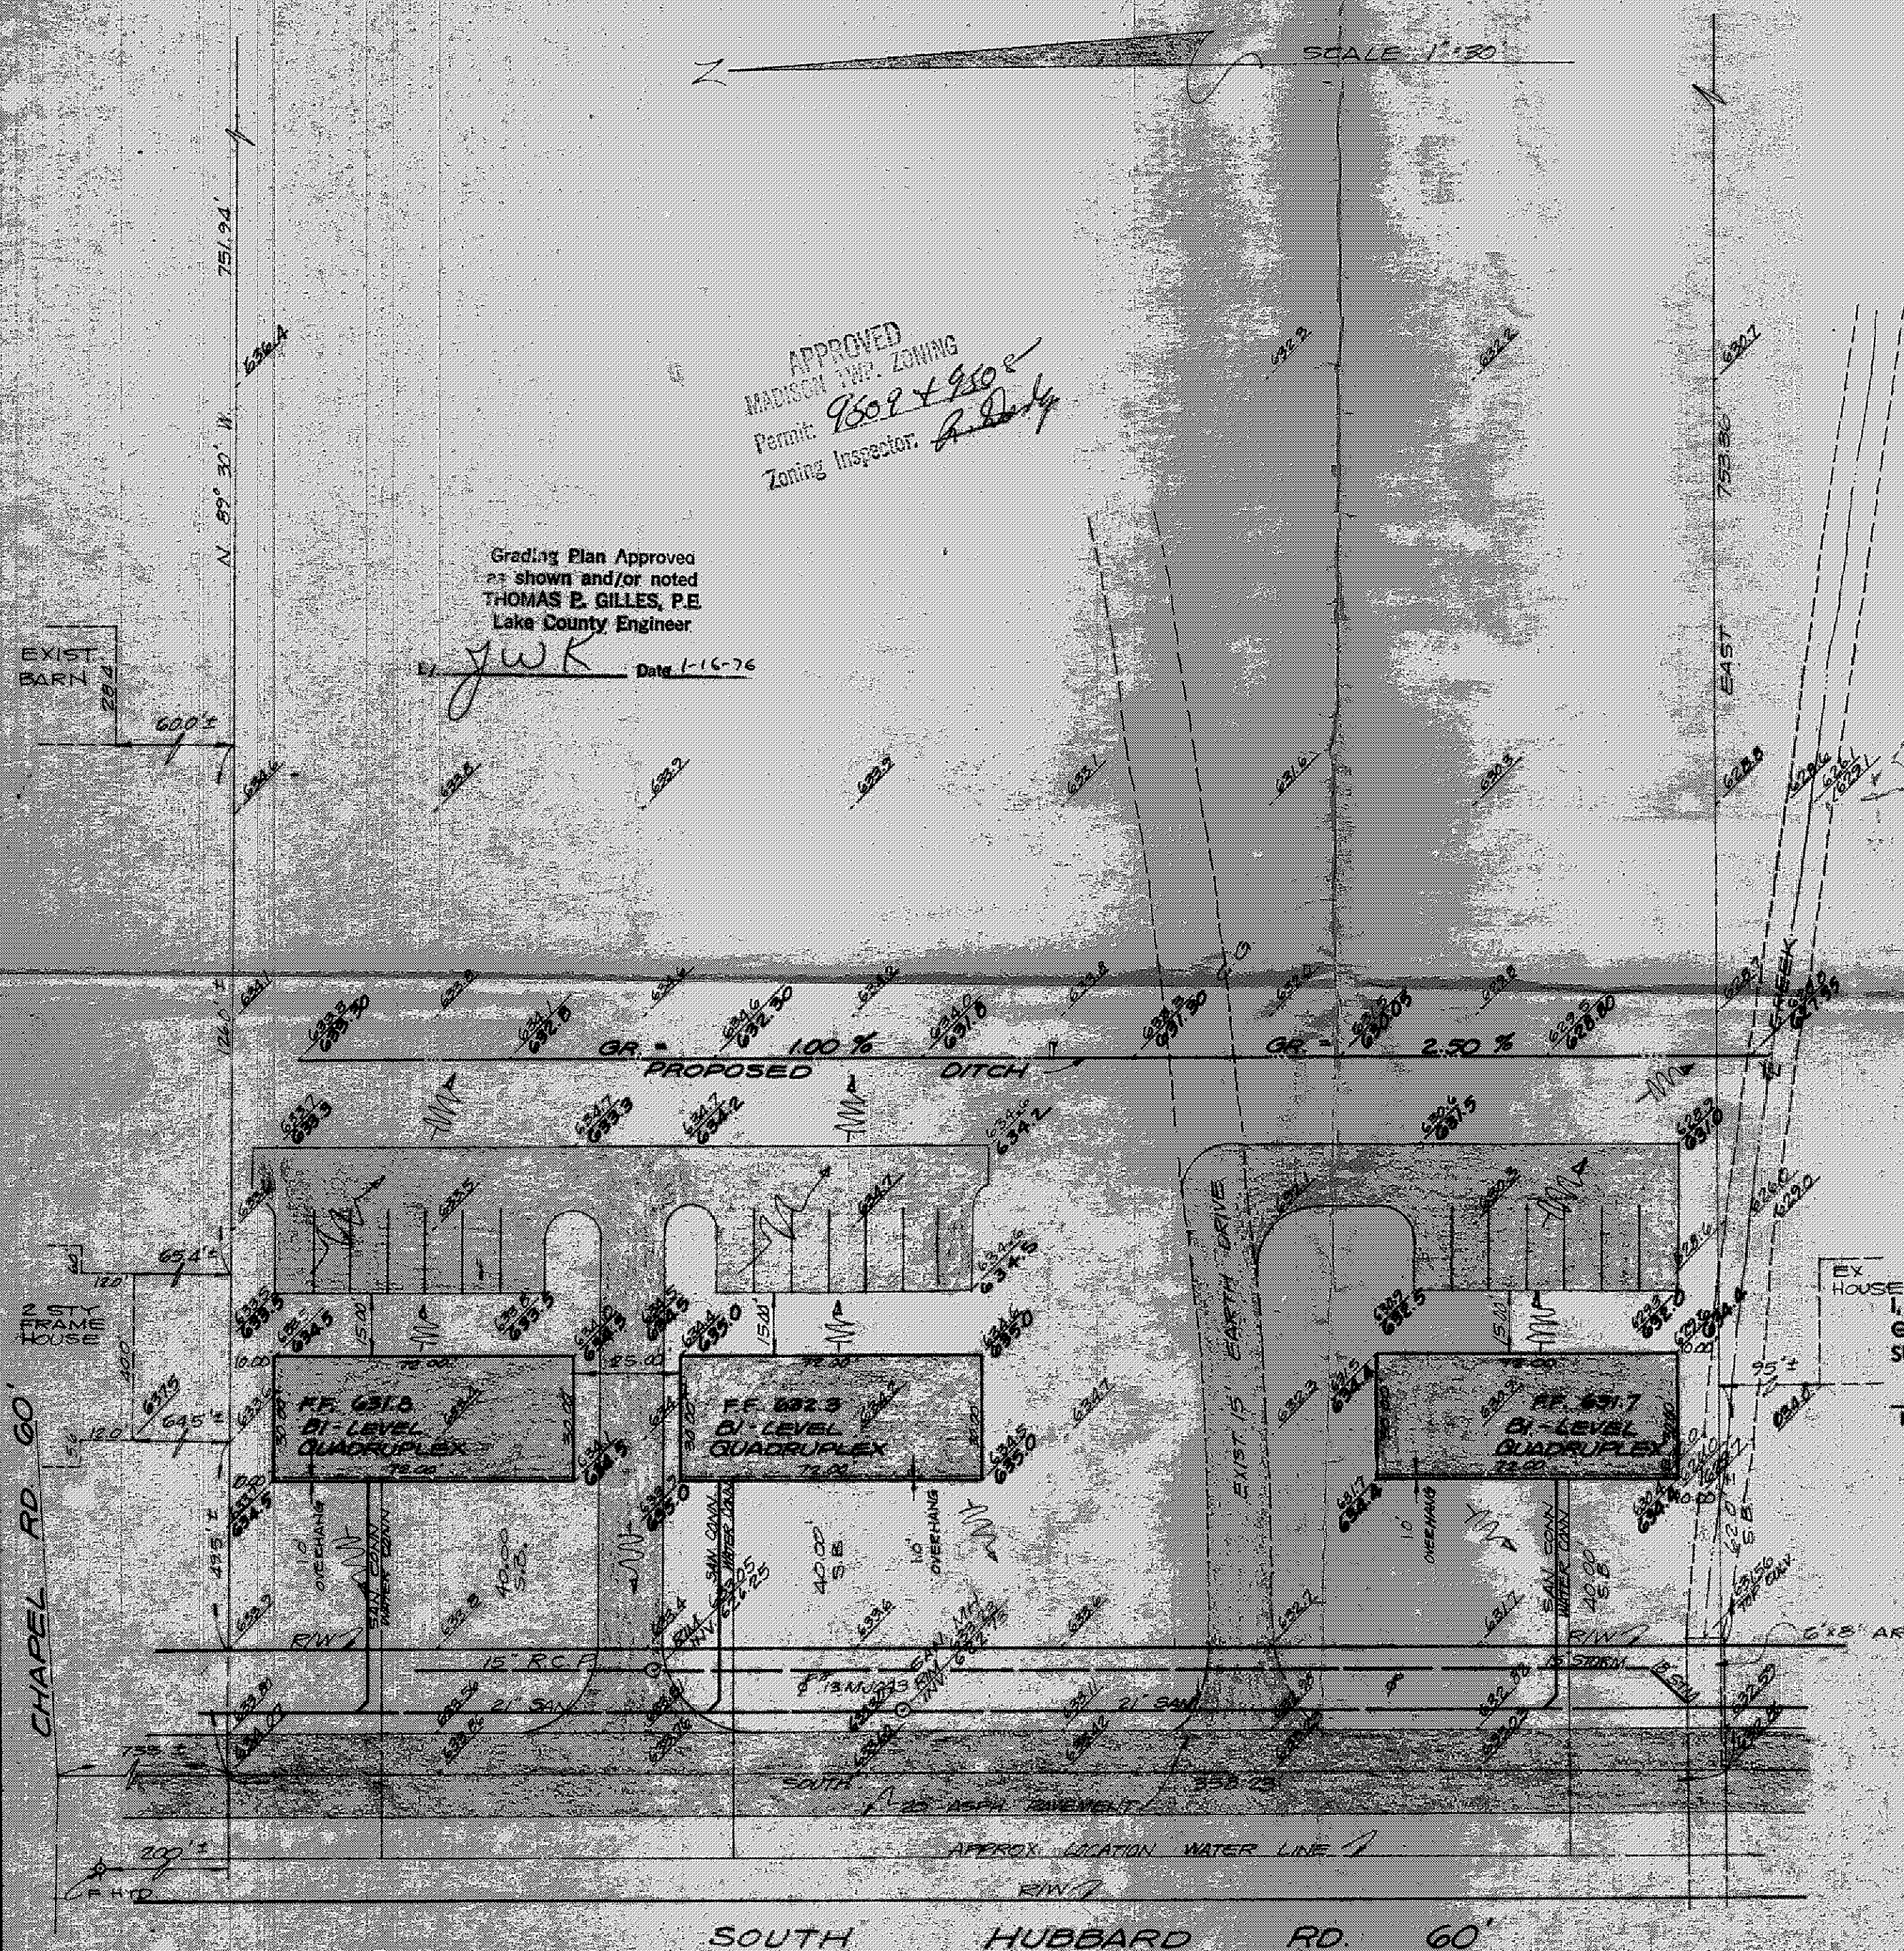

APPROVED
MADISON TWP. ZONING
Permit: 9609 + 9508
Zoning Inspector: *[Signature]*

Grading Plan Approved
as shown and/or noted
THOMAS E. GILLES, P.E.
Lake County Engineer

ywk Date 1-16-76

SITE PLAN

MADISON LAKE COUNTY, OHIO
for: ARTCRAFT HOMES
6586 N. RIDGE W. MADISON, O 44057
ADDRESS STREET CITY ZIP

SUBDIVISION	NAME	LOT	TRACT
VOL. & PG.		VOLUME	PAGE
SUBLOT NO.	STREET	PERM. PARCEL NO.	STREET

LEGEND

SANITARY MANHOLE	—●—	WATER VALVE (GAS)	—*—
STORM MANHOLE	—●—	WATER METER (GAS)	—*—
INLET OR CATCH BASIN	—■—	AS BUILT ELEVATION	100.0
HYDRANT	—●—		
EXISTING CONTOURS	—---—	INDICATES DIRECTION OF SURFACE DRAINAGE	↓
PROPOSED CONTOURS	—---—		
EXIST. ELEV.	100.0	PROP. ELEV.	100.0

REMARKS

ALL BOUNDARY DATA SHOWN WAS OBTAINED FROM IDEEDS, RECORDED SUBDIVISION PLAT OR OTHER PUBLIC RECORDS
LOCATIONS AS SHOWN OF ADJACENT WELLS AND SEPTIC TANKS OBTAINED FROM LAKE COUNTY HEALTH DEPARTMENT

DESIGN CERTIFICATION

THIS PLAT WAS PREPARED BY ME, AND IS CORRECT TO THE BEST OF MY KNOWLEDGE AND BELIEF
Richard J. Salo PS #5244
NAME SURVEYOR REGISTRATION NO.

CHECK LIST

NO. OF BEDROOMS	WATER MAIN SIZE, LOCATION
DIMENSIONS	SAN. SEWER SIZE & GR. LOC.
BEARINGS	SAN. MH. CAST ELEV. INV. ELEV.
TIE TO NEAREST STREET	SAN. CONN. SIZE, LOC. DEPTH
SUBLOT NO. PARCEL NO.	STORM SEWER SIZE & GR. LOC.
SURROUNDING OWNERS	STORM MH. CAST ELEV. INV. ELEV.
BLOG. DIMENSIONS FIN. GR.	PAV'T TYPE GRADE CURBS
BLOG. TIES FLTR. GRADES	GAS LINE LOC. SIZE PRESSURE
APRON TYPE WIDTH THICKNESS	SEPTIC TANK LOCATION & DUPLICATION AREA
SIDEWALK TYPE WIDTH THICKNESS	WELL LOCATION
CULVERT TYPE DIA. LENGTH	ISOLATION RADIUS FROM WELL
ROCK OUTCROPPINGS	

REVISIONS			PLAN PREPARED BY:		
NO.	DATE	BY	DEBEVEC - SALO & ASSOCIATES, INC.		
1	4-21-75	RJB	130 EAST JACKSON ST.	FAIRBANKS, OHIO	
2			DRAWN BY <i>TP</i>	SCALE 1"=30'	PHONE NO. 332-9250
3			CHK'D <i>RJB</i>	DATE 4-4-75	DRAWING NO. #4432
4			CREW CHIEF	APP'D	

"AS BUILT" CERTIFICATION

I, HEREBY CERTIFY THAT THE CIRCLED GRADES ARE EXISTING FINISH GRADES CHECKED IN FIELD ON 19 BY SURVEYING AND ARE CORRECT TO THE BEST OF MY KNOWLEDGE AND BELIEF.

REGISTERED SURVEYOR REG. NO.