


"I, the undersigned hereby certify that this topography indicated by 6", 1", or 2" contours, and elevations shown hereon represent an actual field survey made by me on the 28th day of June, 2003 and that the elevations were taken at appropriate intervals and that as of that date they existed as indicated hereon."

[Signature]
Name: *[Signature]* #6313
Reg. No.

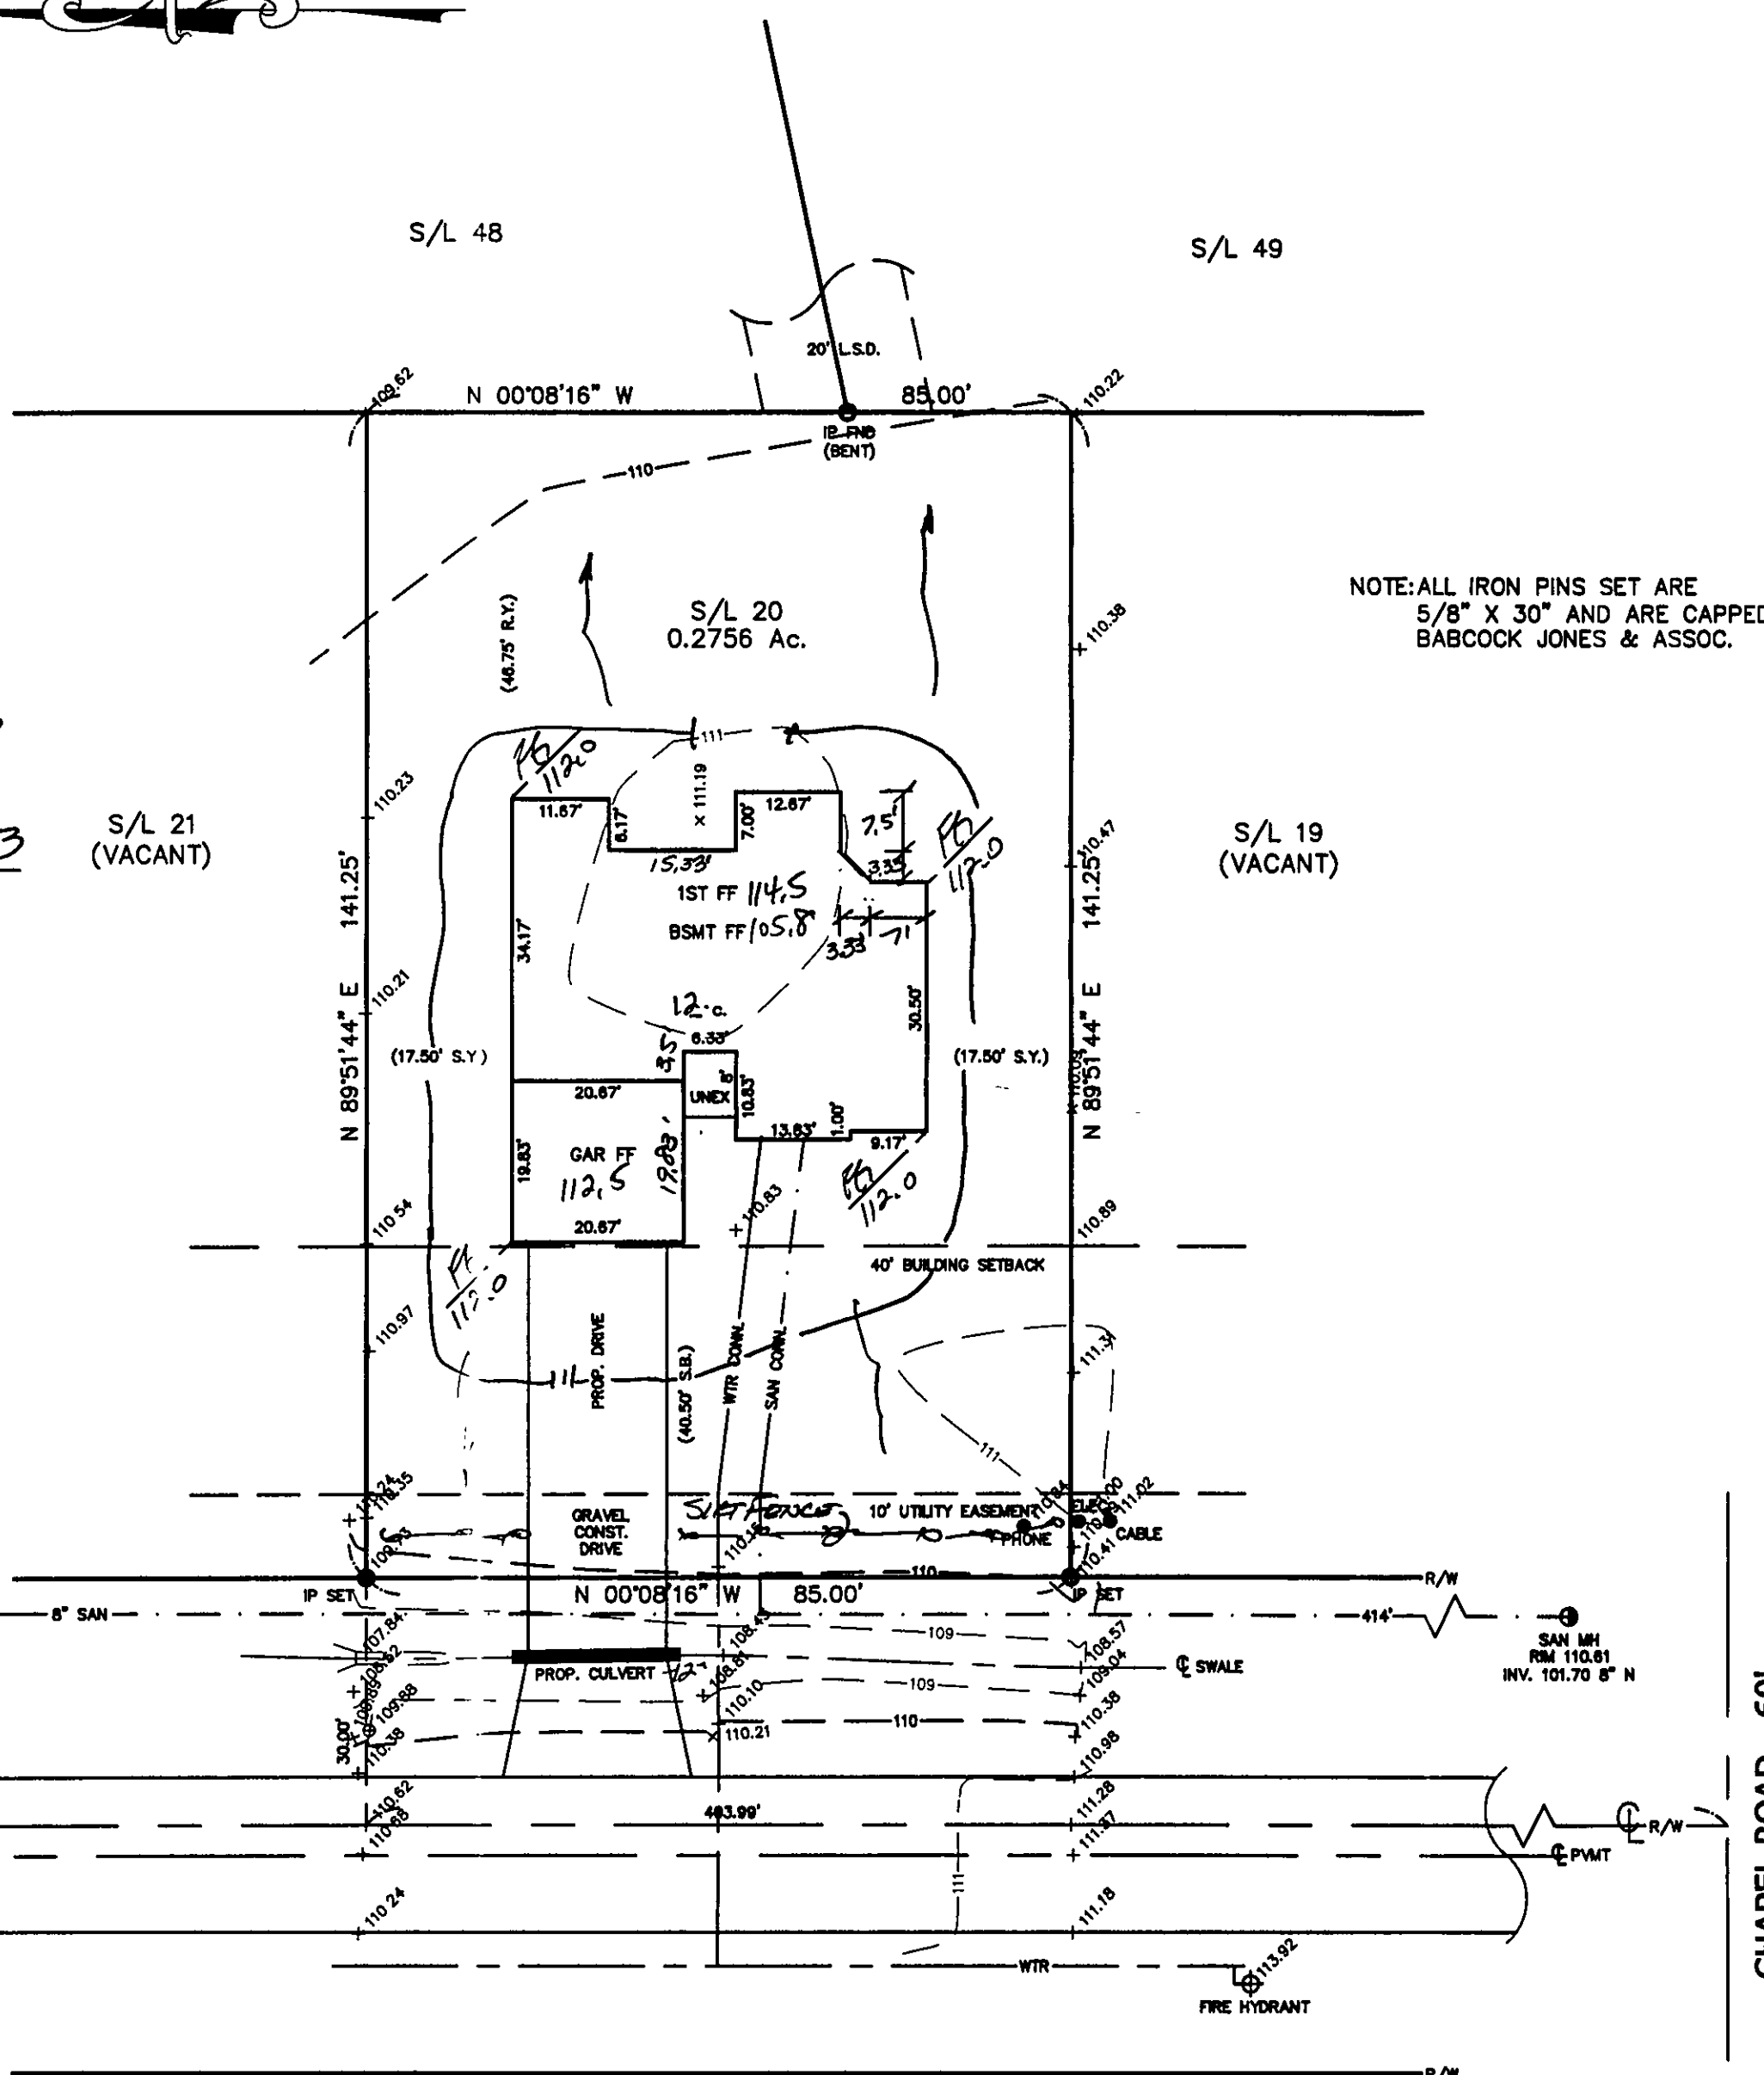

NOTE: ALL IRON PINS SET ARE 5/8" X 30" AND ARE CAPPED BABCOCK JONES & ASSOC.

SITE PLAN

MADISON TOWNSHIP, LAKE COUNTY, OHIO

for: TRESGER CONSTRUCTION

CLIENT: _____ OWNER: _____

ADDRESS: _____ STREET: _____ CITY: _____ ZIP: _____

WINDJAMMER SUB

SUBDIVISION: 33-15 NAME: _____ TRACT: _____ STREET: _____

20 VOL-PG. HAINES ROAD LOT: _____

SUBLOT NO. STREET VOL-PG. PERM. PARCEL NO.

LEGEND

SANITARY MANHOLE --- (Symbol) --- EXIST. ELEV. --- 100.0 --- PROP. ELEV. --- 100.0

STORM MANHOLE --- (Symbol) --- AS BUILT ELEVATION

INLET OR CATCH BASIN --- (Symbol) --- INDICATES DIRECTION OF SURFACE DRAINAGE

HYDRANT --- (Symbol) ---

EXISTING CONTOURS --- (Symbol) ---

PROPOSED CONTOURS --- (Symbol) ---

REMARKS

ALL BOUNDARY DATA SHOWN WAS OBTAINED FROM (DEEDS, RECORDED SUBDIVISION PLAT OR OTHER PUBLIC RECORDS)

LOCATIONS AS SHOWN OF ADJACENT WELLS AND SEPTIC TANKS OBTAINED FROM LAKE COUNTY HEALTH DEPARTMENT

DESIGN CERTIFICATION

THIS PLAT WAS PREPARED BY ME, AND IS CORRECT TO THE BEST OF MY KNOWLEDGE AND BELIEF.

NAME: *[Signature]* #6313 SURVEYOR REGISTRATION NO.

CHECK LIST

NO. OF BEDROOMS	WATER MAIN SIZE, LOCATION
DIMENSIONS	SAN. SEWER SIZE & GR. LOC.
BEARINGS	SAN. MH. CAST. ELEV. INV. ELEV.
TIE TO NEAREST STREET	SAN. CONN. SIZE, LOC. DEPTH
SUBLOT NO. PARCEL NO.	STORM SEWER SIZE & GR. LOC.
SURROUNDING OWNERS	STORM MH. CAST. ELEV. INV. ELEV.
BLDG. DIMENSIONS FIN GR.	PAY'T TYPE GRADE CURBS
BLDG. TIES FL'R. GRADES	GAS LINE LOC. SIZE PRESSURE
APRON TYPE WIDTH THICKNESS	SEPTIC TANK LOCATION & DUPLICATION / REA
SIDEWALK TYPE WIDTH THICKNESS	WELL LOCATION
CULVERT TYPE DIA. LENGTH	ISOLATION RADIUS FROM WELL
ROCK OUTCROPPINGS	

REVISIONS

NO.	DATE	BY
1		
2		
3		
4		
5		

PLAN PREPARED BY: **BABCOCK JONES & ASSOCIATES, INC.** PAINESVILLE, OHIO

DRAWN BY: B.P. SCALE: 1"=20' PHONE NO. 440-367-1811

CHK'D: H.J. DATE: 9/4/03 DRAWING NO. 97-268-20

APP'D: H.J.

"AS BUILT" CERTIFICATION

I, HEREBY CERTIFY THAT THE CIRCLED GRADES ARE EXISTING FINISH GRADES CHECKED IN THE FIELD ON 9/4/03, 2003 AND ARE CORRECT TO THE BEST OF MY KNOWLEDGE AND BELIEF.

REGISTERED SURVEYOR _____ REG. NO. _____

TBM - INV. NORTH SAN M.H.
ELEV - 100.00

Grading Plan Approved
as shown and/or noted
JAMES R. GILLS, P.E.
Lake County Engineer

APPROVED
MADISON TOWNSHIP ZONING
DATE: 9/8/03
BY: *[Signature]* #21563

ROOF DRAINS SHALL DISCHARGE TO SPLASH BLOCKS.

EXISTING UTILITIES NOTE:
THE SIZE AND LOCATION, BOTH HORIZONTAL AND VERTICAL OF THE UNDERGROUND UTILITIES SHOWN HEREON, HAVE BEEN OBTAINED BY A SEARCH OF AVAILABLE RECORDS. VERIFICATION BY FIELD OBSERVATION HAS BEEN CONDUCTED WHERE PRACTICAL. HOWEVER, BABCOCK, JONES AND ASSOCIATES, INC. DOES NOT GUARANTEE THE COMPLETENESS NOR ACCURACY THEREOF.

