
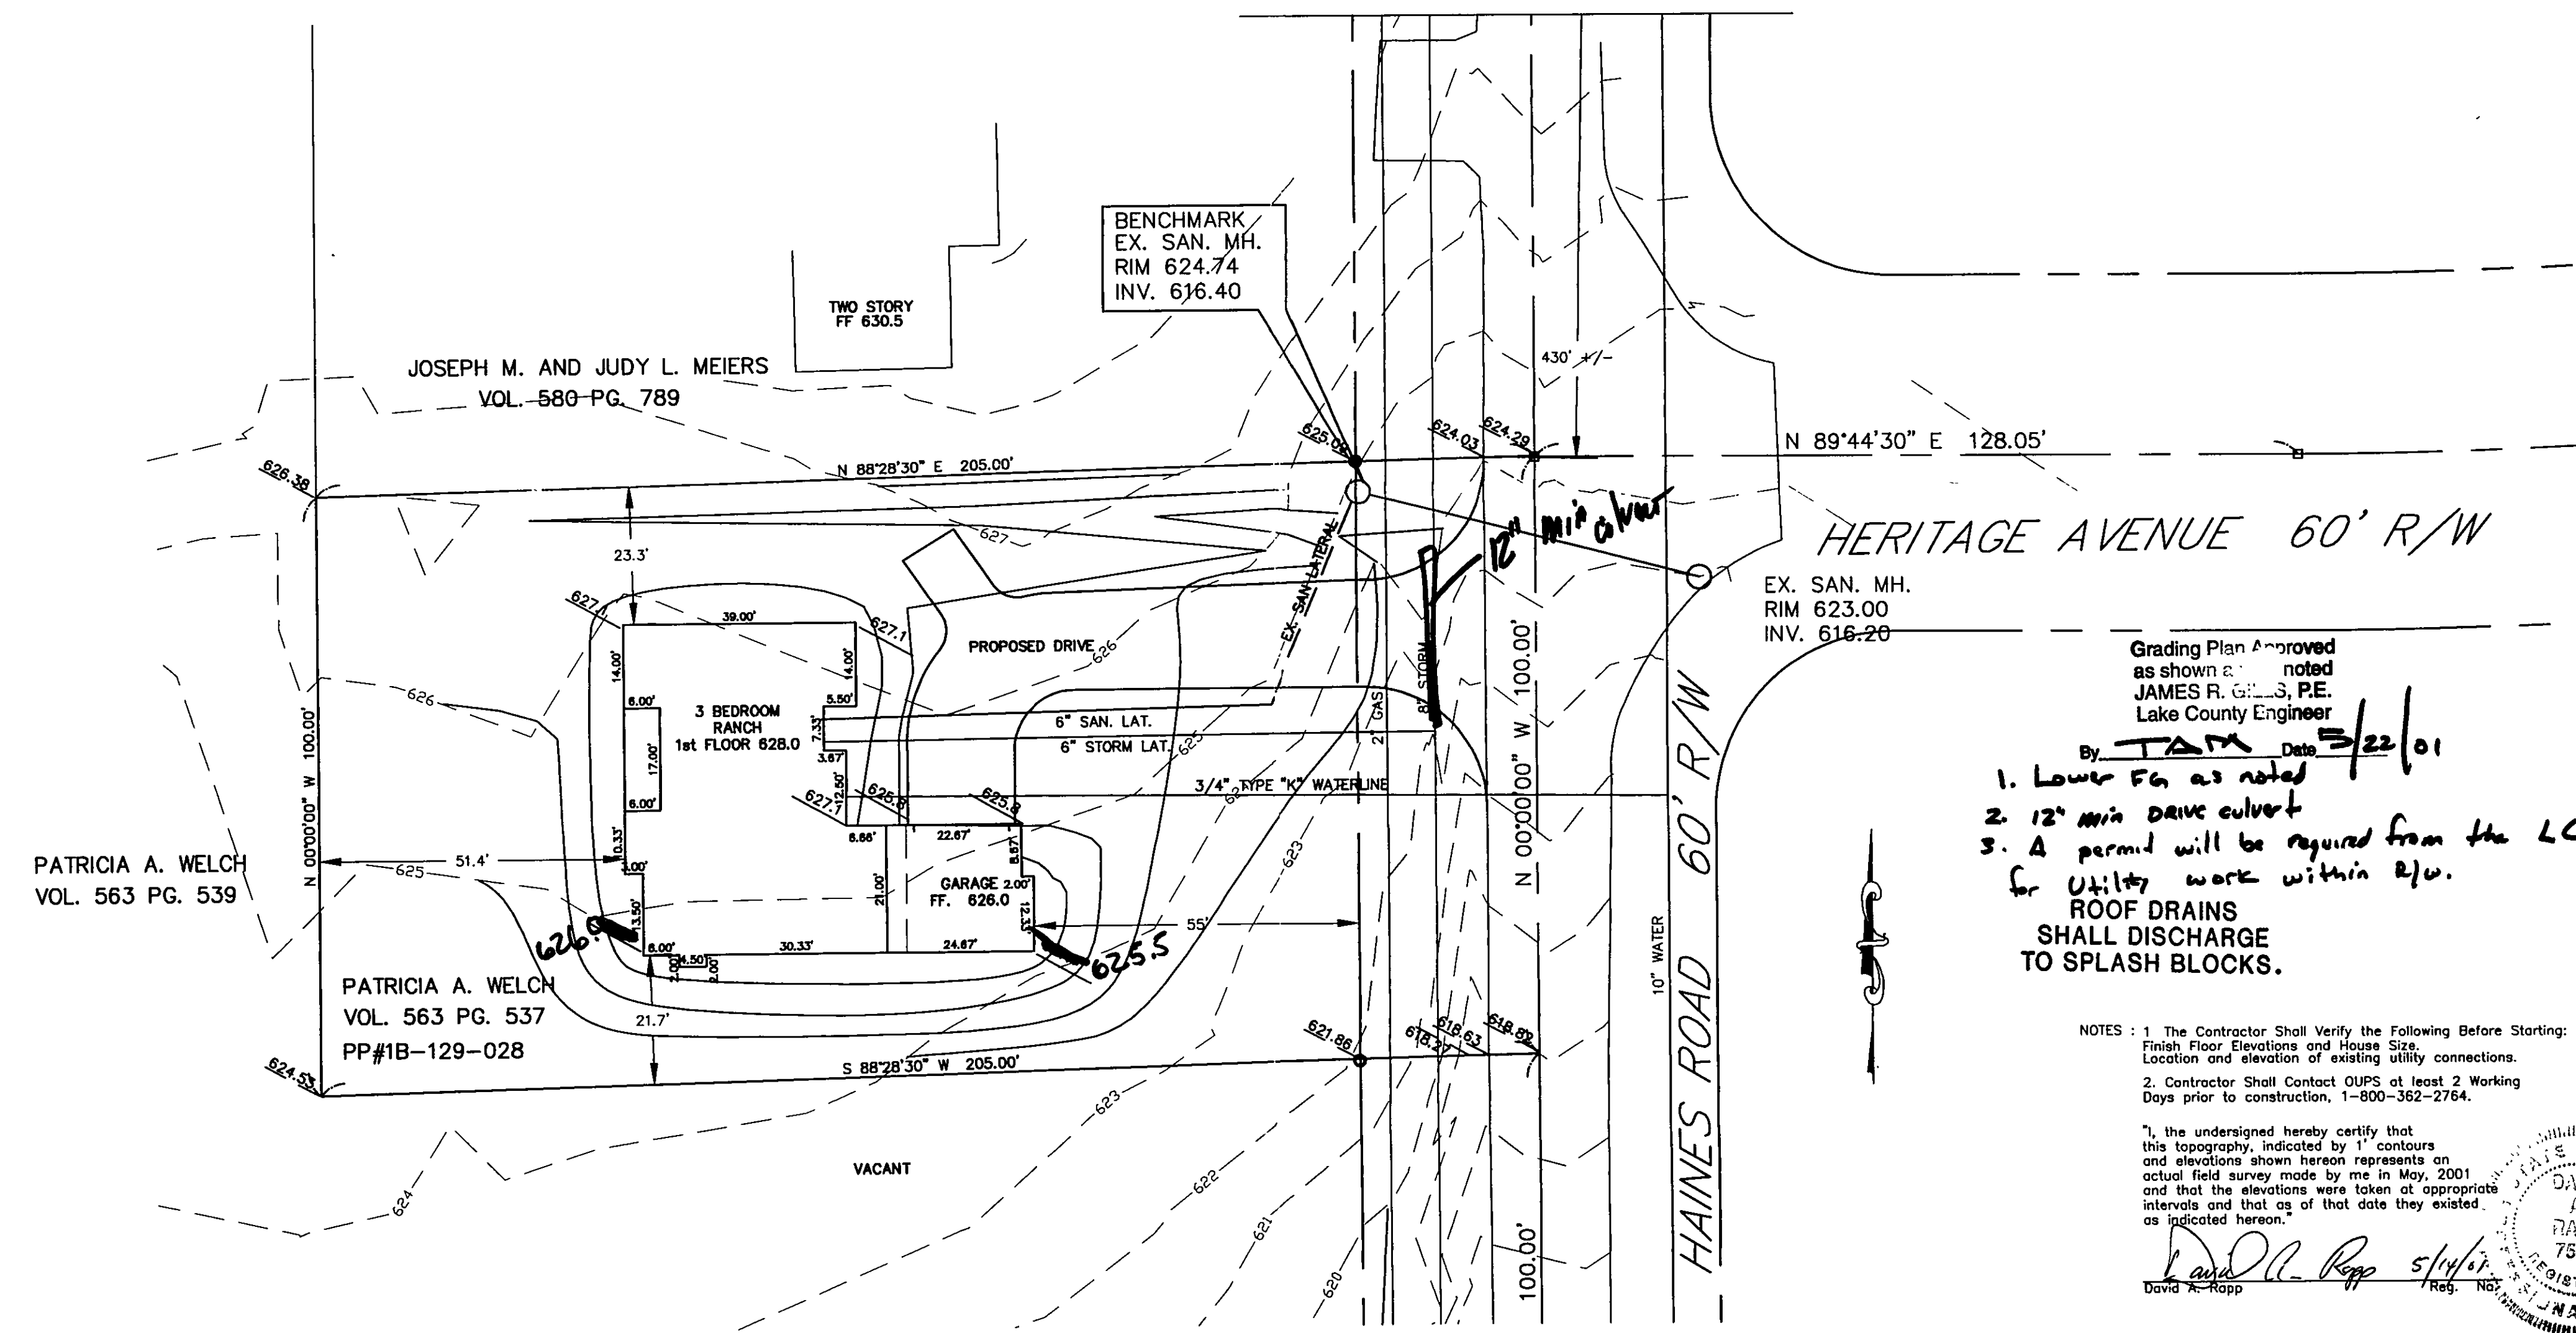


HERITAGE AVENUE 60' R/W
CHapel Rd

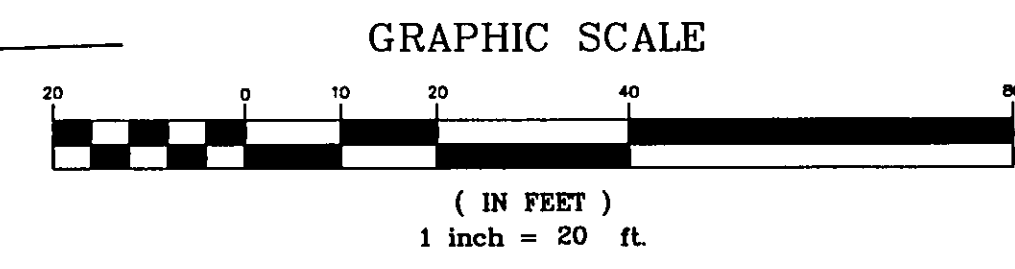

Grading Plan Approved
as shown and noted
JAMES R. GILLES, P.E.
Lake County Engineer

- By TAM Date 5/22/01
1. Lower Fg as noted
 2. 12" min drive culvert
 3. A permit will be required from the LCE for utility work within R/W.
- ROOF DRAINS
SHALL DISCHARGE
TO SPLASH BLOCKS.

NOTES : 1. The Contractor Shall Verify the Following Before Starting:
Finish Floor Elevations and House Size.
Location and elevation of existing utility connections.
2. Contractor Shall Contact OUPS at least 2 Working Days prior to construction, 1-800-362-2764.

"I, the undersigned hereby certify that this topography, indicated by 1' contours and elevations shown hereon represents an actual field survey made by me in May, 2001 and that the elevations were taken at appropriate intervals and that as of that date they existed as indicated hereon."

David A. Rapp 5/14/01
David A. Rapp
REGISTERED PROFESSIONAL SURVEYOR
STATE OF OHIO
DAVID A. RAPP
7597

COR Consultants, Inc.
23 S. Forest Street Geneva, Ohio 44041
440-466-8085

DATE: MAY, 2001
DRAWN BY: DAR
CHECKED BY: RMO
APPROVED BY: DAR
P.S. No. 7597

DAVID WELCH
HAINES ROAD
MADISON TOWNSHIP

SITE PLAN

APPROVED
MADISON TOWNSHIP ZONING
DATE 5/17/01
BY Jim 20493

Hor. Scale 1" = 20'	Vert. Scale
21066	
SHEET No. 1	OF 1