

Madison Township

RECEIVED MAY 22 1987

APPROVED

MADISON TWP. ZONING

Permit: 12075

Zoning Inspector: *[Signature]*

SITE PLAN

Madison Township, Lake County, Ohio

for: *SEENA BUILDERS*

CLIENT: *SEENA BUILDERS*

OWNER: *SEENA BUILDERS*

ADDRESS: *40 Boulder Lane W. Painesville*

CITY: *PAINESVILLE*

STATE: *OHIO*

ZIP: *44060*

Subdivision: *Boulder Hill Sub.*
Subdivision: *0-2-3*
Volume: *4*
Permit: *12075*
Parcel No.: *40*

LEGEND

SANITARY MANHOLE
STORM MANHOLE
INLET OR CATCH BASIN
HYDRANT
EXISTING CONTOURS
PROPOSED CONTOURS
EXIST. ELEV. 100.0
PROP. ELEV. 100.0

REMARKS

ALL BOUNDARY DATA SHOWN WAS OBTAINED FROM (IDEEDS, RECORDED SUBDIVISION PLAT OR OTHER PUBLIC RECORDS)
LOCATIONS AS SHOWN OF ADJACENT WELLS AND SEPTIC TANKS OBTAINED FROM LAKE COUNTY HEALTH DEPARTMENT

DESIGN CERTIFICATION

THIS PLAT WAS PREPARED BY ME, AND IS CORRECT TO THE BEST OF MY KNOWLEDGE AND BELIEF.

NAME: *HARRY S. JONES JR.* SURVEYOR REGISTRATION NO. *50343*

CHECK LIST

NO. OF BEDROOMS
DIMENSIONS
DISTANCE TO NEAREST STREET
SUBLOT NO. PARCEL NO.
BLDG. DIMENSIONS FIN. GR.
BLDG. TIES FLR. GRADES
APRON TYPE WIDTH THICKNESS
SIDEWALK TYPE WIDTH THICKNESS
CULVERT TYPE DIA. LENGTH
ROCK OUTCROPPINGS

PLAN PREPARED BY:

BABCOCK • JONES & ASSOCIATES, INC.

PAINESVILLE, OHIO

NO.	DATE	BY
1		
2		
3		
4		
5		


"AS BUILT" CERTIFICATION

I, HEREBY CERTIFY THAT THE CIRCLED GRADES ARE EXISTING FINISH GRADES CHECKED IN THE FIELD ON *19* AND ARE CORRECT TO THE BEST OF MY KNOWLEDGE AND BELIEF.

REGISTERED SURVEYOR

REG. NO.

T.B.M. - T.S.F.H. -
E2ED - 100.00

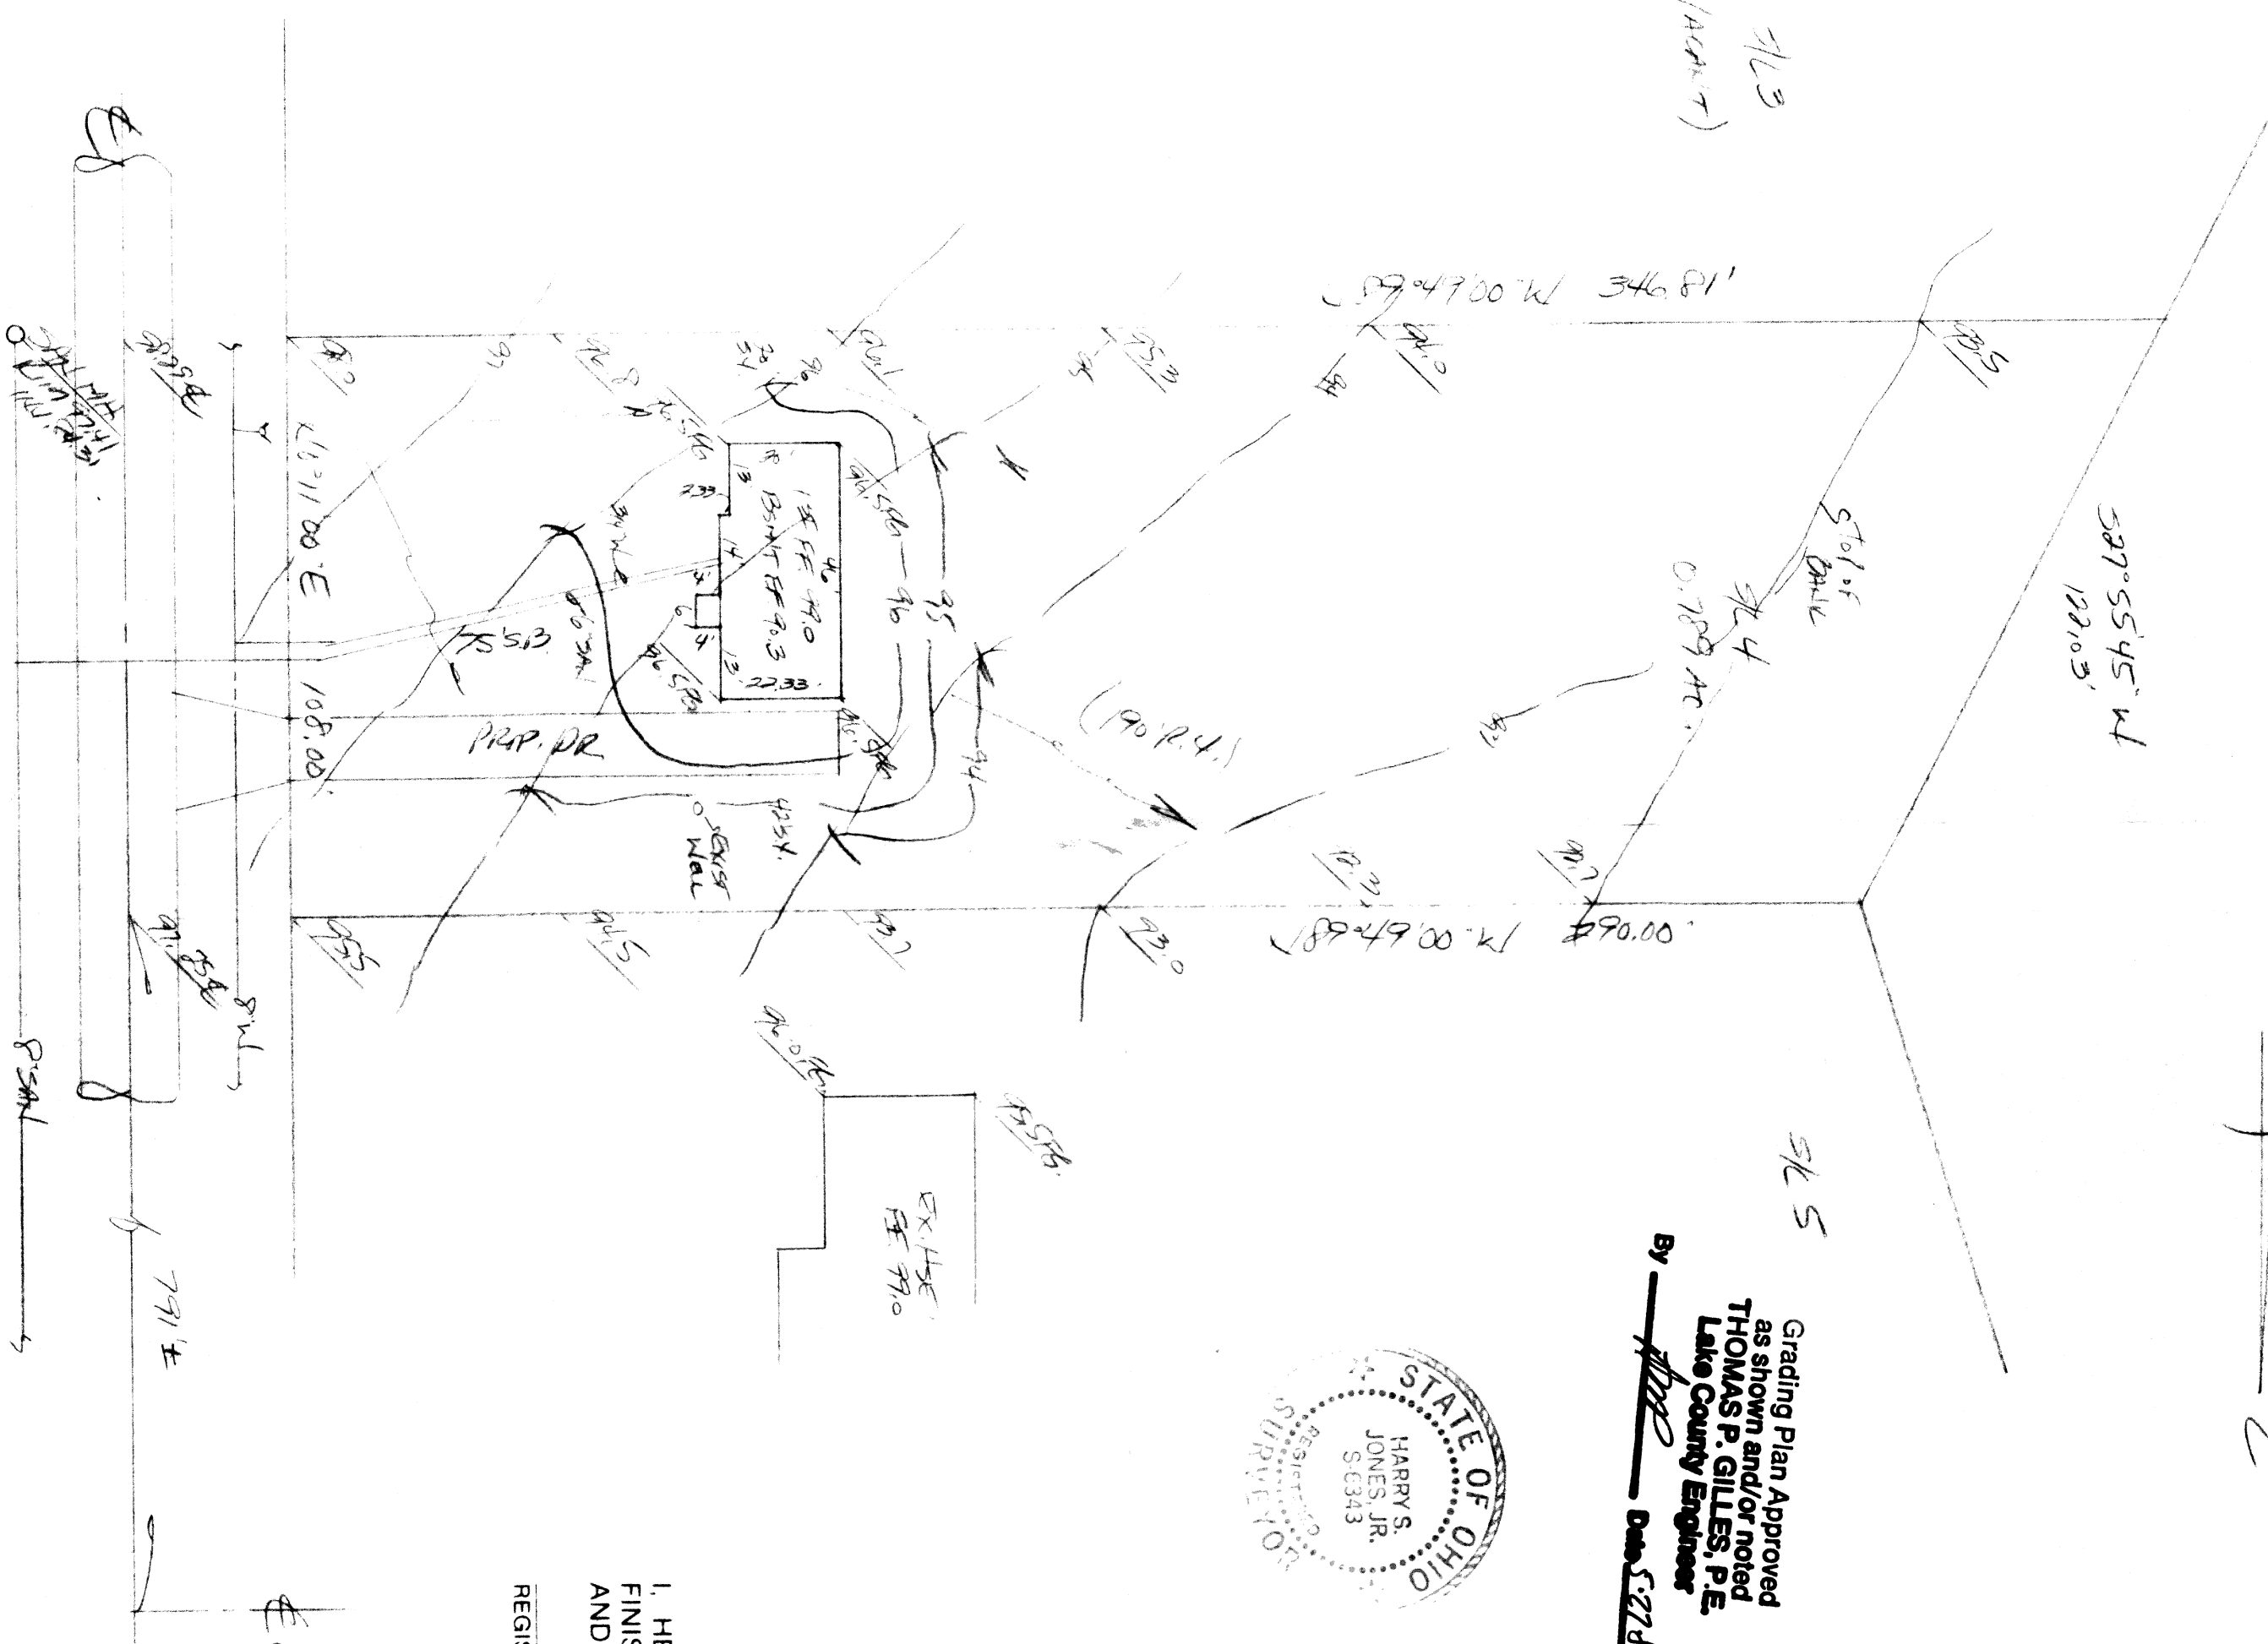

PAINES ROAD - 60'