

CRABBS'
SURVEYING
SERVICE

WESTERN RESERVE BUILDING
70 NORTH ST., CLAIR STREET SUITE 300
PANESVILLE, OHIO 44027
PHONE: (216) 357-5941
FAX: (216) 357-486
1-800-488-3968


72 S. CHESTNUT STREET
JEFFERSON, OHIO 44027
PHONE (216) 576-3488
FAX (216) 576-3511

JOB #1284

LEGEND


- P.K. IN/L. WITH SPKER SET
- IRON PIN MONUMENT
- IRON PIPE
- ⊕ MONUMENT BOX
- ⊕ UTILITY POLE
- RUNOFF DIRECTION

PROPOSED SITE PLAN FOR:
BILL BARBIS
2 STORY FRAME DWELLING
835 SQ. FEET

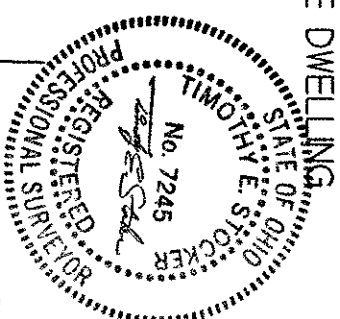

LAKEVIEW AVENUE

HAYWOOD AVENUE

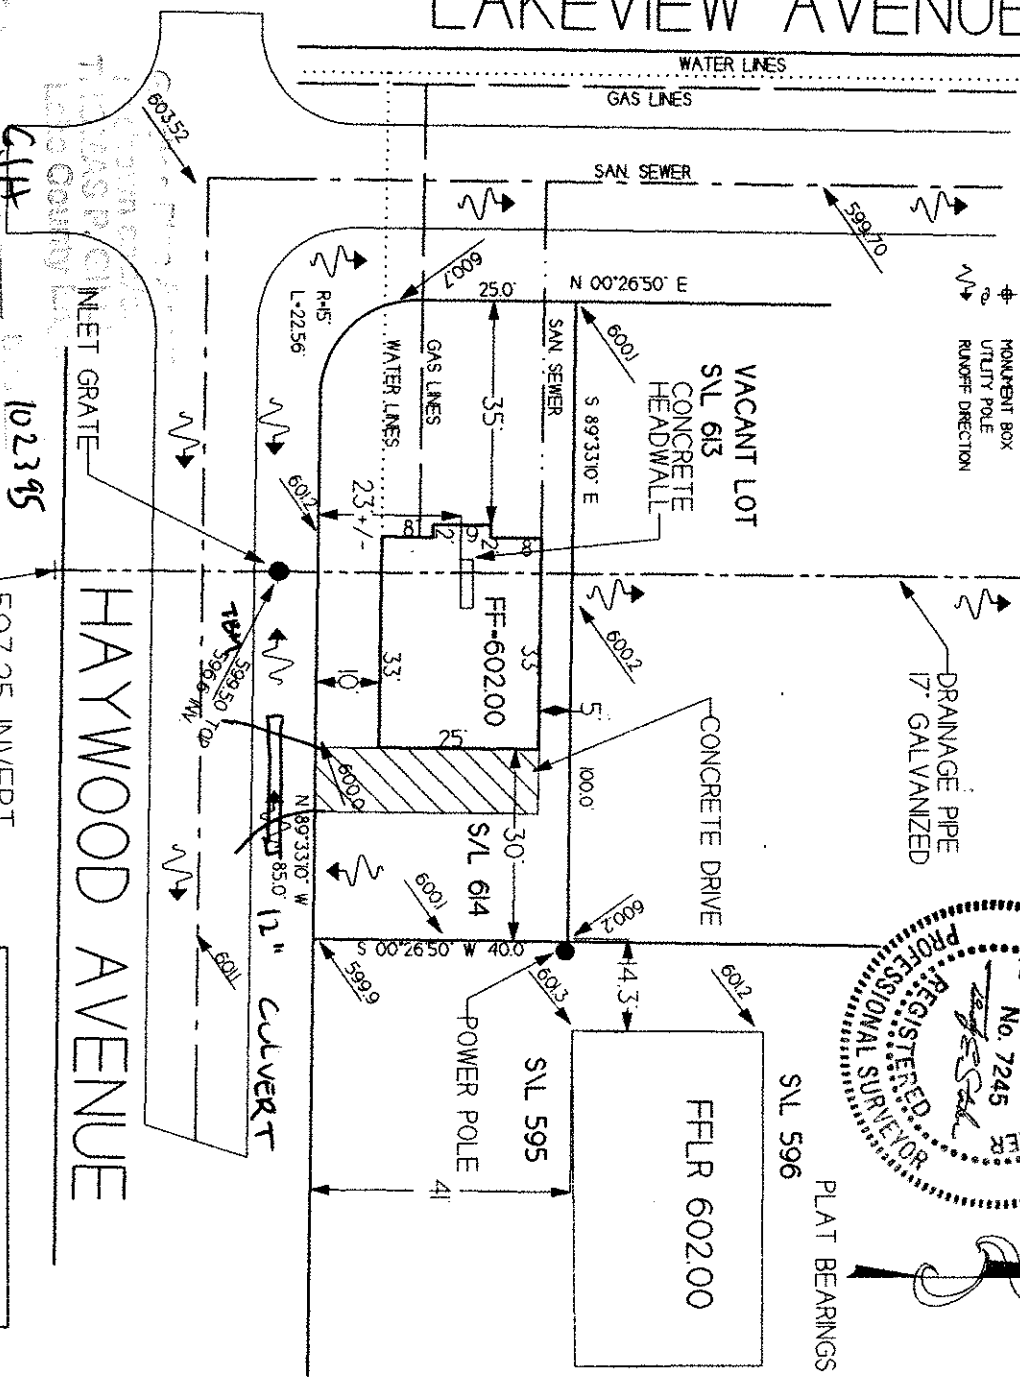


APPROVED
MADISON TOWNSHIP ZONING

#1517	30' R/W
#1487	26' R/W
#1479	30' R/W
#6600	30' R/W

OCT 19 1995

SCALE 1 INCH = THIRTY FEET

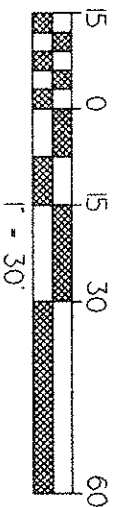

S/L 614 IN THE MADISON LAKELAND
TOWNSHIP OF MADISON
COUNTY OF LAKE
STATE OF OHIO
PLAT VOL. D PAGE 52

THIS SURVEY WAS PERFORMED TO
AN ACCURACY SET FORTH IN THE
OHIO ADMINISTRATIVE CODE
4733.37 AND ALTA SUBURBAN
ACCURACY

COPYRIGHT 1995 CRABBS' SURVEYING SERVICE
ORDER AS SAVED 1284PLOT
SEPTEMBER 1995
REVISED OCTOBER 1995