


BENCHMARK:
HYDRANT TOP STEM
ELEV. 628.75


CURVE DATA @ R/W
① $A = 12.86'$
 $\Delta = 120^\circ 26'$
 $L = 12.86'$
 $N. 88^\circ 45' 33" E.$

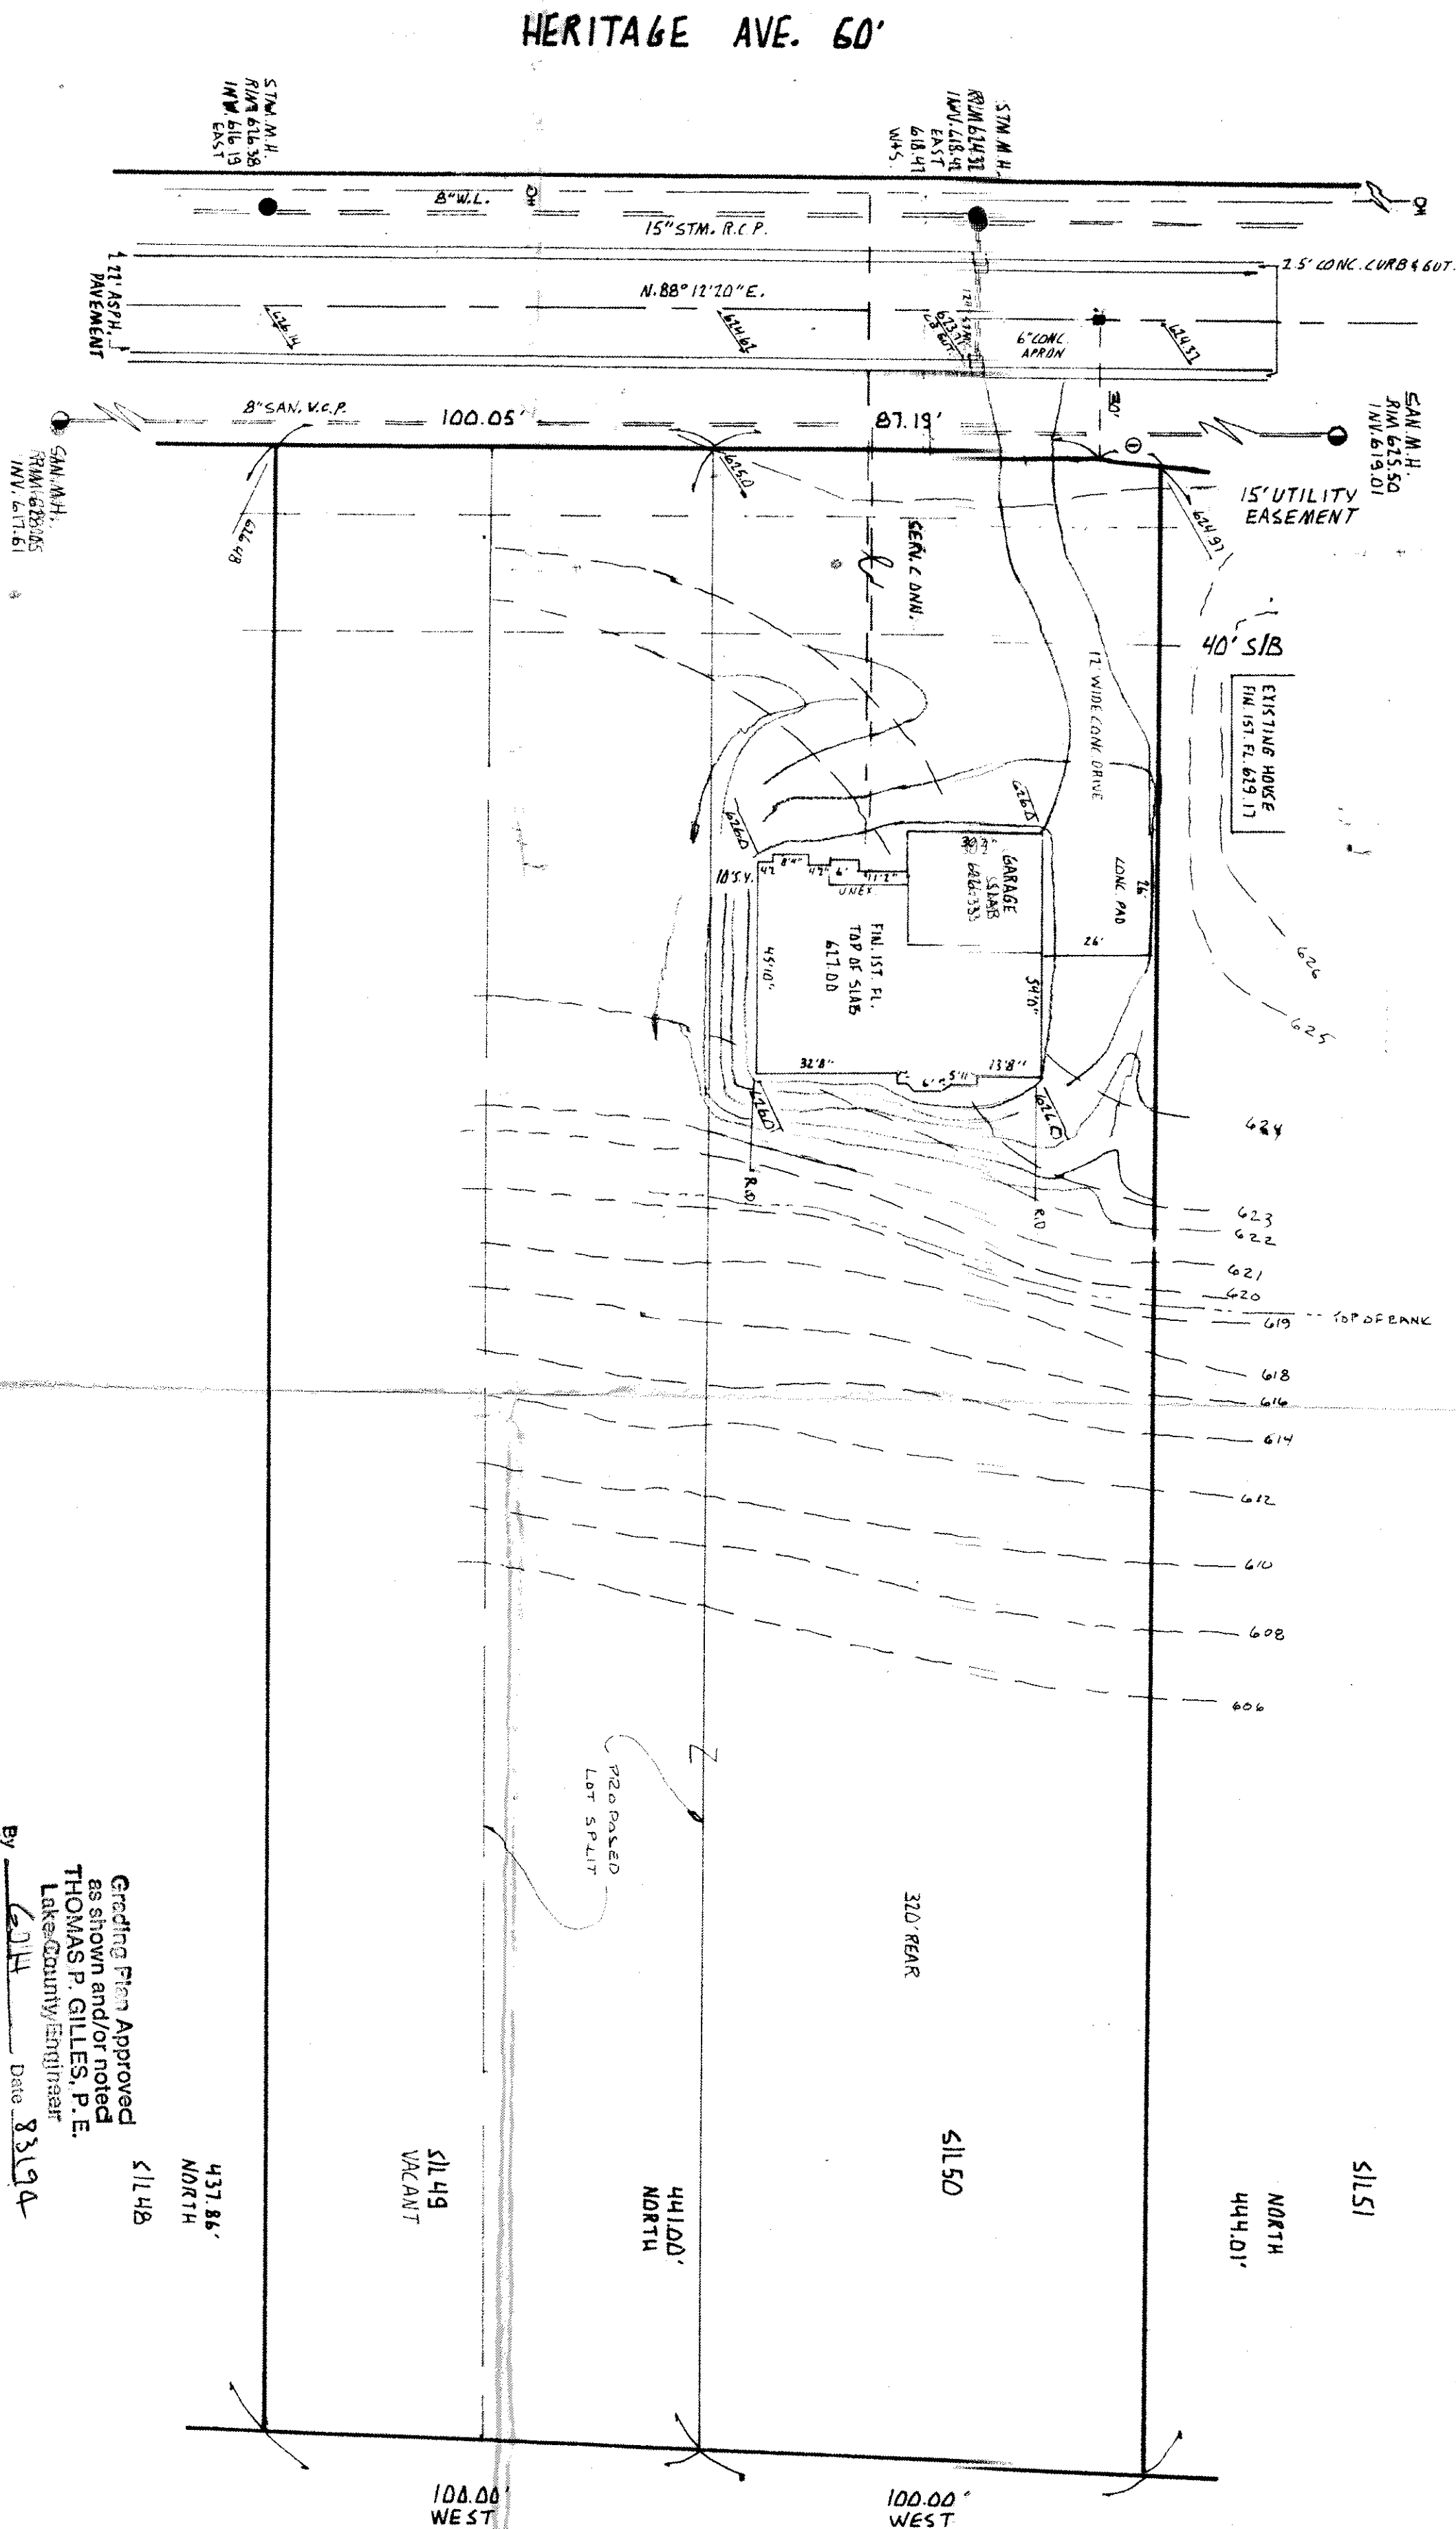

NORTH
APPROVED
TWP. ENGINEER
AUG 31 1994
THOMAS P. GILLES
LAKE COUNTY ENGINEER

Grading Plan Approved
as shown and/or noted
THOMAS P. GILLES, P.E.
Lake County Engineer
By COH Date 8/31/94
CONJUGENT UPON LOT SPLIT

ROOF DRAINS
SHALL DISCHARGE
TO SPLASH BLOCKS.

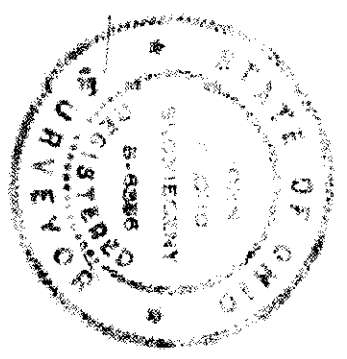

I CERTIFY THAT THIS PLAN
WAS PREPARED BY ME AND
IS CORRECT TO THE BEST OF
MY KNOWLEDGE AND BELIEF.
JOHN SADNIECZNY
7739 VEWAMOUNT DR
PAINESVILLE, OHIO 44077
P. 330-1144

SITE PLAN FOR:		HOMES BY SIMMONS	
SCALE: 1" = 30'	APPROVED BY:	DRAWN BY: DTS	
DATE: AUG. 94			
BEING SUBLOTS 49+50 IN THE HERITAGE HILL ESTATES TOWNSHIP OF MADISON - COUNTY OF LAKE - STATE OF OHIO			
JOB # 94-1915		DRAWING NUMBER 94-1304	