


Grading Plan Approved
as shown and/or noted
THOMAS P. GILLEY, P.E.
Lake County Engineer

By APP Date 3-4-86

- NOTE ① MAINTAIN EXISTING SWALES.
② PERMITS REQ'D FOR WORK WITHIN R/W.
③ NO OPEN CUT OF PAVEMENT.
④ 12" MIN. DRIVE PILE

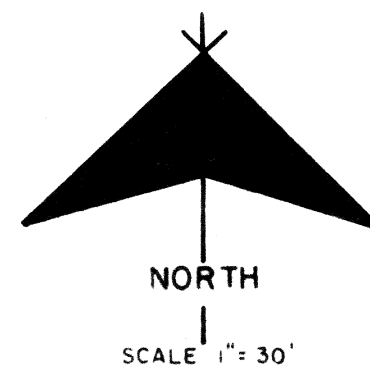

SITE PLAN

MADISON TOWNSHIP LAKE COUNTY, OHIO

for: JOHN MORGAN CLIENT OWNER
35843 MATOMA DR. EASTLAKE OH 44094
ADDRESS STREET CITY ZIP

MADISON-ON-THE-LAKE	LOT	TRACT
SUBDIVISION G-66 NAME	VOLUME	PAGE
56,7,8,10,312 VOL.-PG. S.W. CORNER	PERM. PARCEL NO.	STREET
SUBLOT NO. MAGNOLIA & HUBBARD		

LEGEND

SANITARY MANHOLE	---●---	WATER VALVE (GAS)	---+---
STORM MANHOLE	---●---	WATER METER (GAS)	---+---
INLET OR CATCH BASIN	---●---	AS BUILT ELEVATION	100.0
HYDRANT	---●---	INDICATES DIRECTION OF SURFACE DRAINAGE	100.0
EXISTING CONTOURS	---●---		
PROPOSED CONTOURS	---●---		
EXIST. ELEV.	100.0	PROP. ELEV.	100.0

REMARKS

ALL BOUNDARY DATA SHOWN WAS OBTAINED FROM (DEEDS, RECORDED SUBDIVISION PLAT OR OTHER PUBLIC RECORDS)
LOCATIONS AS SHOWN OF ADJACENT WELLS AND SEPTIC TANKS OBTAINED FROM LAKE COUNTY HEALTH DEPARTMENT

DESIGN CERTIFICATION

THIS PLAT WAS PREPARED BY ME, AND IS CORRECT TO THE BEST OF MY KNOWLEDGE AND BELIEF.

NAME SURVEYOR REGISTRATION NO. 4574

CHECK LIST

NO. OF BEDROOMS	WATER MAIN SIZE, LOCATION
DIMENSIONS	SAN. SEWER SIZE % GR. LOC.
BEARINGS	SAN. MH. CAST. ELEV. INV. ELEV.
TIE TO NEAREST STREET	SAN. CONN. SIZE, LOC. DEPTH
SUBLOT NO. PARCEL NO.	STORM SEWER SIZE % GR. LOC.
SURROUNDING OWNERS	STORM MH. CAST. ELEV. INV. ELEV.
BLDG. DIMENSIONS FIN. GR.	PAV'T TYPE GRADE CURBS
BLDG. TIES FL'R. GRADES	GAS LINE LOC. SIZE PRESSURE
APRON TYPE WIDTH THICKNESS	SEPTIC TANK LOCATION & DUPLICATION AREA
SIDEWALK TYPE WIDTH THICKNESS	WELL LOCATION
CULVERT TYPE DIA., LENGTH	ISOLATION RADIUS FROM WELL
ROCK OUTCROPPINGS	

REVISIONS			PLAN PREPARED BY:		
NO.	DATE	BY	DEBEVEC • SALO & ASSOCIATES, INC.		
1			125 E. ERIE ST. PAINESVILLE, OHIO		
2			DRAWN BY W.M.	SCALE 1"=30'	PHONE NO. 352-9250
3			CHK'D.	DATE 2-28-86	DRAWING NO. 6429
4			CREW CHIEF	APP'D.	
5					

"AS BUILT" CERTIFICATION

I, HEREBY CERTIFY THAT THE CIRCLED GRADES ARE EXISTING FINISH GRADES CHECKED IN THE FIELD ON 19____, AND ARE CORRECT TO THE BEST OF MY KNOWLEDGE AND BELIEF.

REGISTERED SURVEYOR REG. NO.

APPROVED
MADISON TWP. ZONING
Permit: 11762
Zoning Inspector: [Signature]