


Spring #1840

NOTE:
NO CURB, GUTTER
OR DITCH AT EDGE
OF PAV'T.
NO DRIVE PIPES
ON STREET


PROPOSED
CONTOUR
EXISTING
CONTOUR

EXIST SAN "Y" FOR
LOT 146 IS 79.4'
WEST OF SAN M.H.
DOWN. APPROX. 5 1/2'
KEEP.

JIM PETER
AND SURVEY
759 CROSBY-LOOK
HOME, O.

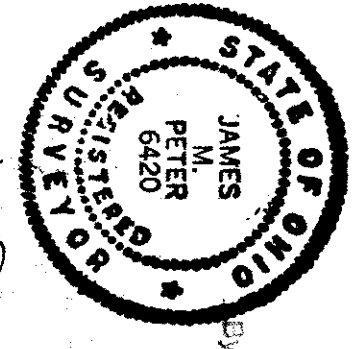

REVISION 12/29/88
CHANGE CONTOUR
REVISIONS 5/1/86

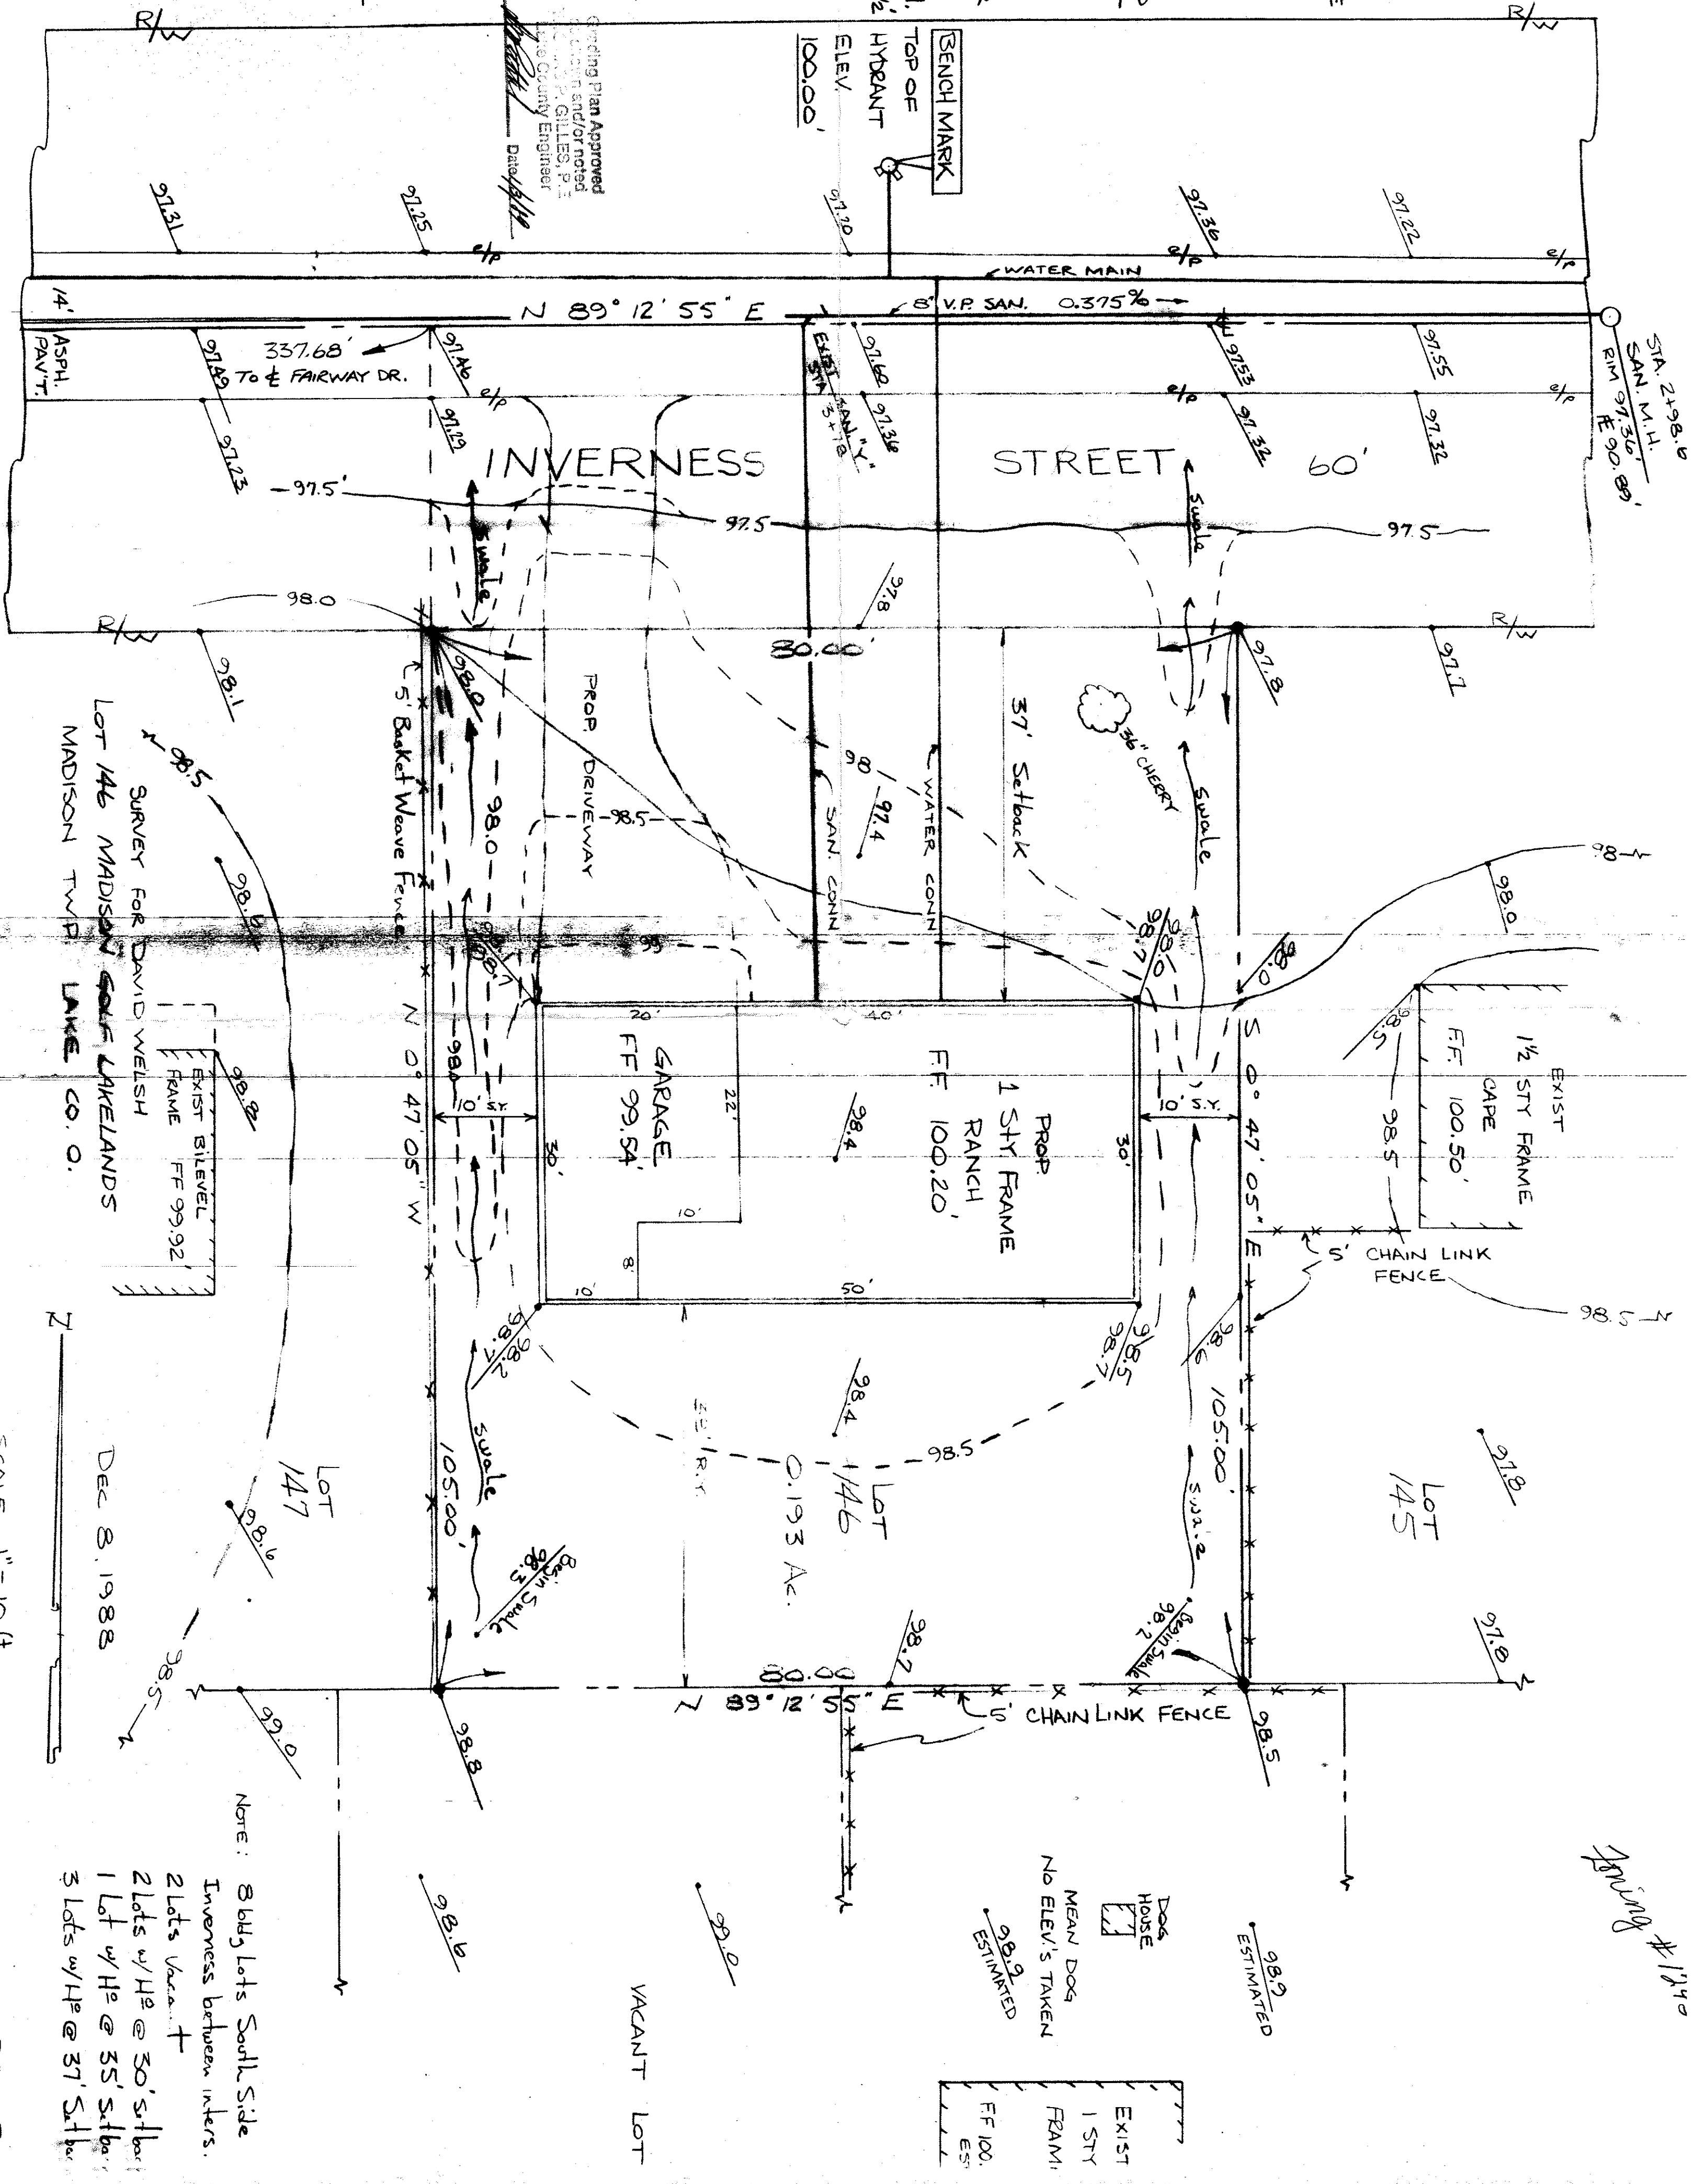

SCALE 1"=10 ft.

881103