



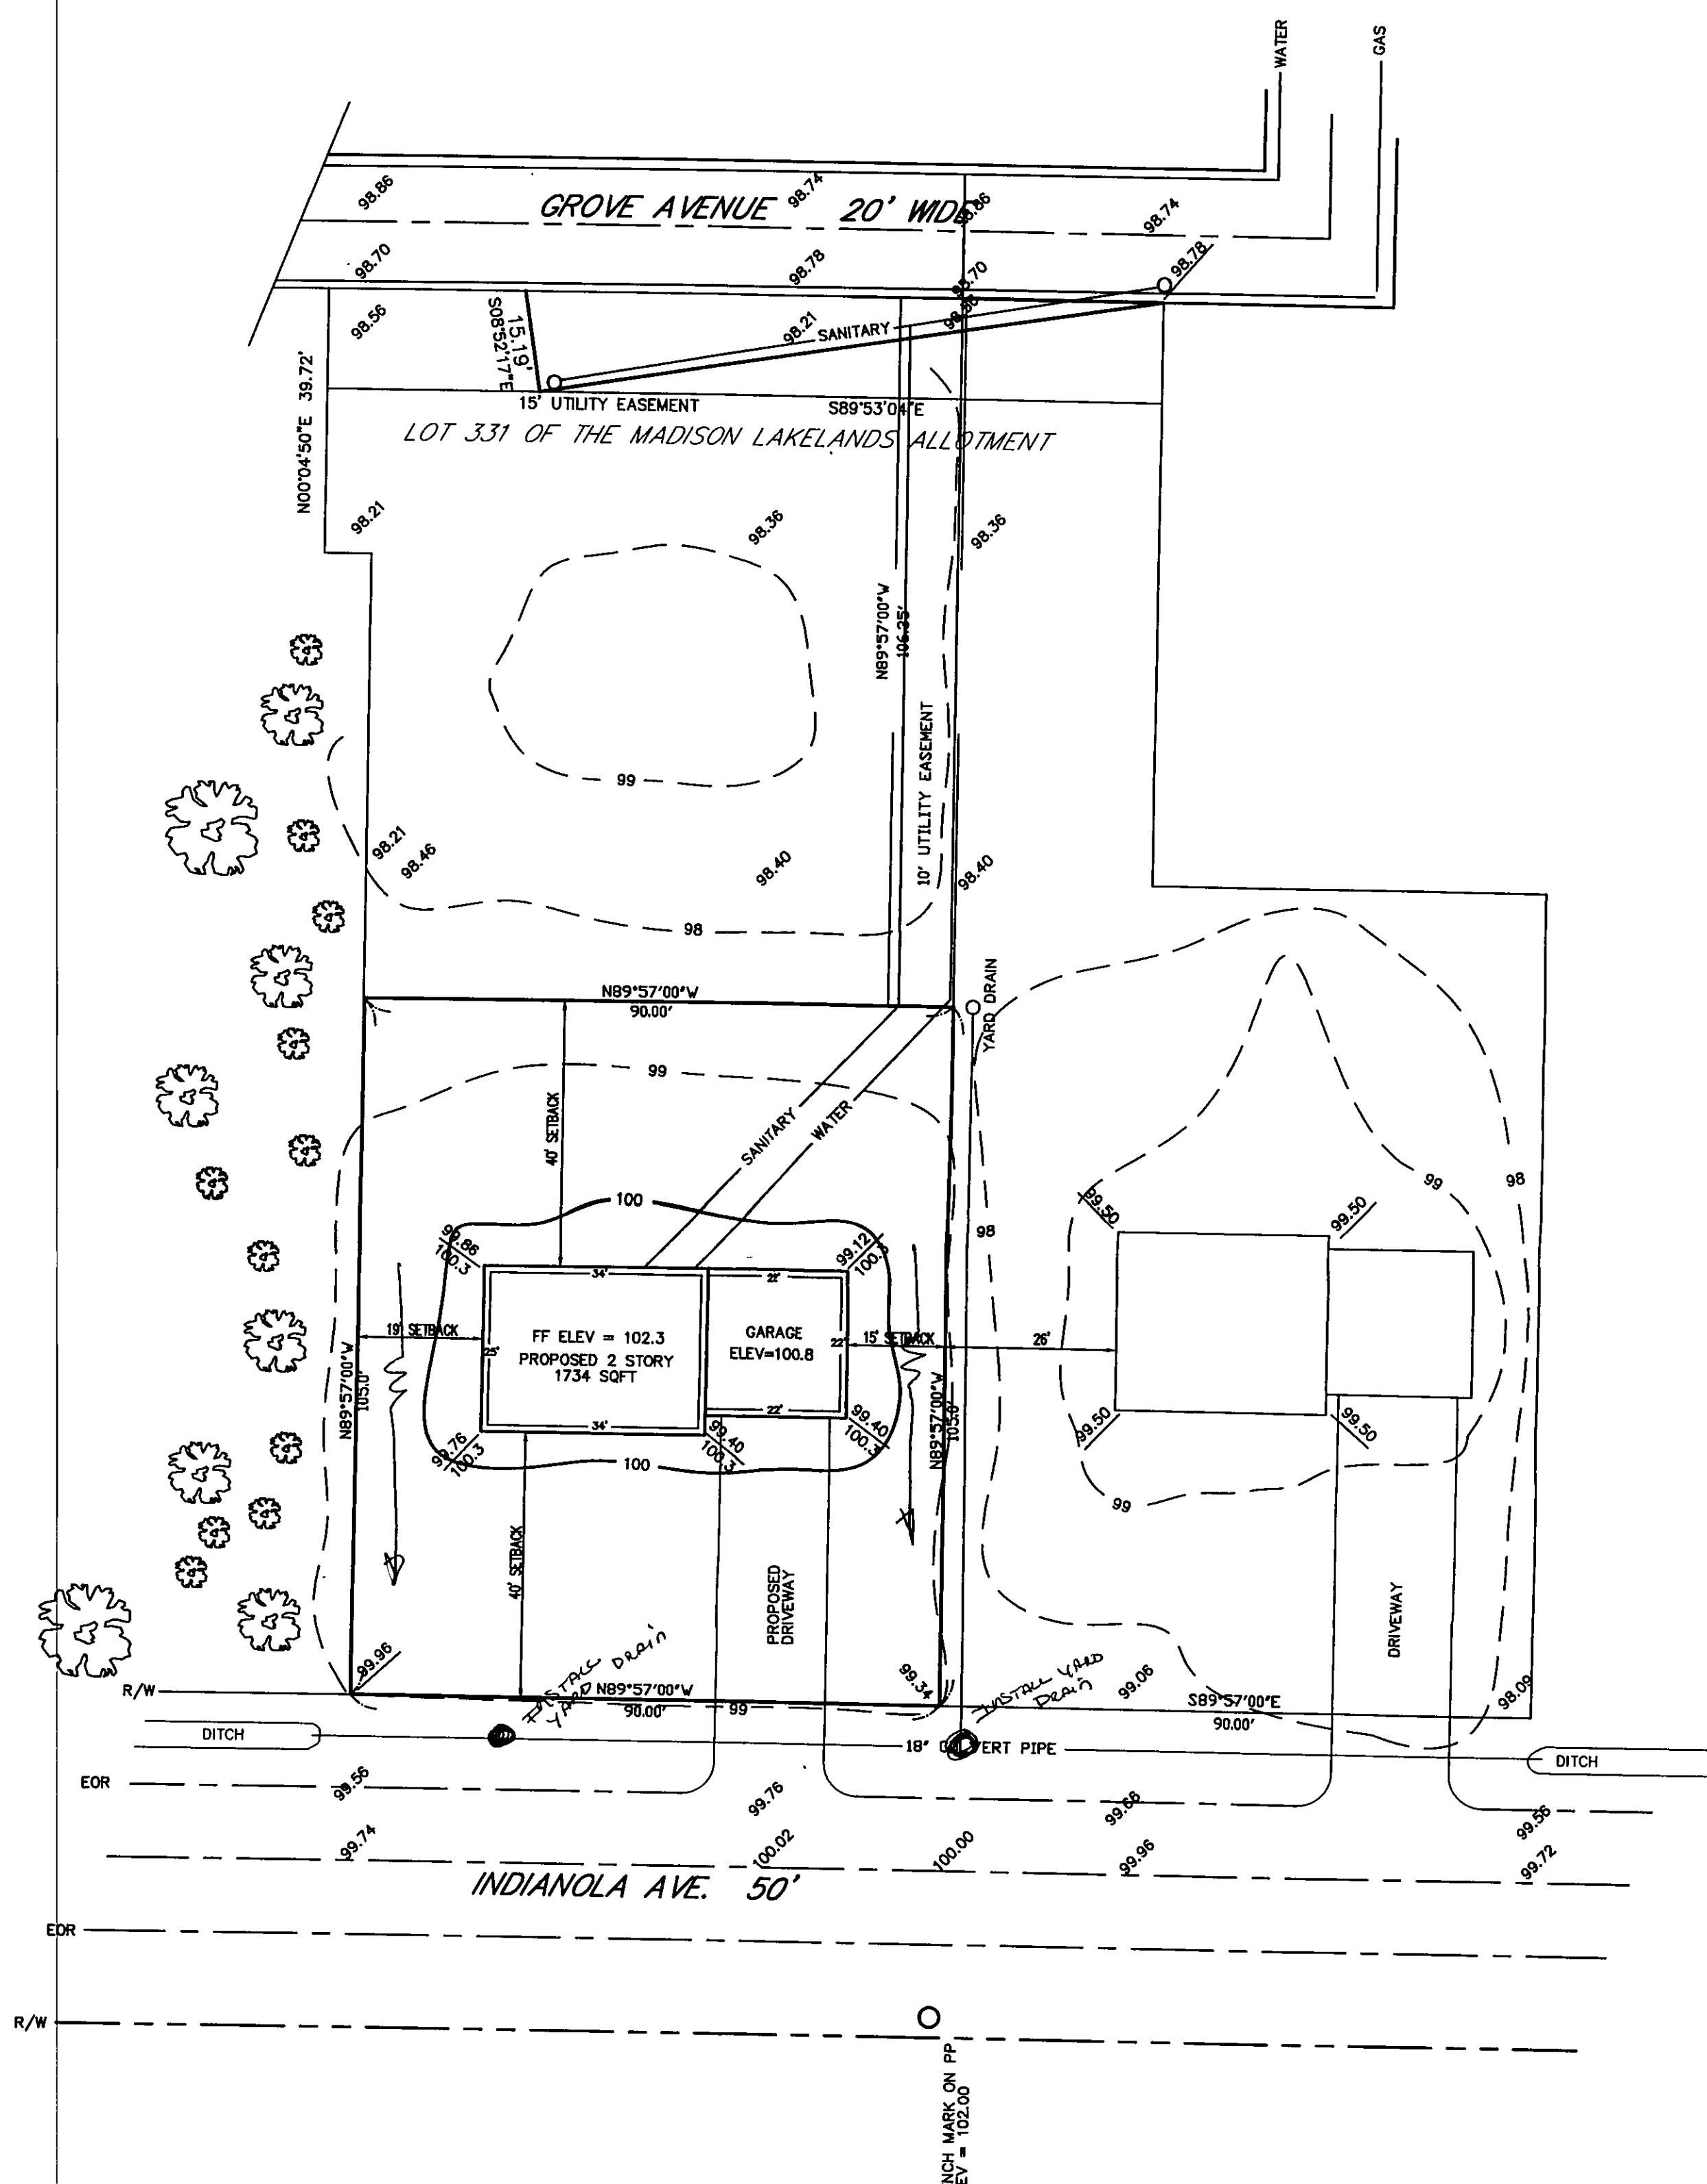

2 WORKING DAYS
BEFORE YOU DIG
CALL 800-362-2764
TOLL FREE
OHIO UTILITIES PROTECTION SERVICE

1. The Contractor Shall Verify the Following Before Starting:
Finish Floor Elevations and House Size.
Location and Elevation of Existing Utility Connections.
2. Contractor Shall Contact OUPS at least 2 Working Days Prior to Construction. 1-800-362-2764.

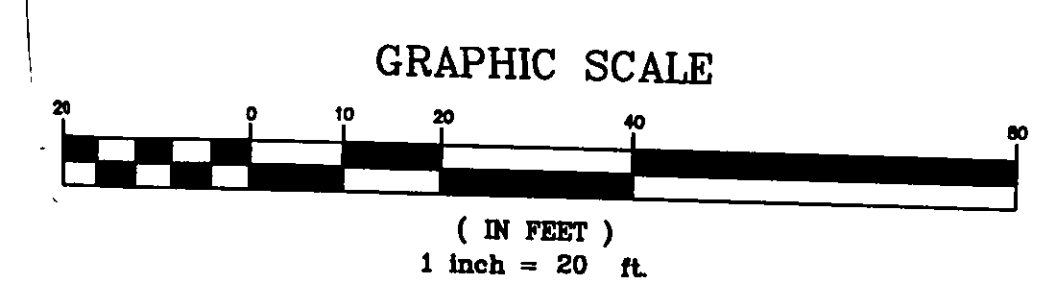


"I, the undersigned hereby certify that this topography, indicated by 1' contours and the elevations shown hereon represents an actual field survey made in March, 2000 and that the elevations were taken at appropriate intervals and that as of that date they existed as indicated hereon."

APPROVED
MADISON TOWNSHIP ZONING
DATE 4/30/2000
BY David A. Rapp
Date 4-30-2000

Grading Plan Approved
as shown and/or noted
THOMAS P. GILLES, P.E.
Lake County Engineer
By TAM Date 3/1/2000

COR Consultants, Inc.
23 S. Forest St. Geneva, Ohio 44041 440-466-8085

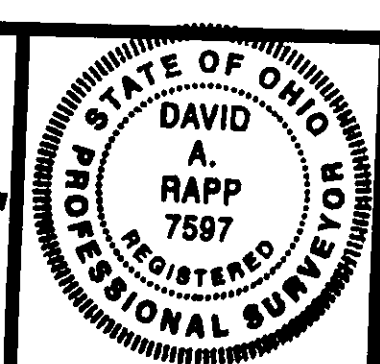

DATE: APRIL 29, 2000
DRAWN BY: RMO
CHECKED BY: DAR
APPROVED BY: DAR
PS No. 7597

CHUCK WELSH
5965 N. RIDGE RD.
MADISON, OHIO 44057

6511 INDIANOLA DR.

Hor. Scale	Vert. Scale
CONTRACT No. 20065	
SHEET No. 1	OF 1