


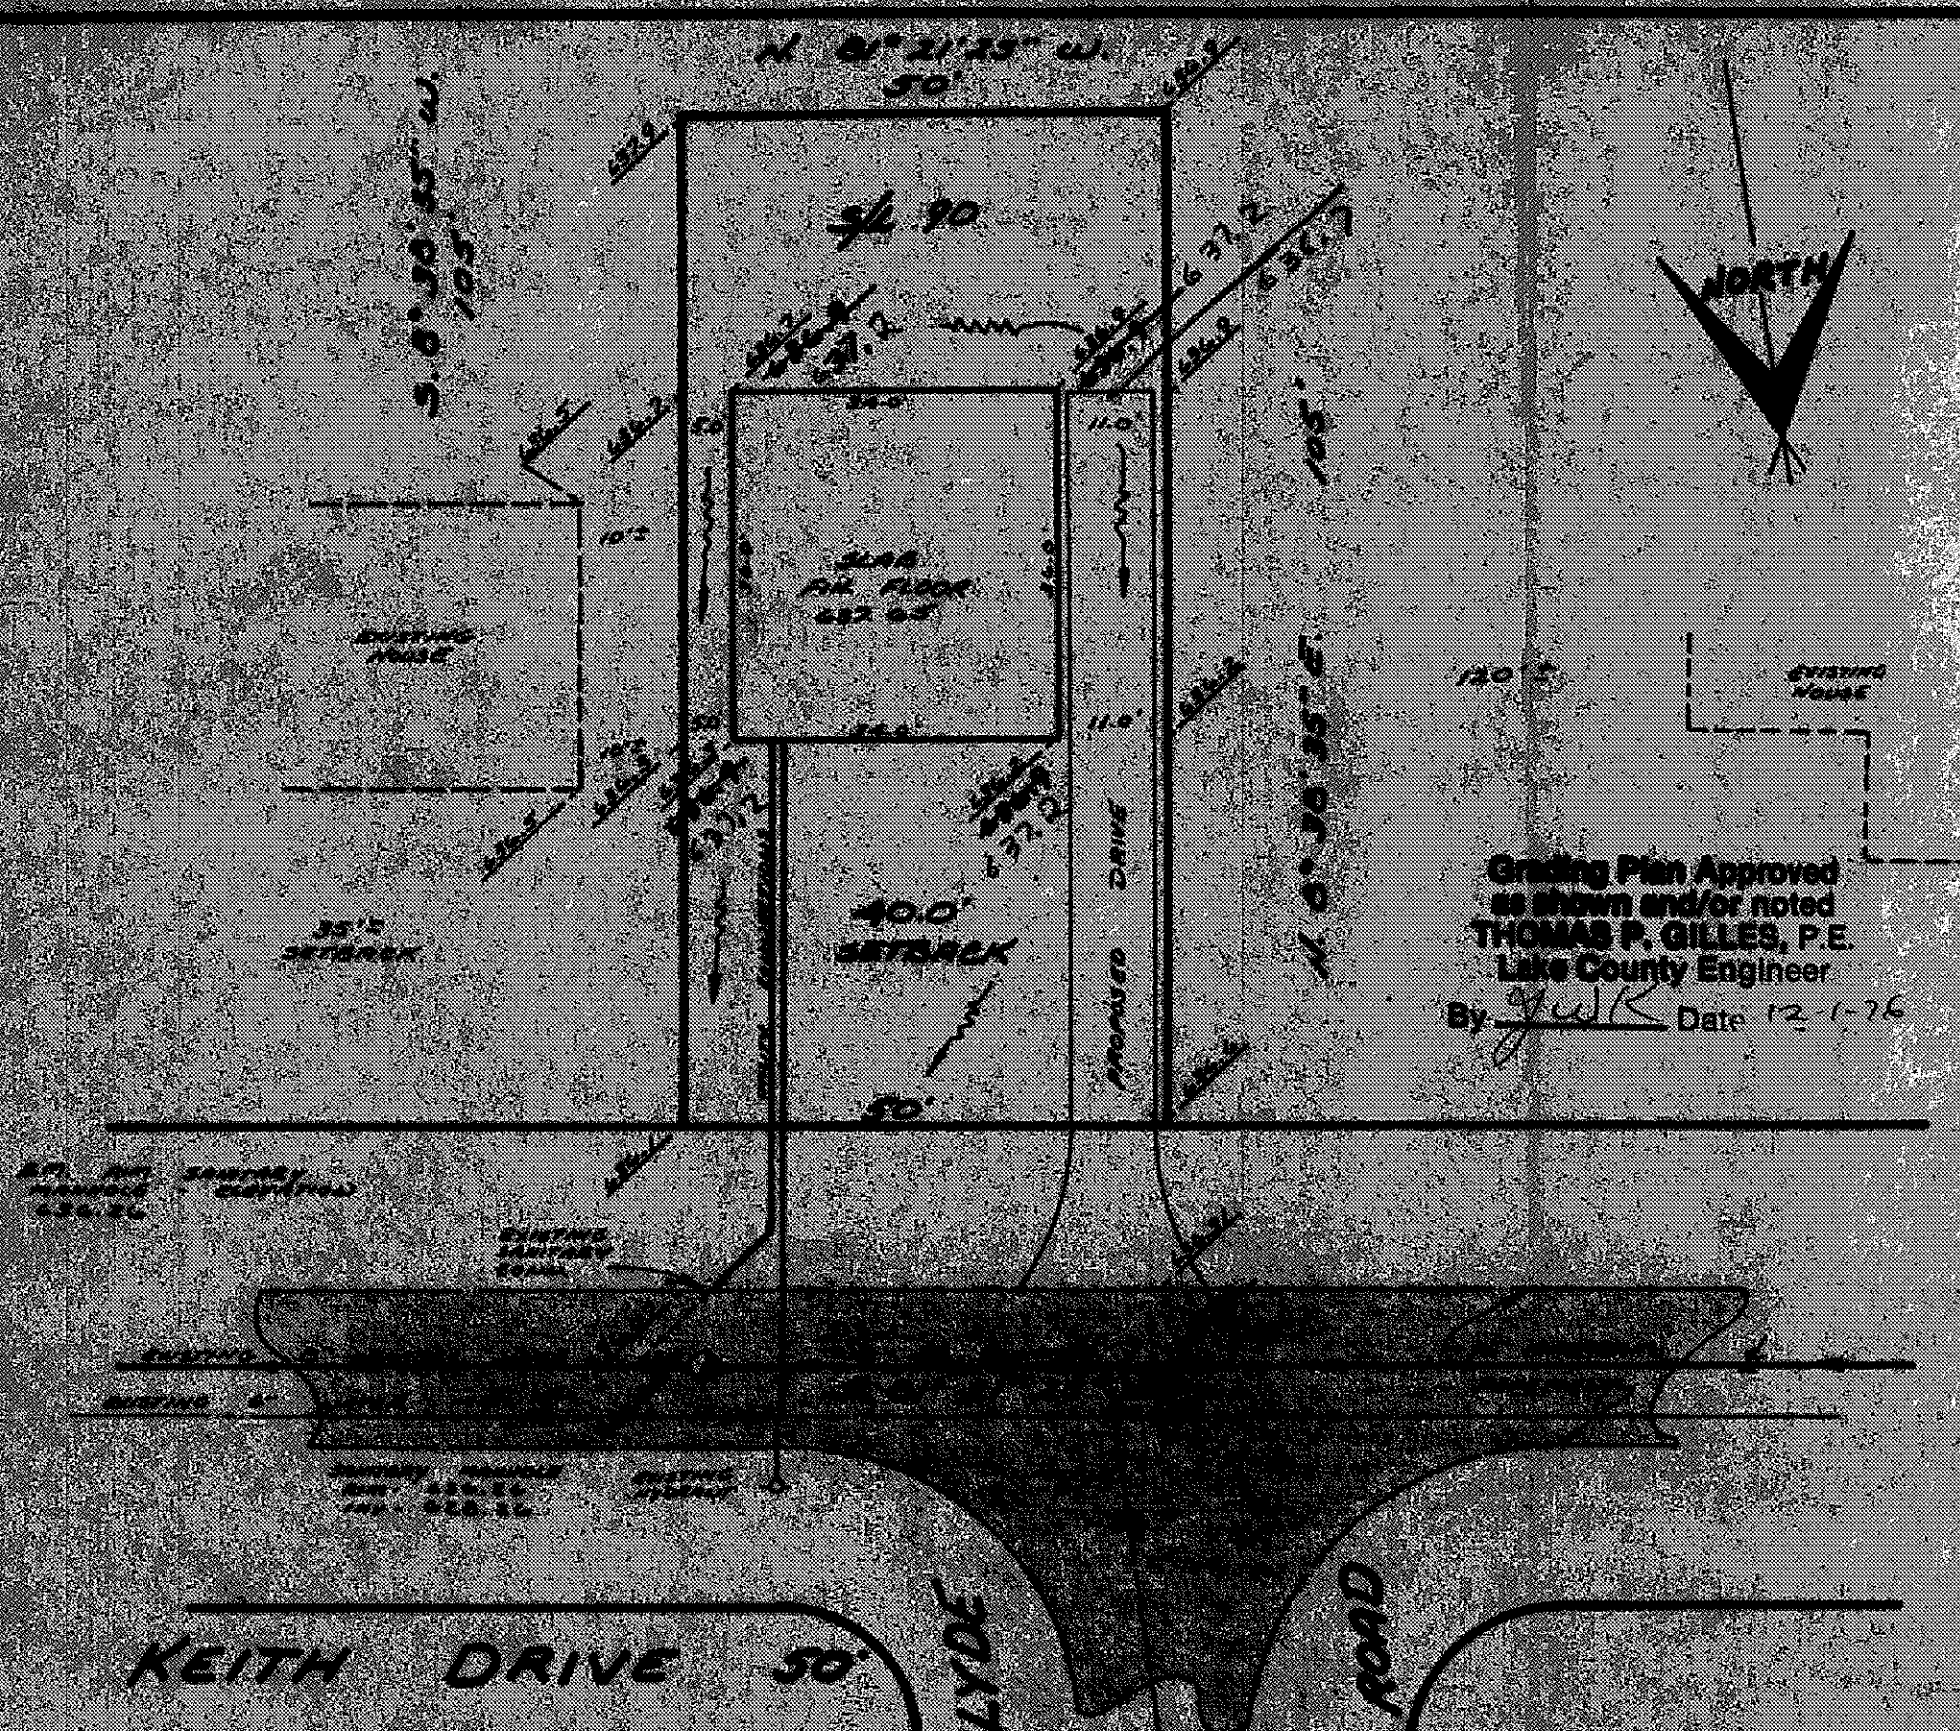

Grading Plan Approved
as shown and/or noted
THOMAS P. GILLES, P.E.
Lake County Engineer
By JWK Date 12-1-76

SITE PLAN

MADISON TOWNSHIP LAKE COUNTY, OHIO

for: NORTHERN INDUSTRIES CLIENT OWNER

ADDRESS	STREET	CITY	ZIP
<u>MADISON GOLF LINKS</u>	<u>LOT</u>	<u>TRAC</u>	<u>PAGE</u>
<u>90</u>	<u>KEITH</u>	<u>STREET</u>	<u>STREET</u>
SUBLOT NO.	STREET	PERM. PARCEL NO.	STREET

LEGEND

SANITARY MANHOLE STORM MANHOLE INLET OR CATCH BASIN HYDRANT EXISTING CONTOURS PROPOSED CONTOURS EXIST. ELEV. 100.0 PROP. ELEV.	WATER VALVE (GAS) WATER METER (GAS) AS BUILT ELEVATION INDICATES DIRECTION OF SURFACE DRAINAGE
---	---

REMARKS

ALL BOUNDARY DATA SHOWN WAS OBTAINED FROM (DEEDS, RECORDED SUBDIVISION PLAT OR OTHER PUBLIC RECORDS)

LOCATIONS AS SHOWN OF ADJACENT WELLS AND SEPTIC TANKS OBTAINED FROM LAKE COUNTY HEALTH DEPARTMENT

DESIGN CERTIFICATION

THIS PLAT WAS PREPARED BY ME, AND IS CORRECT TO THE BEST OF MY KNOWLEDGE AND BELIEF.

NAME Richard J. Debevec SURVEYOR REGISTRATION NO. 75-5244

CHECK LIST

NO. OF BEDROOMS DIMENSIONS BEARINGS TIE TO NEAREST STREET SUBLOT NO. PARCEL NO. SURROUNDING OWNERS BLDG. DIMENSIONS FIN. GR. BLDG. TIES FLR. GRADES APRON TYPE WIDTH THICKNESS SIDEWALK TYPE WIDTH THICKNESS CULVERT TYPE DIA. LENGTH ROCK OUTCROPPINGS	WATER MAIN SIZE, LOCATION SAN. SEWER SIZE & GR. LOC. SAN. MH. CAST ELEV. INV. ELEV. SAN. CONN. SIZE, LOC. DEPTH STORM SEWER SIZE & GR. LOC. STORM MH. CAST ELEV. INV. ELEV. PAV'T TYPE GRADE CURBS GAS LINE LOC. SIZE PRESSURE SEPTIC TANK LOCATION & DUPLICATION AREA WELL LOCATION ISOLATION RADIUS FROM WELL
--	---

REVISIONS			PLAN PREPARED BY:	
NO.	DATE	BY	DEBEVEC - SALO & ASSOCIATES, INC.	
1			130 EAST JACKSON ST. PAINESVILLE, OHIO	
2				
3			DRAWN BY <u>JWK</u>	SCALE <u>1"=20'</u>
4			CHK'D <u>JWK</u>	DATE <u>29 Jan 76</u>
5			CREW CHIEF	APP'D. <u>4287-90</u>

"AS BUILT" CERTIFICATION

I HEREBY CERTIFY THAT THE CIRCLED GRADES ARE EXISTING FINISH GRADES CHECKED IN FIELD ON 19 BY SURVEYING AND ARE CORRECT TO THE BEST OF MY KNOWLEDGE AND BELIEF.

REGISTERED SURVEYOR REG. NO.

Permit 9749
Zoning Inspector Robert A. Brown