

LAKE ERIE


Reviewed and Accepted
LAKE COUNTY COMBINED GENERAL
DISTRICT DEPARTMENT OF HEALTH
Date 6/22/79

FRED C. KLUTH, M.D.
Health Commissioner
By [Signature]

FIXTURES REQUIRED
ON ALL:

☒ Shower head
☒ Toilets
APPROXIMATE EDGE
OF BANK

Grading Plan Approved
for shown and/or noted in
THOMAS P. GILLES, P.E.
Lake County Engineer
By [Signature] Date 7-29-79

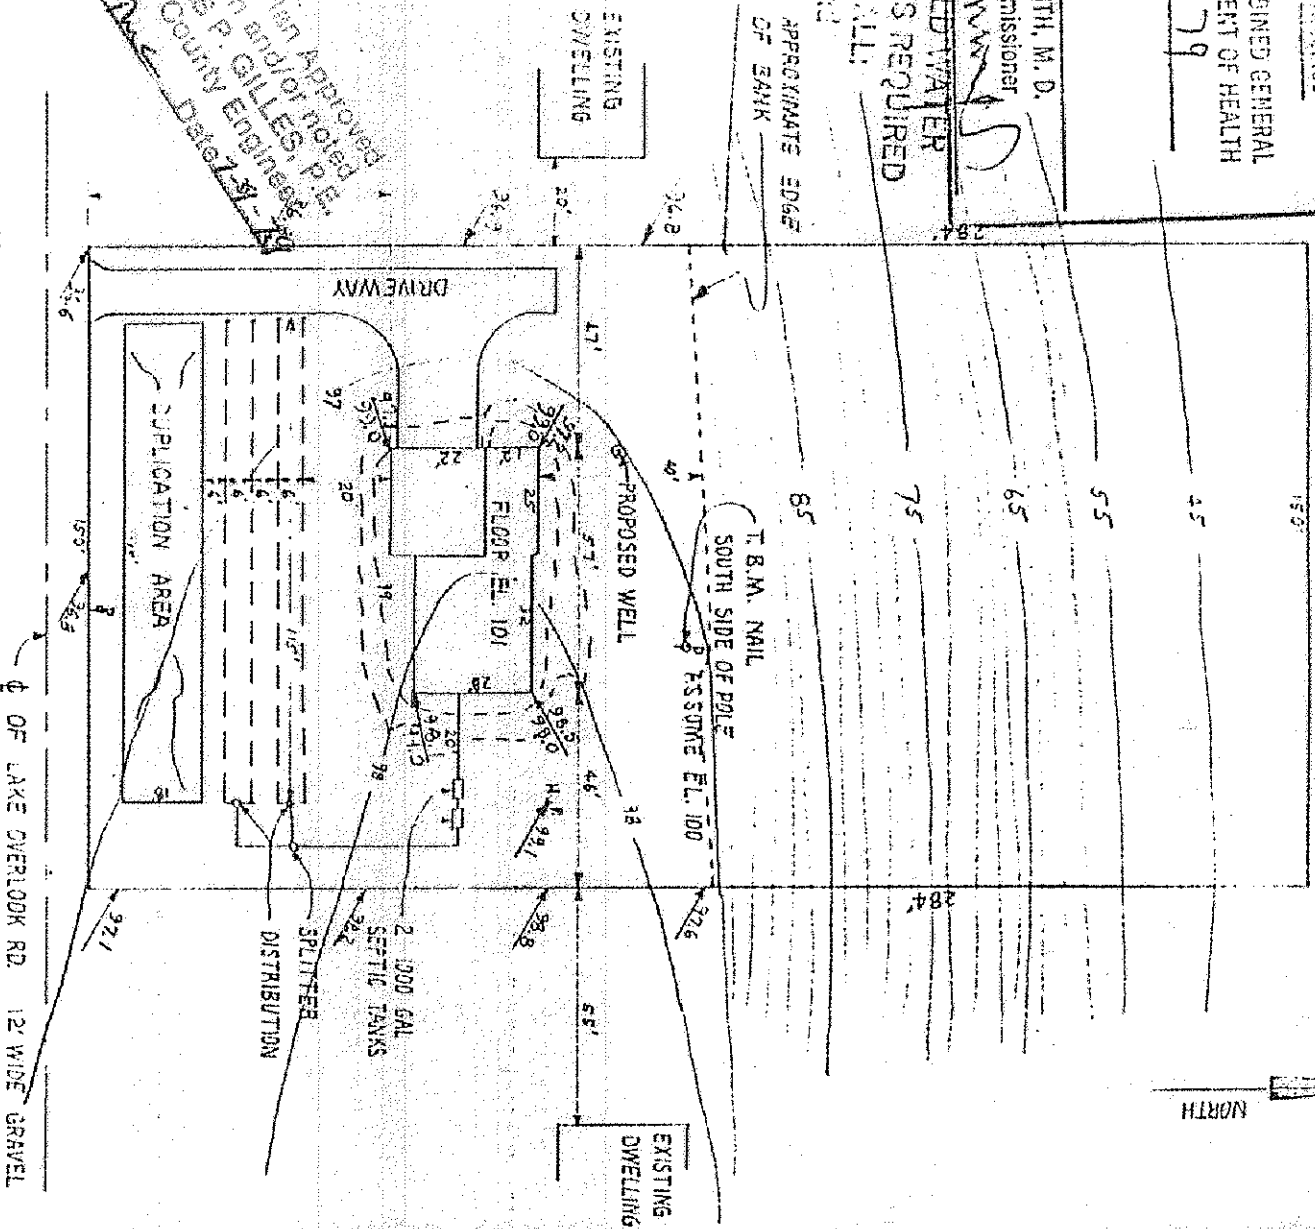

#5425

SITE PLAN

MADISON TOWNSHIP, LAKE COUNTY, OHIO
SUBLOTS 4, 5 + 6
LAKE OVERLOOK RD.
LOT #13 TRACT # 4 VOL. J 93 PAGE 128-A

LEGEND
--- INDICATES PROPOSED CONTOURS
--- INDICATES EXISTING CONTOURS
--- INDICATES EXISTING GRADE

3 BEDROOMS 2 1/2 BATHROOMS FULL BASEMENT 2 STORY 2100 SQ. FT.

ZONING

THIS PLAN IS CORRECT TO THE BEST OF MY KNOWLEDGE AND BELIEF

REGISTERED SURVEYOR REG NO. 6335

Zoning

10465

OWNER:
WILLIAM J. KACER
2015 HAINES RD.
MADISON, OHIO