


Certification:

I certify that the grades were
checked on the _____ day of _____ 1976
and found to exist as shown herein.

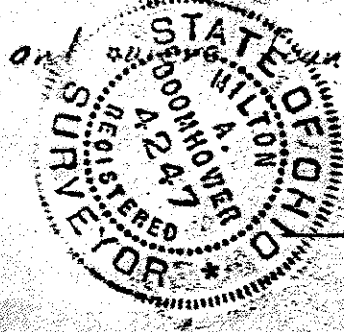

Topo Plot Plan

for

DONOVAN L. ESKESEN

SUB LOTS 253, 254, 255 & 654

MADISON-LAKELAND SUB. #142

MADISON TOWNSHIP

LAKE CO. OHIO

1" = 30' Mar. 1976

N 0° 26' 50" E

APPROVED
MADISON TWP. ZONING

Permit: 9534

Zoning Inspector: Robert L. Brown

Milton A. Boomhower

Reg. Surveyor #4247

Grading Plan Approved

shown and/or noted

THOMAS E. GILLES, P.E.

Lake County Engineer

Date 3/22/76

