


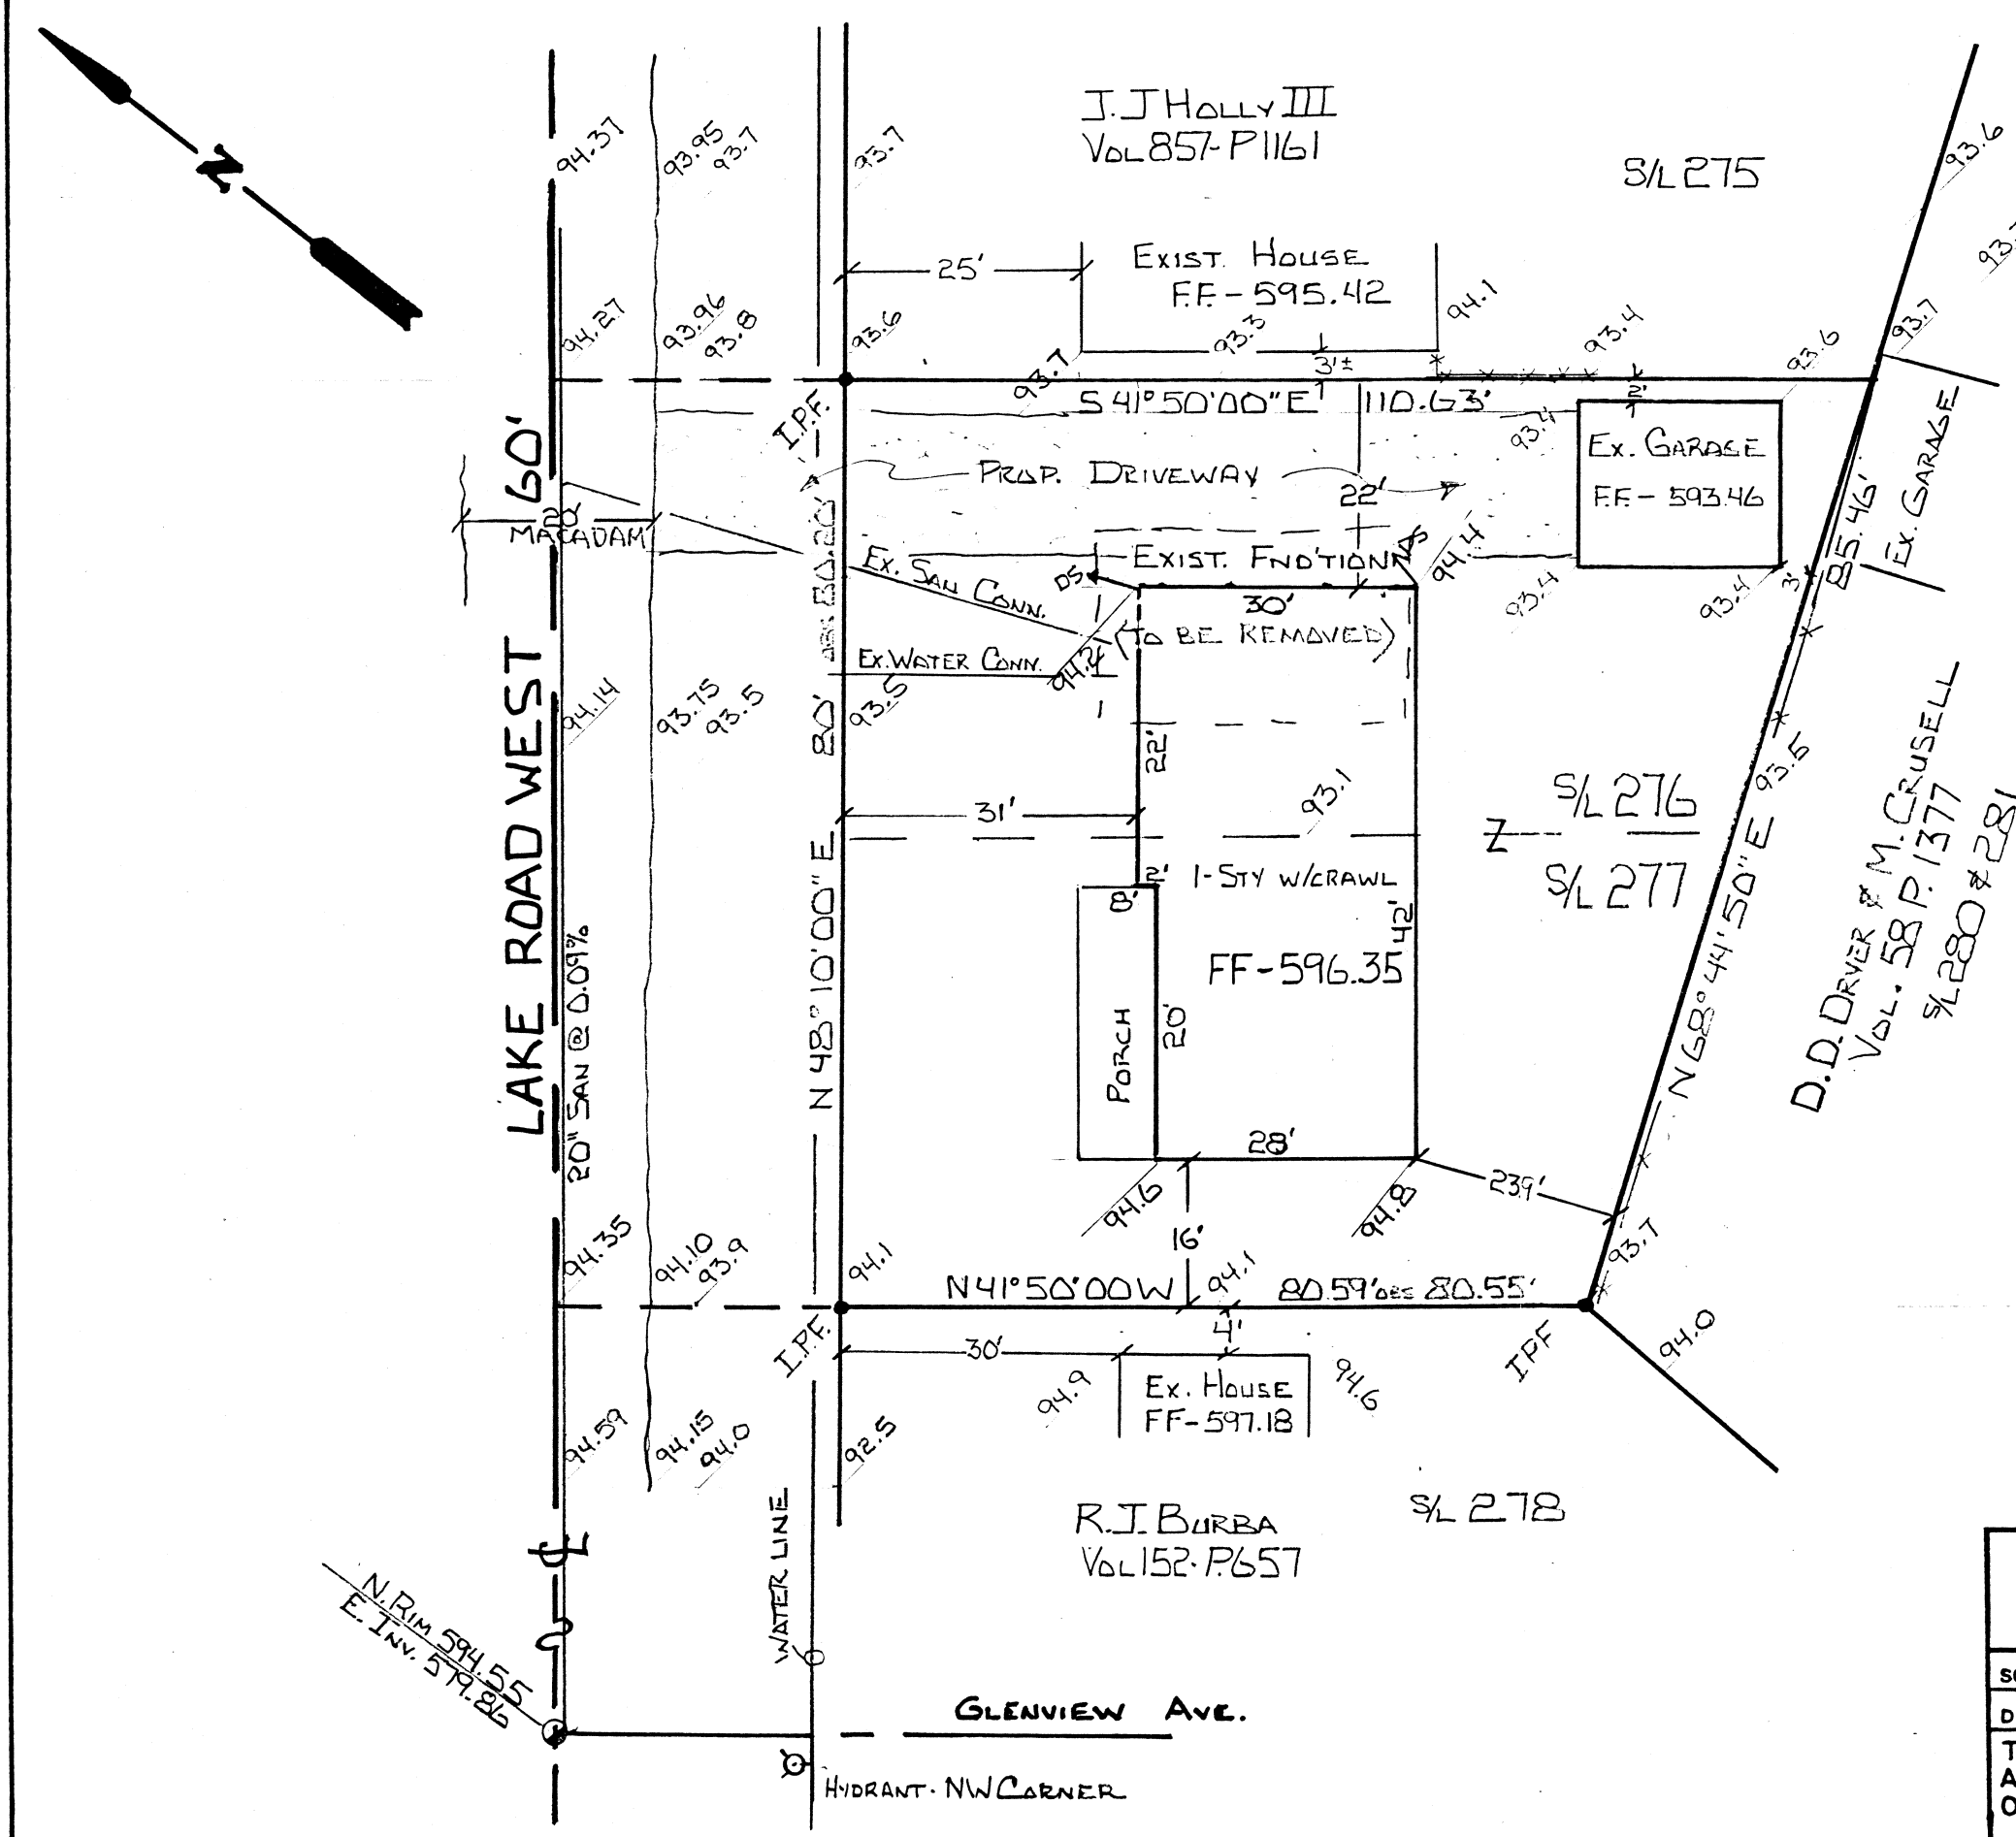


SITE PLAN
FOR
EARL P. & MARY G. STAN
AND
HELEN G. & JAMES R. RIMER
VOL. 537-P. 495

Grading Plan Approved
as shown and/or noted
THOMAS P. GILLES, P.E.
Lake County Engineer

By [Signature] Date 7.29.86

APPROVED
MADISON TWP. ZONING
Permit: 11878
Zoning Inspector: [Signature]

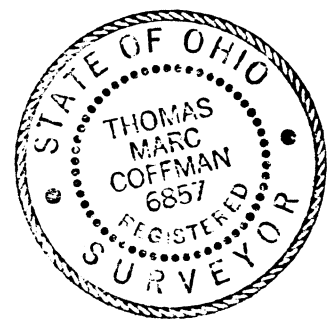

EXIST.
PROP.

BENCHMARK - SAN. MH LAKE RD. @ GLENVIEW DR.
NORTH RIM - 594.55

BEING SUBLOTS 276 & 277 OF THE MADISON LAKE- LAND SUBD., TOWNSHIP OF MADISON, LAKE COUNTY, OHIO		
SCALE: 1"=20'	APPROVED BY: <u>[Signature]</u>	DRAWN BY: <u>[Signature]</u>
DATE: JULY, 1986		
THIS PLAT WAS PREPARED BY ME AND IS ACCURATE TO THE BEST OF MY KNOWLEDGE AND BELIEF.		
<u>Thomas M. Coffman #6857</u> REG. SURVEYOR		