


ERIEVIEW ESTATES SUBDIVISION V X P 19

APPROVED
MADISON TWP. ZONING
125617
Permit
Survey Inspector
JUL 28 1989

ROY RONKE JR. V 272 P 480

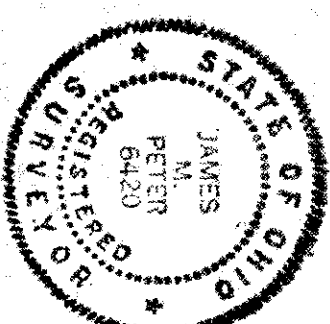

J.M.P.

SCALE 1" = 20 FT 21 JULY 1989

---595--- existing contour elev.
---595--- proposed contour elev.
property line
centerline
edge of pavement
right of way


Grading Plan Approved
as shown and/or noted
THOMAS P. GILLES, P.E.
Lake County Engineer
Date 7/28/89
1.5 scale as indicated.

PARCEL 4
D.C. WELSH TR.
V. 400 P. 1282
1.32 Acre

PARCEL 1
JOE WELSH
3.21 A.C.

PARCEL 2
JOE WELSH

SITE PLAN
FOR
JOE WELSH
LOT 16 TRACT 1
MADISON TWP. LAKE CO. O.

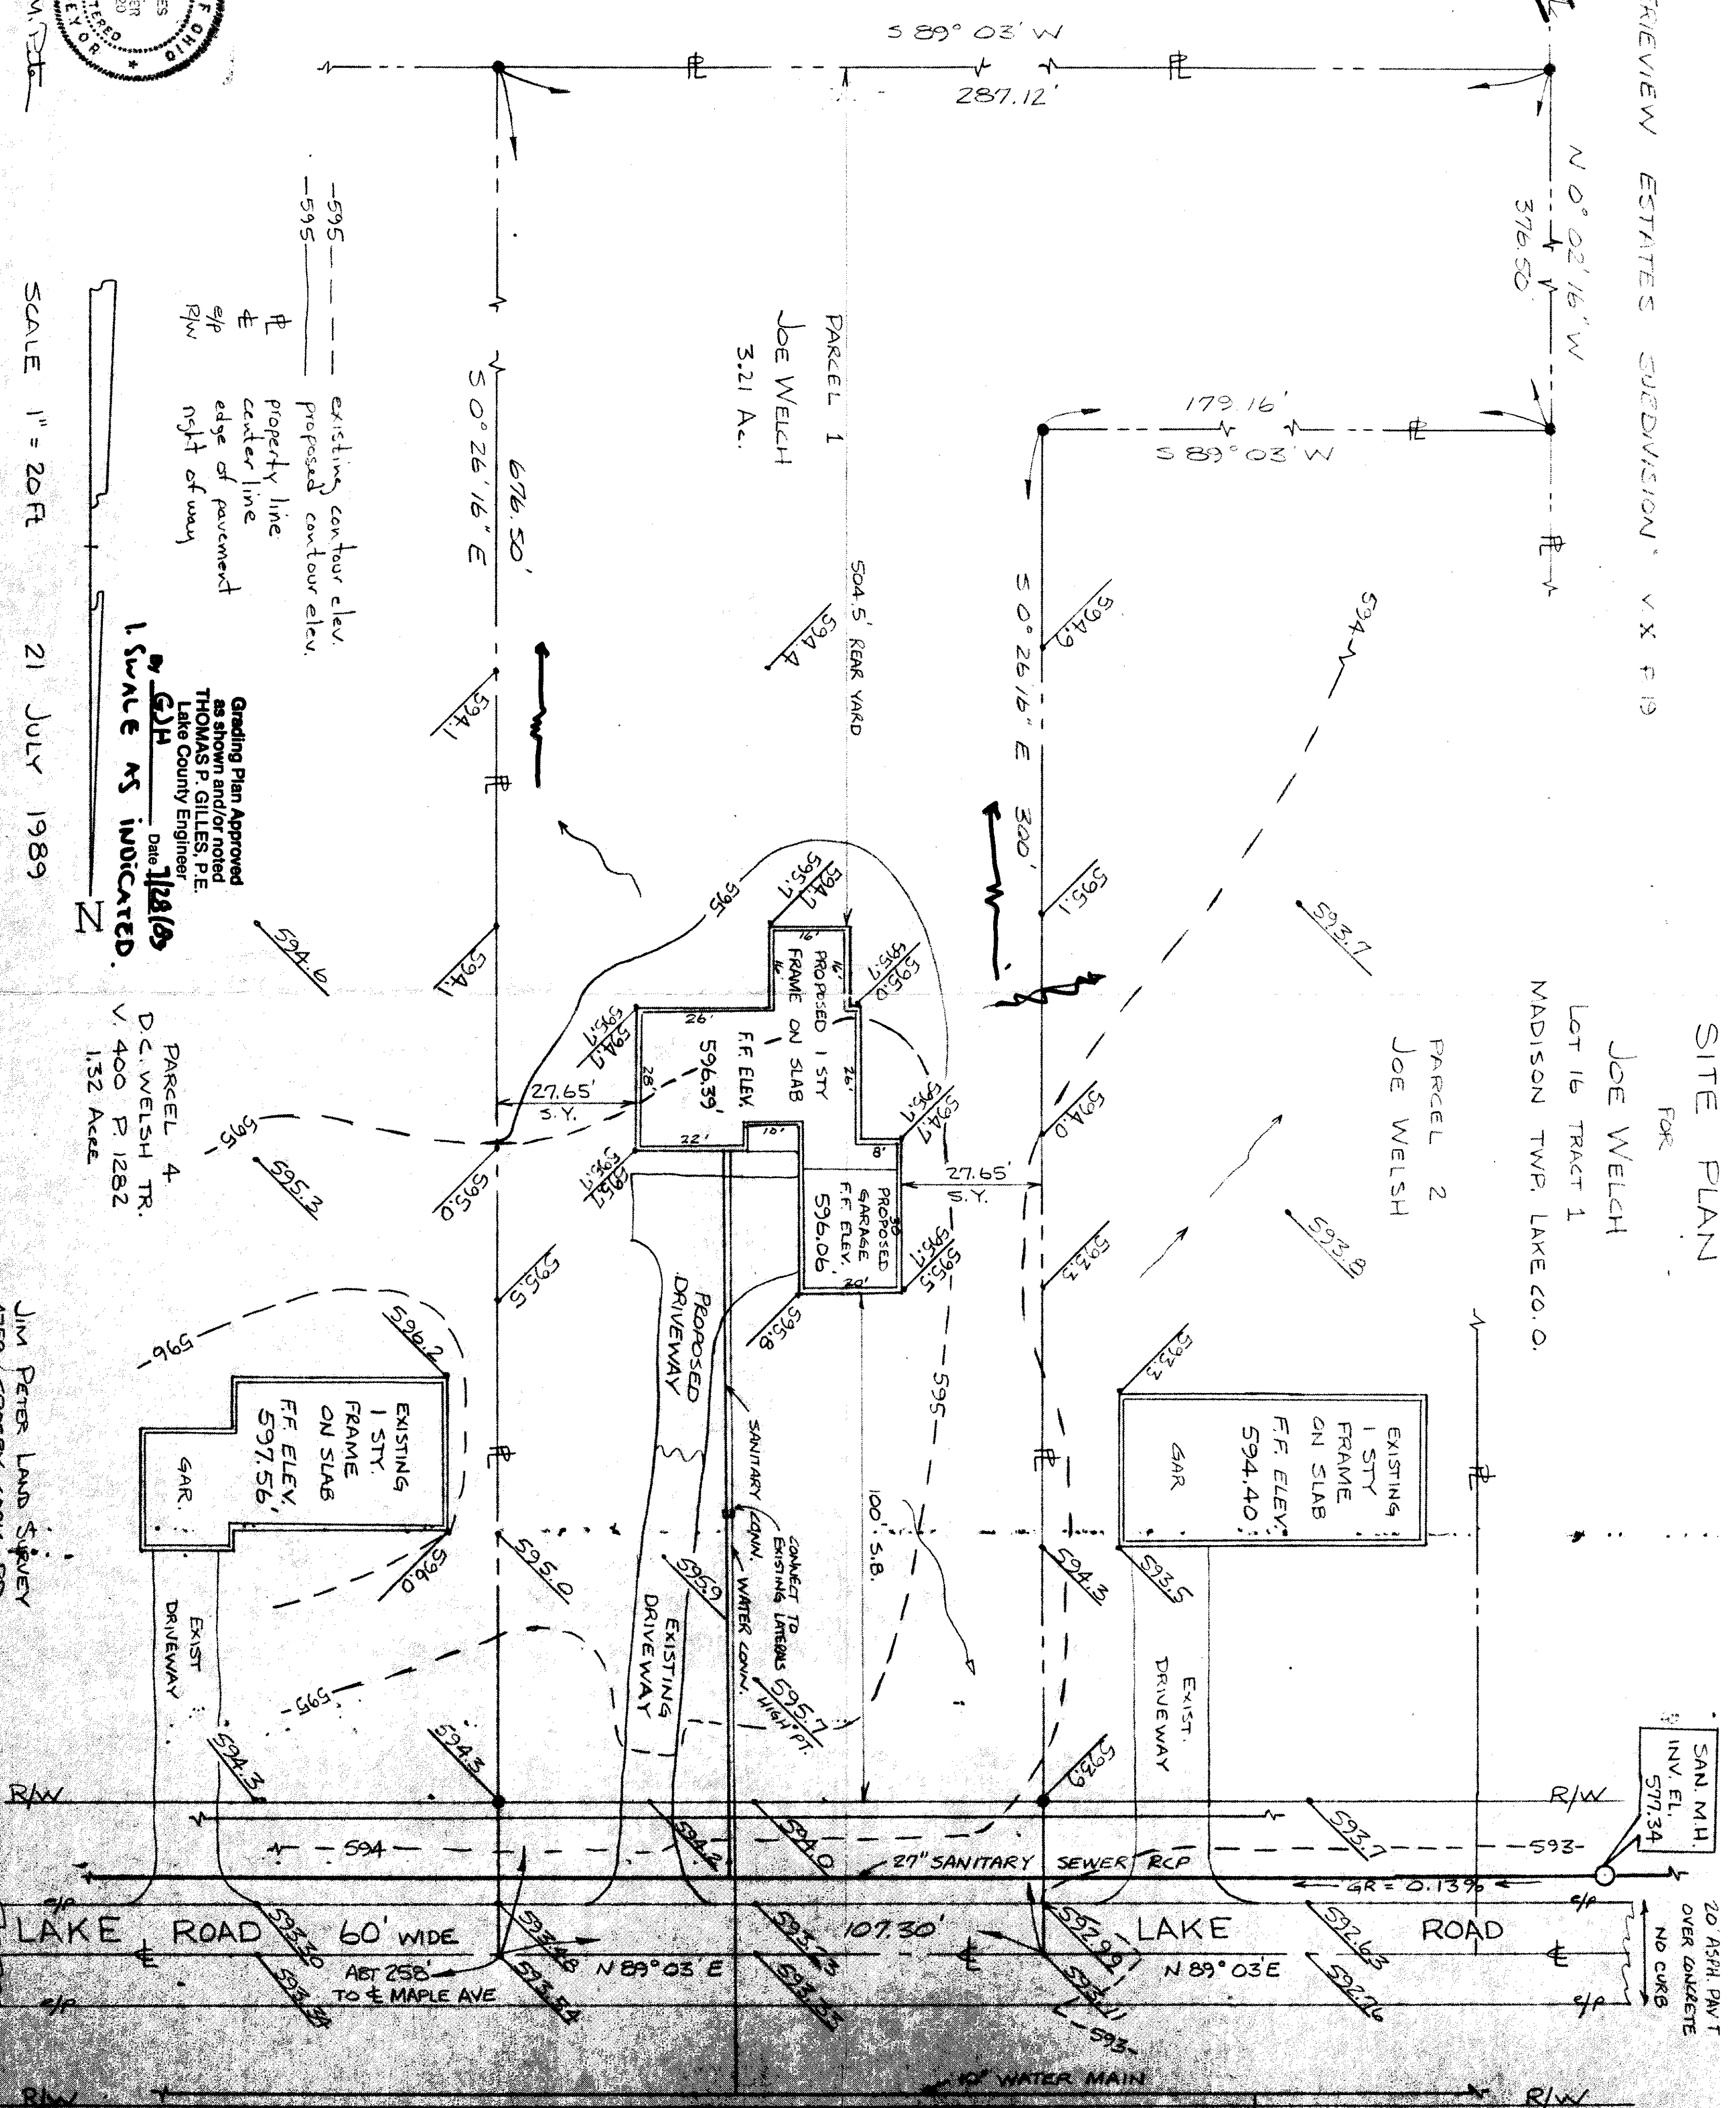

SAN. M.H.
INV. EL.
577.34
20' ASPH. PAV'T
OVER CONCRETE
NO CURBS

BRON. MARK. ELEV. 595.31
FIRE HYDRANT