

SAN. MH.
RIM 594.50
INV. 580.80

595.26

595

LAKE ROAD 60' WIDE

S88°19'00"E
130.00'

S88°19'00"E
100.00'

EX. 18" SAN. SEWER
585.84

BENCHMARK:
TOP OF IRON PIPE
ELEV. 596.35

596.58

EX. WATER

596.88

596

596.60

REDBIRD ROAD 60' WIDE



PP# 1B-115K-12

N00°42'00"E
265.94'

595.36

596.42

S00°42'00"W
263.58'

PP# 1B-115K-14

Grading Plan Approved
as shown and/or noted
JAMES R. GILLS, P.E.
Lake County Engineer

By JMG Date 7/2/03

PP# 1B-115K-13

595.67

NOTES
1 The Contractor Shall Verify the following Before Starting
Finish Elevation and House
Location and elevation of existing
2 1/2" utility and water lines
Days prior to construction, 1-800-
362-2764

GRAPHIC SCALE

APPROVED
MADISON TOWNSHIP ZONING
DATE 6/15/03
BY DA 2/4/0


"I, the undersigned hereby certify that this topography, indicated by 1" contours and elevations shown hereon represents an actual field survey made by me in June, 2003 and that the elevations were taken at appropriate intervals and that as of that date they existed as indicated hereon"

David A. Rapp

Reg. No.

6/16/03

N89°40'00"W
99.98'

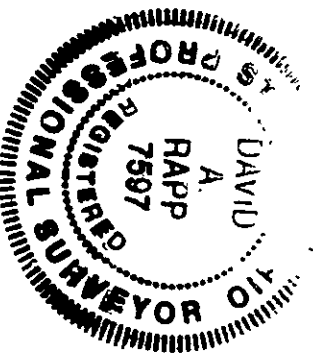

23051

COR Consultants, Inc.
23 S. Forest Street
Genevo, Ohio 44041
440-466-8085

DATE: June, 2003
DRAWN BY: DAR
CHECKED BY: RAC
APPROVED BY: DAR
P.S. No. 7597

DAVID FISHER
PP# 1B-115K-13
Site Plan