


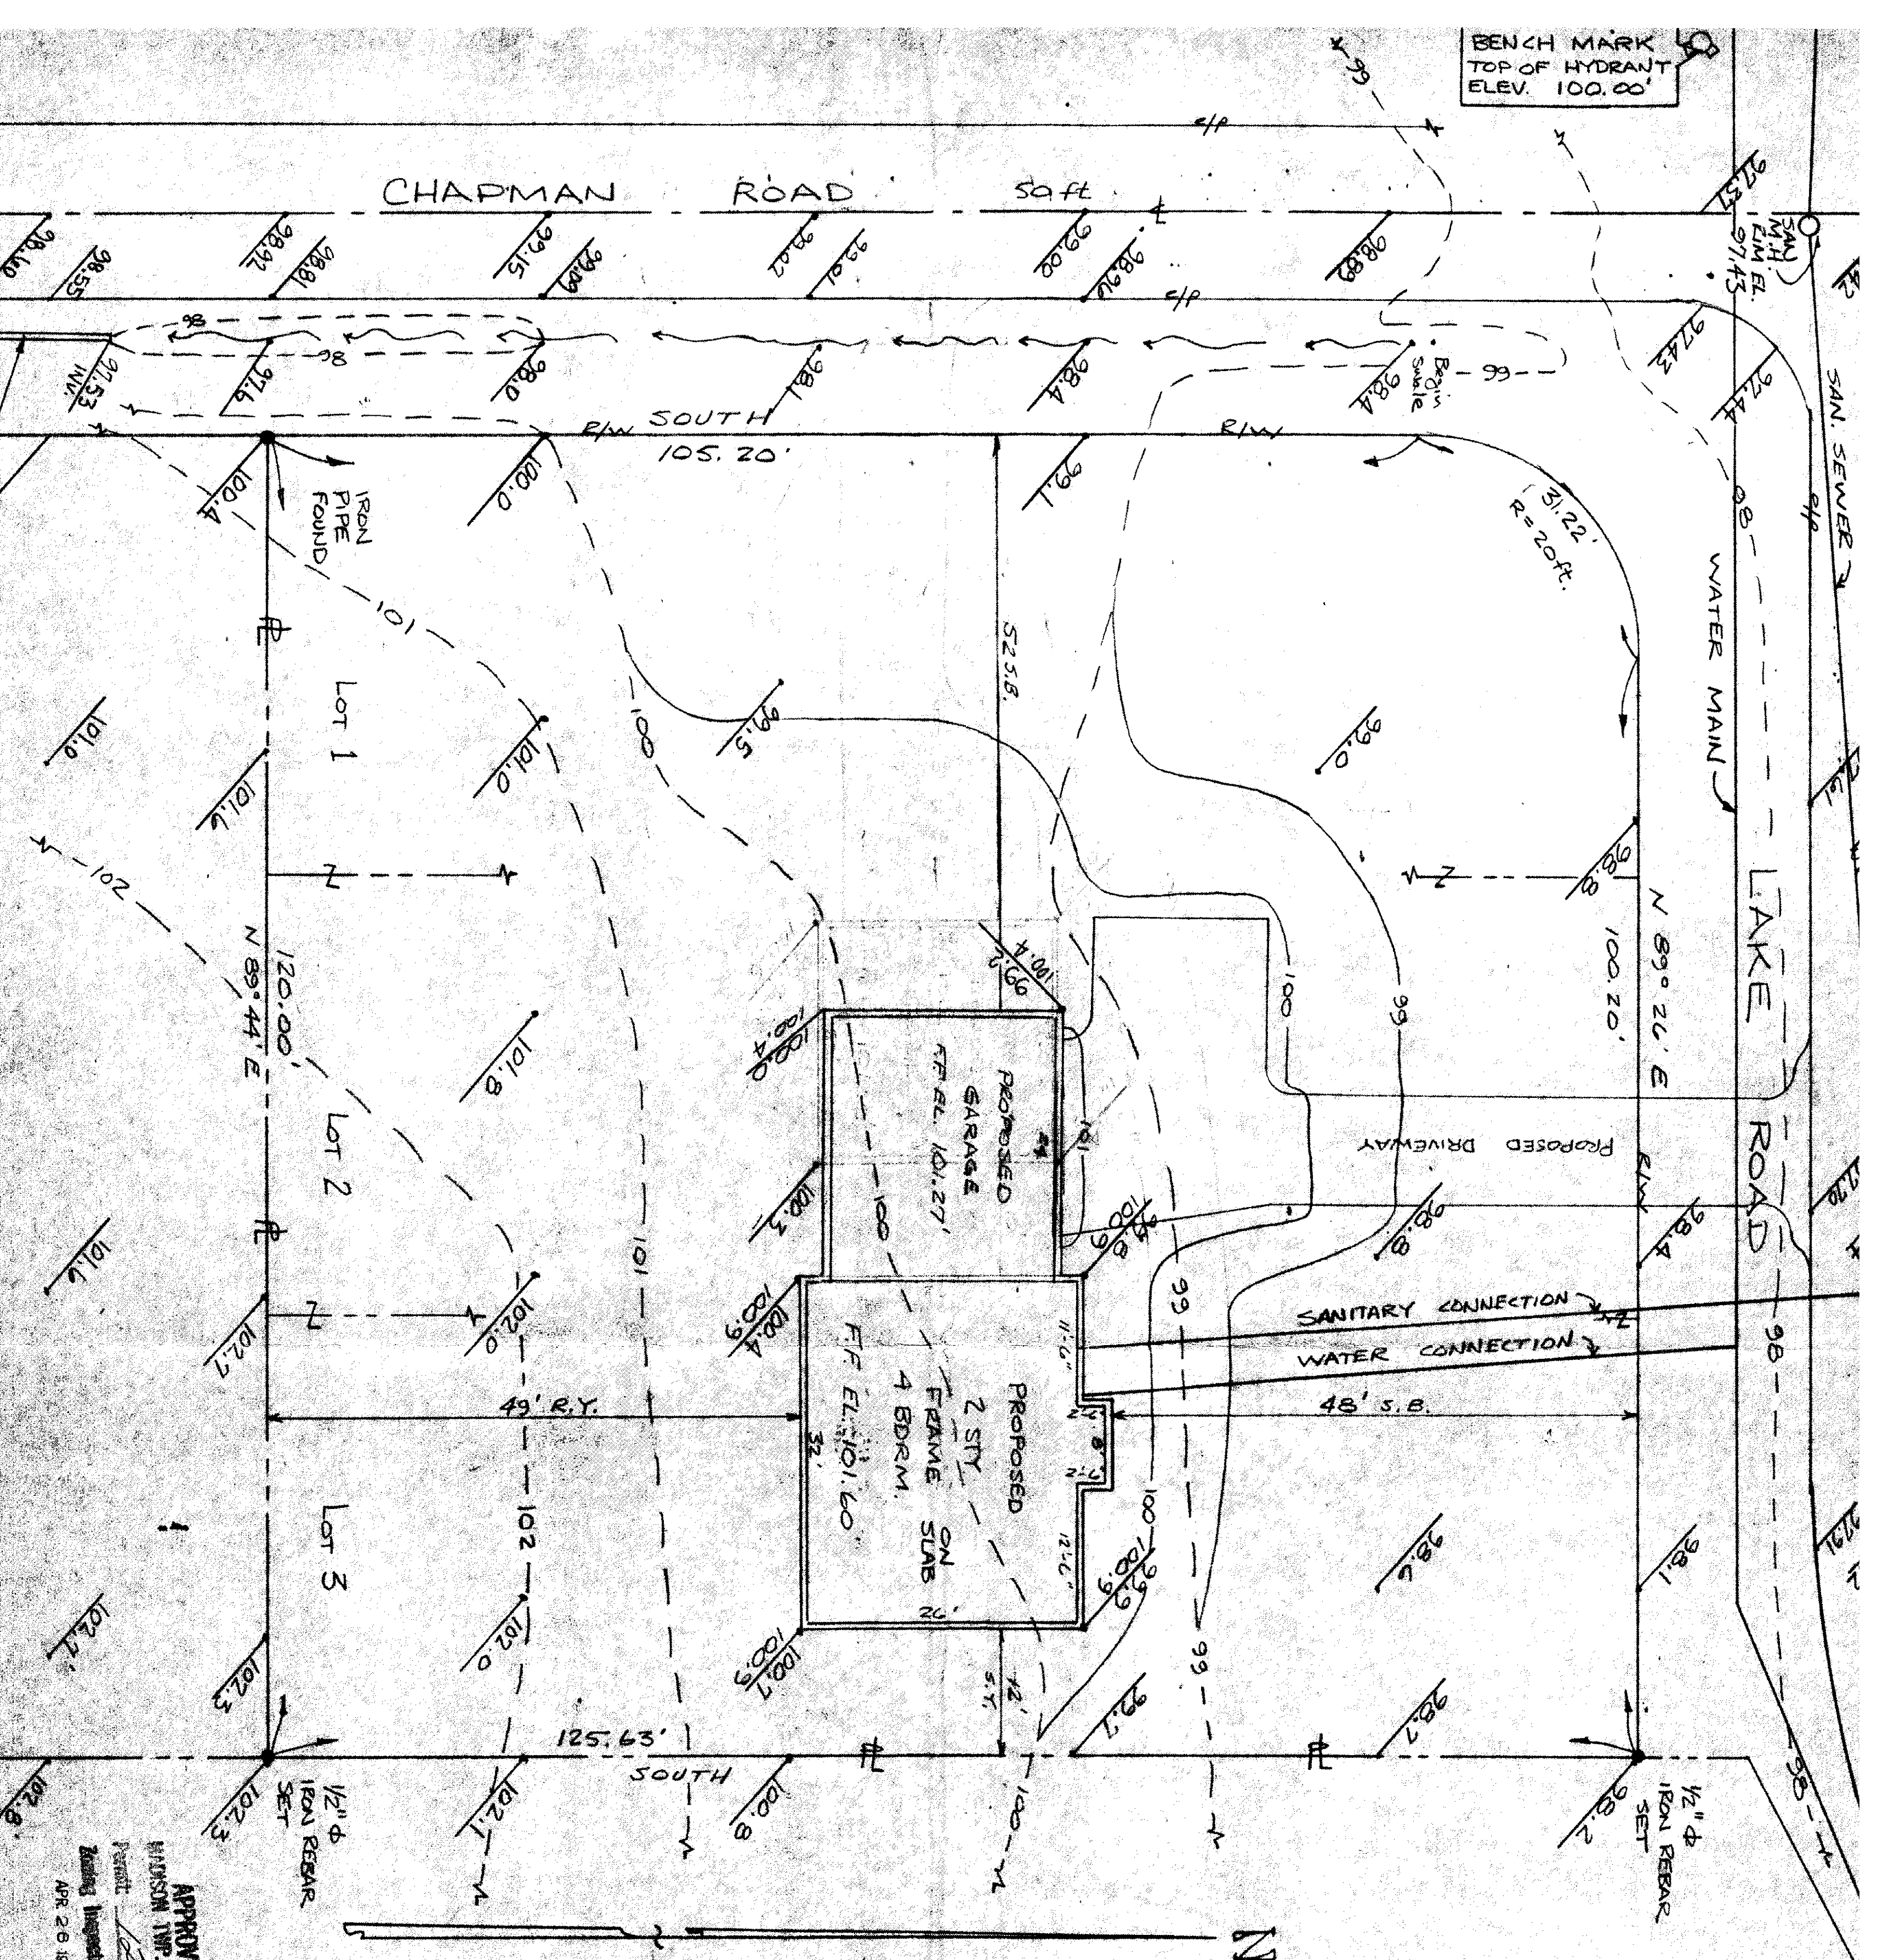

BENCH MARK
TOP OF HYDRANT
ELEV. 100.00'

CHAPMAN ROAD

50 ft

R/W SOUTH
105.20'

WATER MAIN

LAKE ROAD

SANITARY CONNECTION
WATER CONNECTION

PROPOSED
GARAGE
FF EL. 101.27'

PROPOSED
2 STY -
FRAME SLAB
4 BDRM.
FF EL. 101.60'

Lot 1

Lot 2

Lot 3

1/2" Ø
IRON REBAR
SET

1/2" Ø
IRON REBAR
SET

SITE PLAN

FOR

RON WELCH


Lot 1, 2, 3 of PARKVIEW
ALLOTMENT

HUBBARD LOT TRACT 2 MADISON TWP.
LAKE COUNTY, OHIO

18 APRIL 1991

SCALE 1" = 10 ft

JIM PETER LAND SURVEY
4759 CROSBY COOK RD
ROME, OHIO 44085

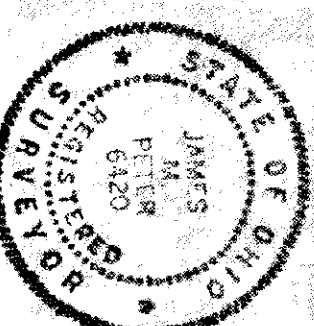

---98--- existing contour elev.
---99--- proposed contour elev.

Grading Plan Approved
as shown and/or noted
THOMAS P. GILLESPIE
Lake County Engineer

APPROVED
WILSON TWP. ENGINEER
THOMAS P. GILLESPIE
Date 4/29/91

ROAD OPENING PERMIT REQUIRED BY
THE LAKE COUNTY ENGINEER'S OFFICE
FOR SANITARY AND WATER CONNECTIONS
APR 28 1991