




LAKE ERIE
84.00

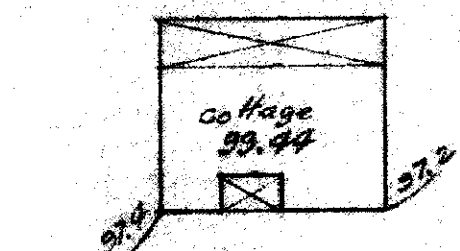

Grading Plan Approved
as shown and/or noted
THOMAS P. GILLES, P.E.
Lake County Engineer

By AMP Date 4-30-85

SITE PLAN
for

PHILLIP M. SANSON
BOLLES LOT TRACT 2
MADISON TWP.
LAKE CO. OHIO
1" = 40' Apr. 1985

William A. Barnhouse
Reg. Surveyor #4227

APPROVED
MADISON TWP. ZONING





Permit: 11529
Zoning Inspector: R. J. Smith

BENNETT ROAD

Martha F. Wetzel
533 - 55%

11° 06' 40" E 385'

Top bank
94.2'

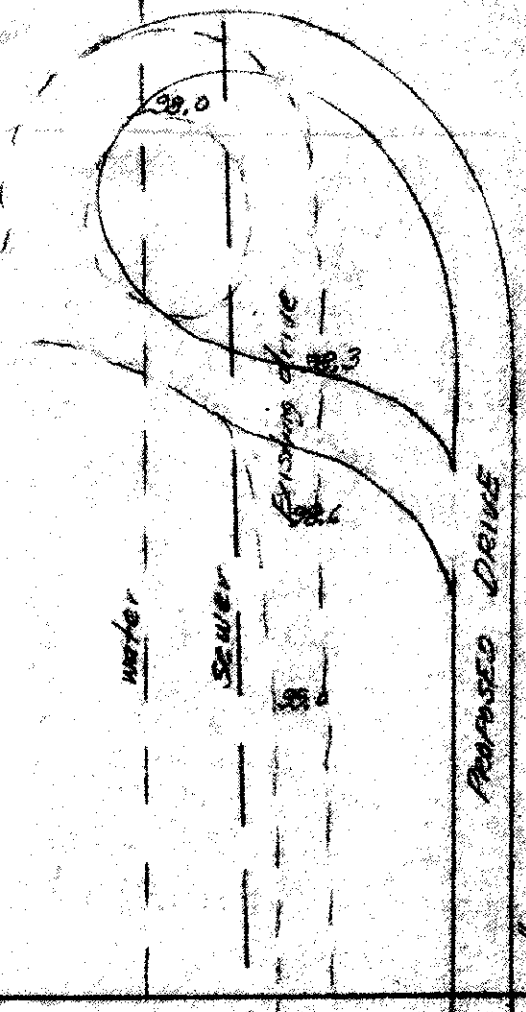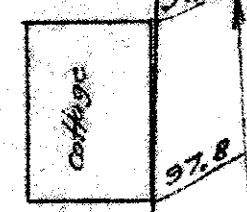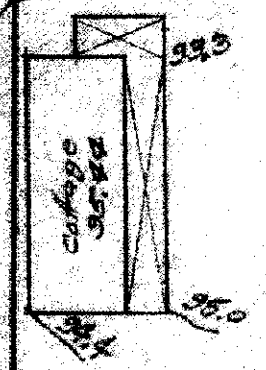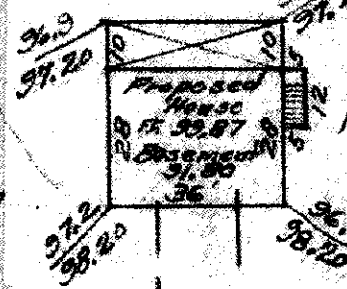

Gray C. and Dobson I. Russell
851 - 38%

235.00 171.00 611
Min. 55 Max. 100.00
Water line Sewer Proposed Drive
West M.N. Sanitary Sewer

LAKE ROAD EAST