

A. To be brought to finished grade

1. Septic tank manhole covers
2. Splitter box cover
3. Distribution box cover

B. No footer drains or downspouts
to be discharged into septic tanks

C. All waste water to be discharged into
septic tanks

APPROXIMATE HOLE LOCATIONS

Reviewed and Accepted

LAKE COUNTY GENERAL HEALTH DISTRICT

Date 5.20.92

See condition

JOEL LUCIA, R. S., M. P. H.
Health Commissioner

By Nancy Nienhu


BALANCE OF PARCEL TO BE
UNDISTURBED

LOW YIELD WATER
FIXTURES REQUIRED
ON ALL:

Shower Head
Toilet

1"=50'
Grading Plan Approved
as shown and/or noted
THOMAS P. GILLES, P.E.
Lake County Engineer


By 9/14 5/27/92

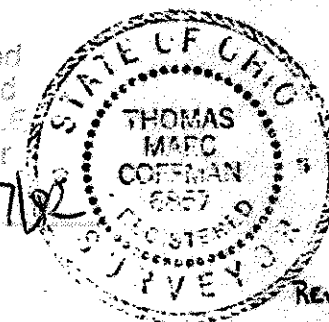

REVIEWED
4-9-92
REV 5-19-92

TEMP BENCH MARK PK
POLE # 2201051 = 100.00

DITCH

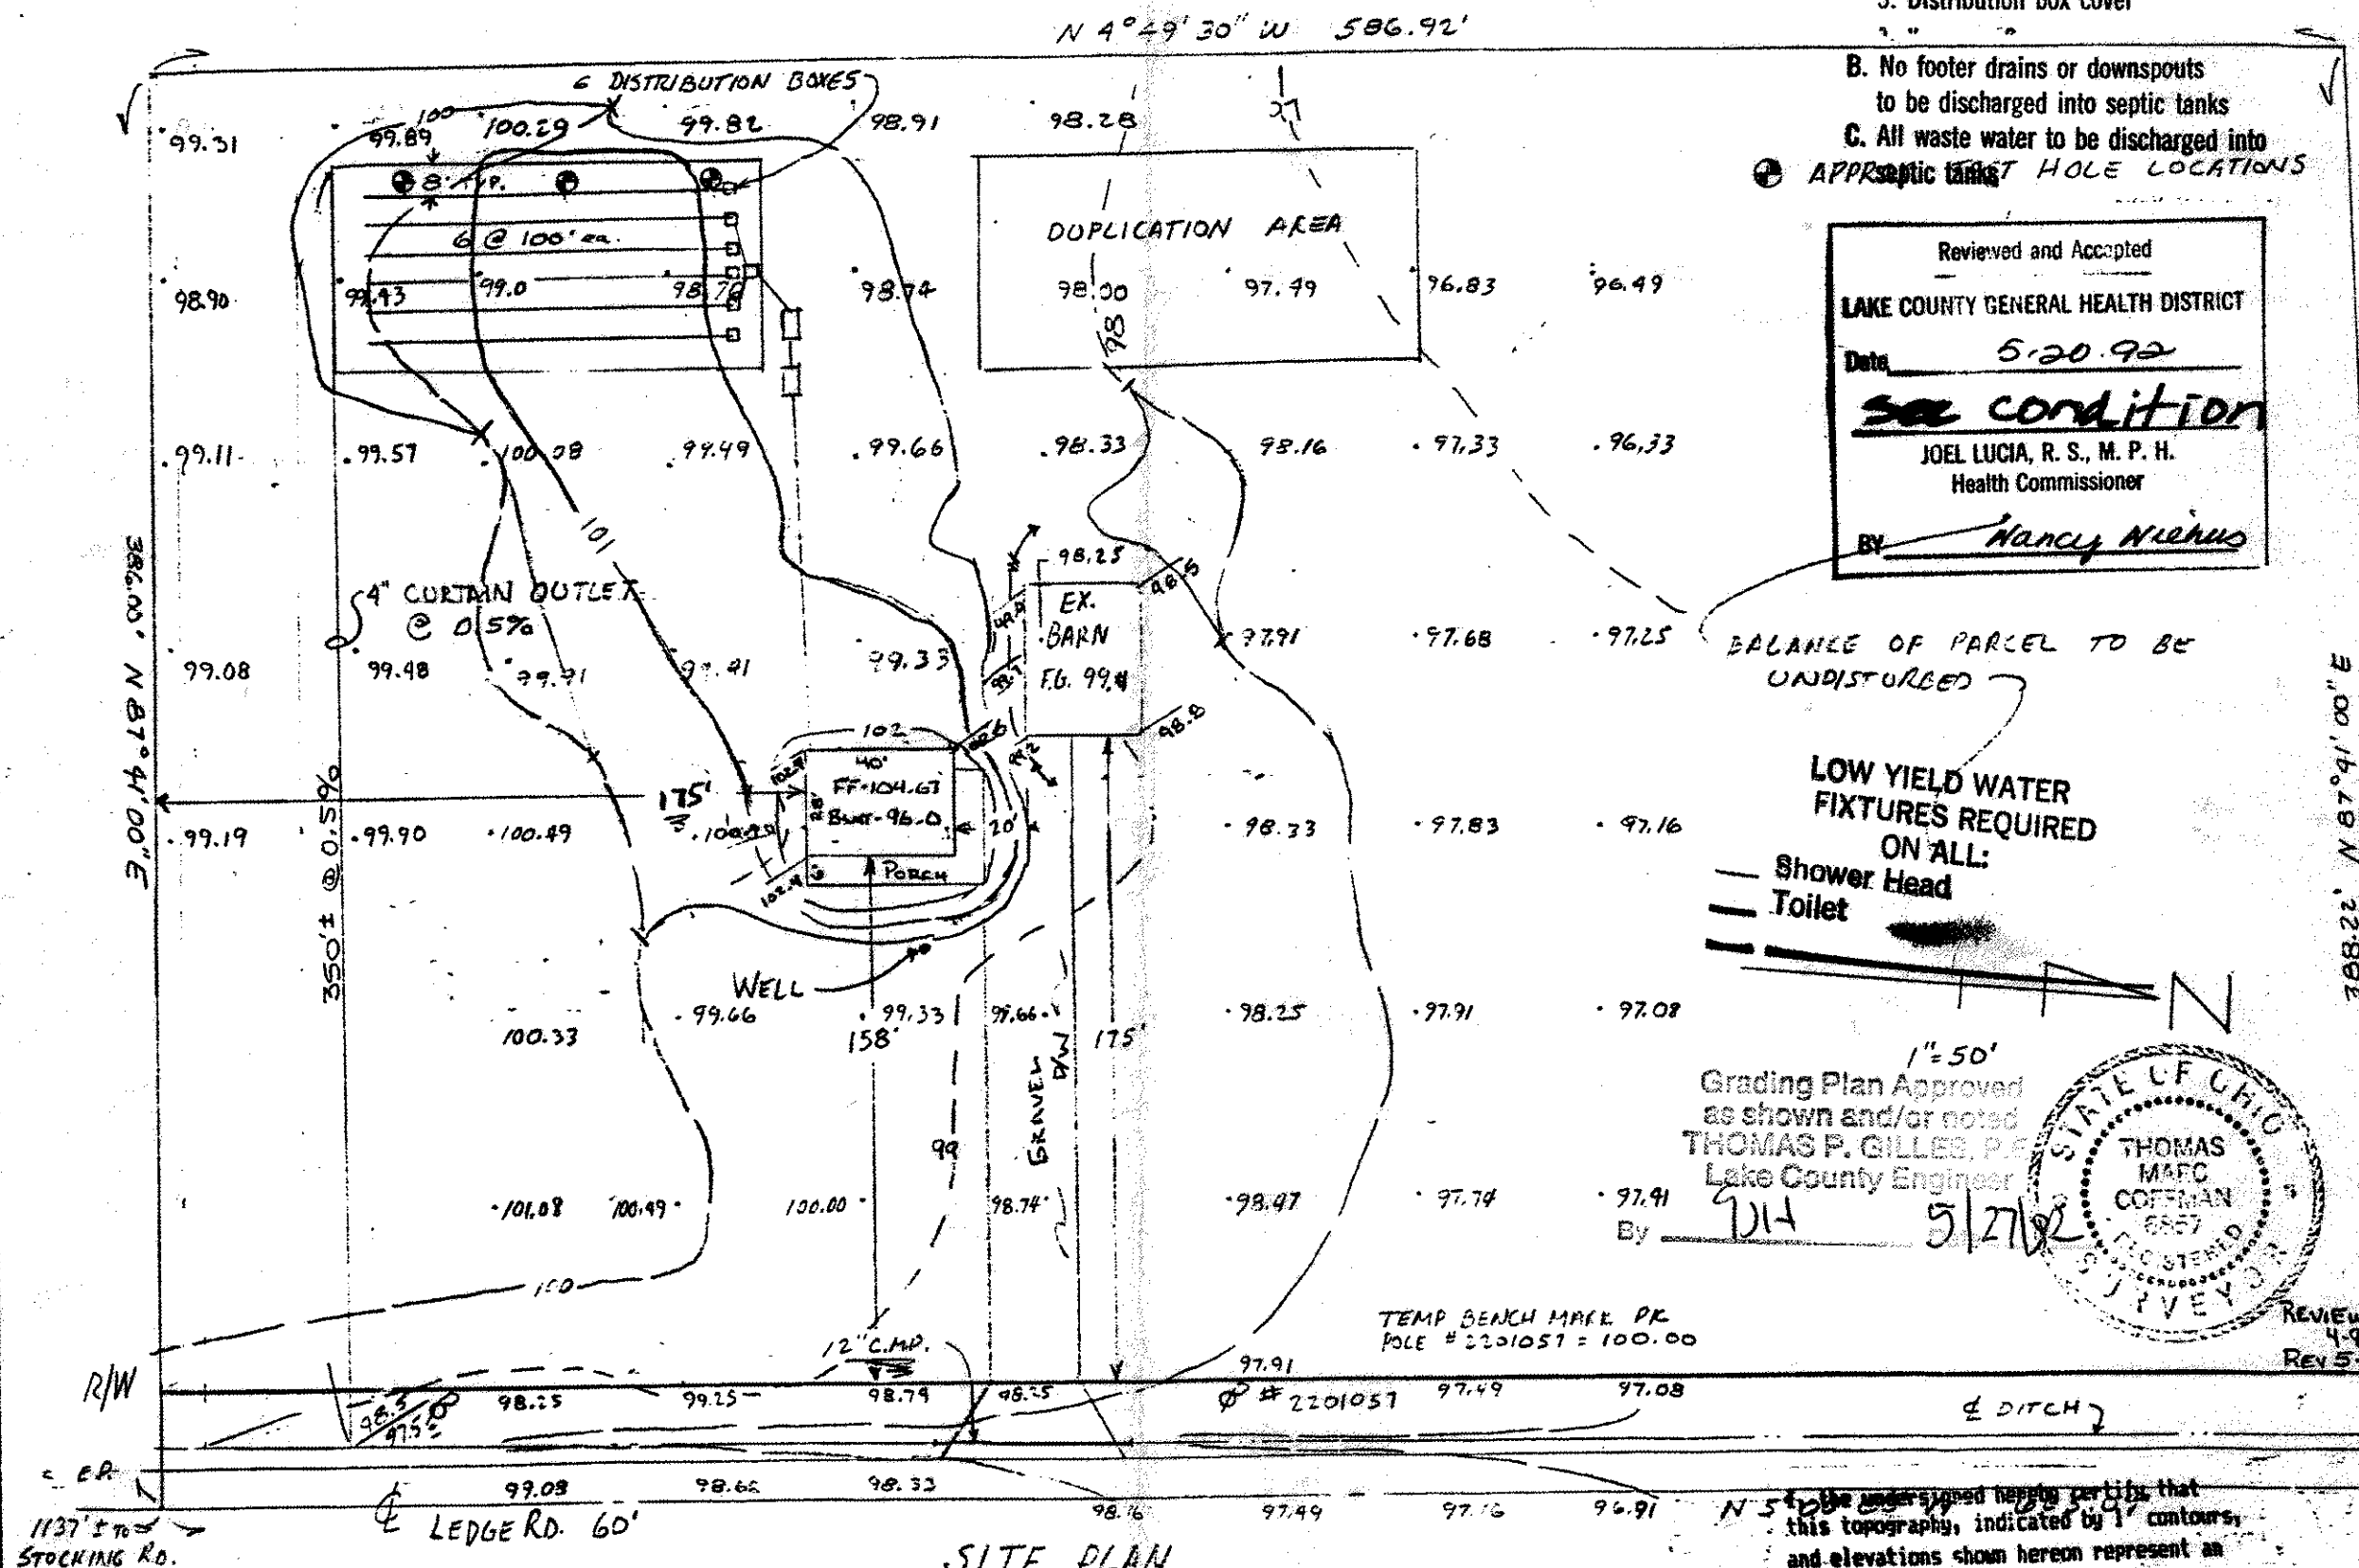

SITE PLAN

FOR

ALLEN DALE SMITH

PERM. PARCEL 1A-50-1B

MADISON TWP. OHIO

APRIL 1992

SEWAGE DISPOSAL PERMIT MUST BE
OBTAINED BY A LAKE COUNTY LICENSED
INSTALLER BEFORE INSTALLATION IS
STARTED.

I, the undersigned hereby certify that
this topography, indicated by 1' contours,
and elevations shown hereon represent an
actual field survey made by me on MAY 13, 1989
and that the elevations were taken at
appropriate intervals and that as of that
date they existed as indicated hereon.

J.M. Coffman P.E.