
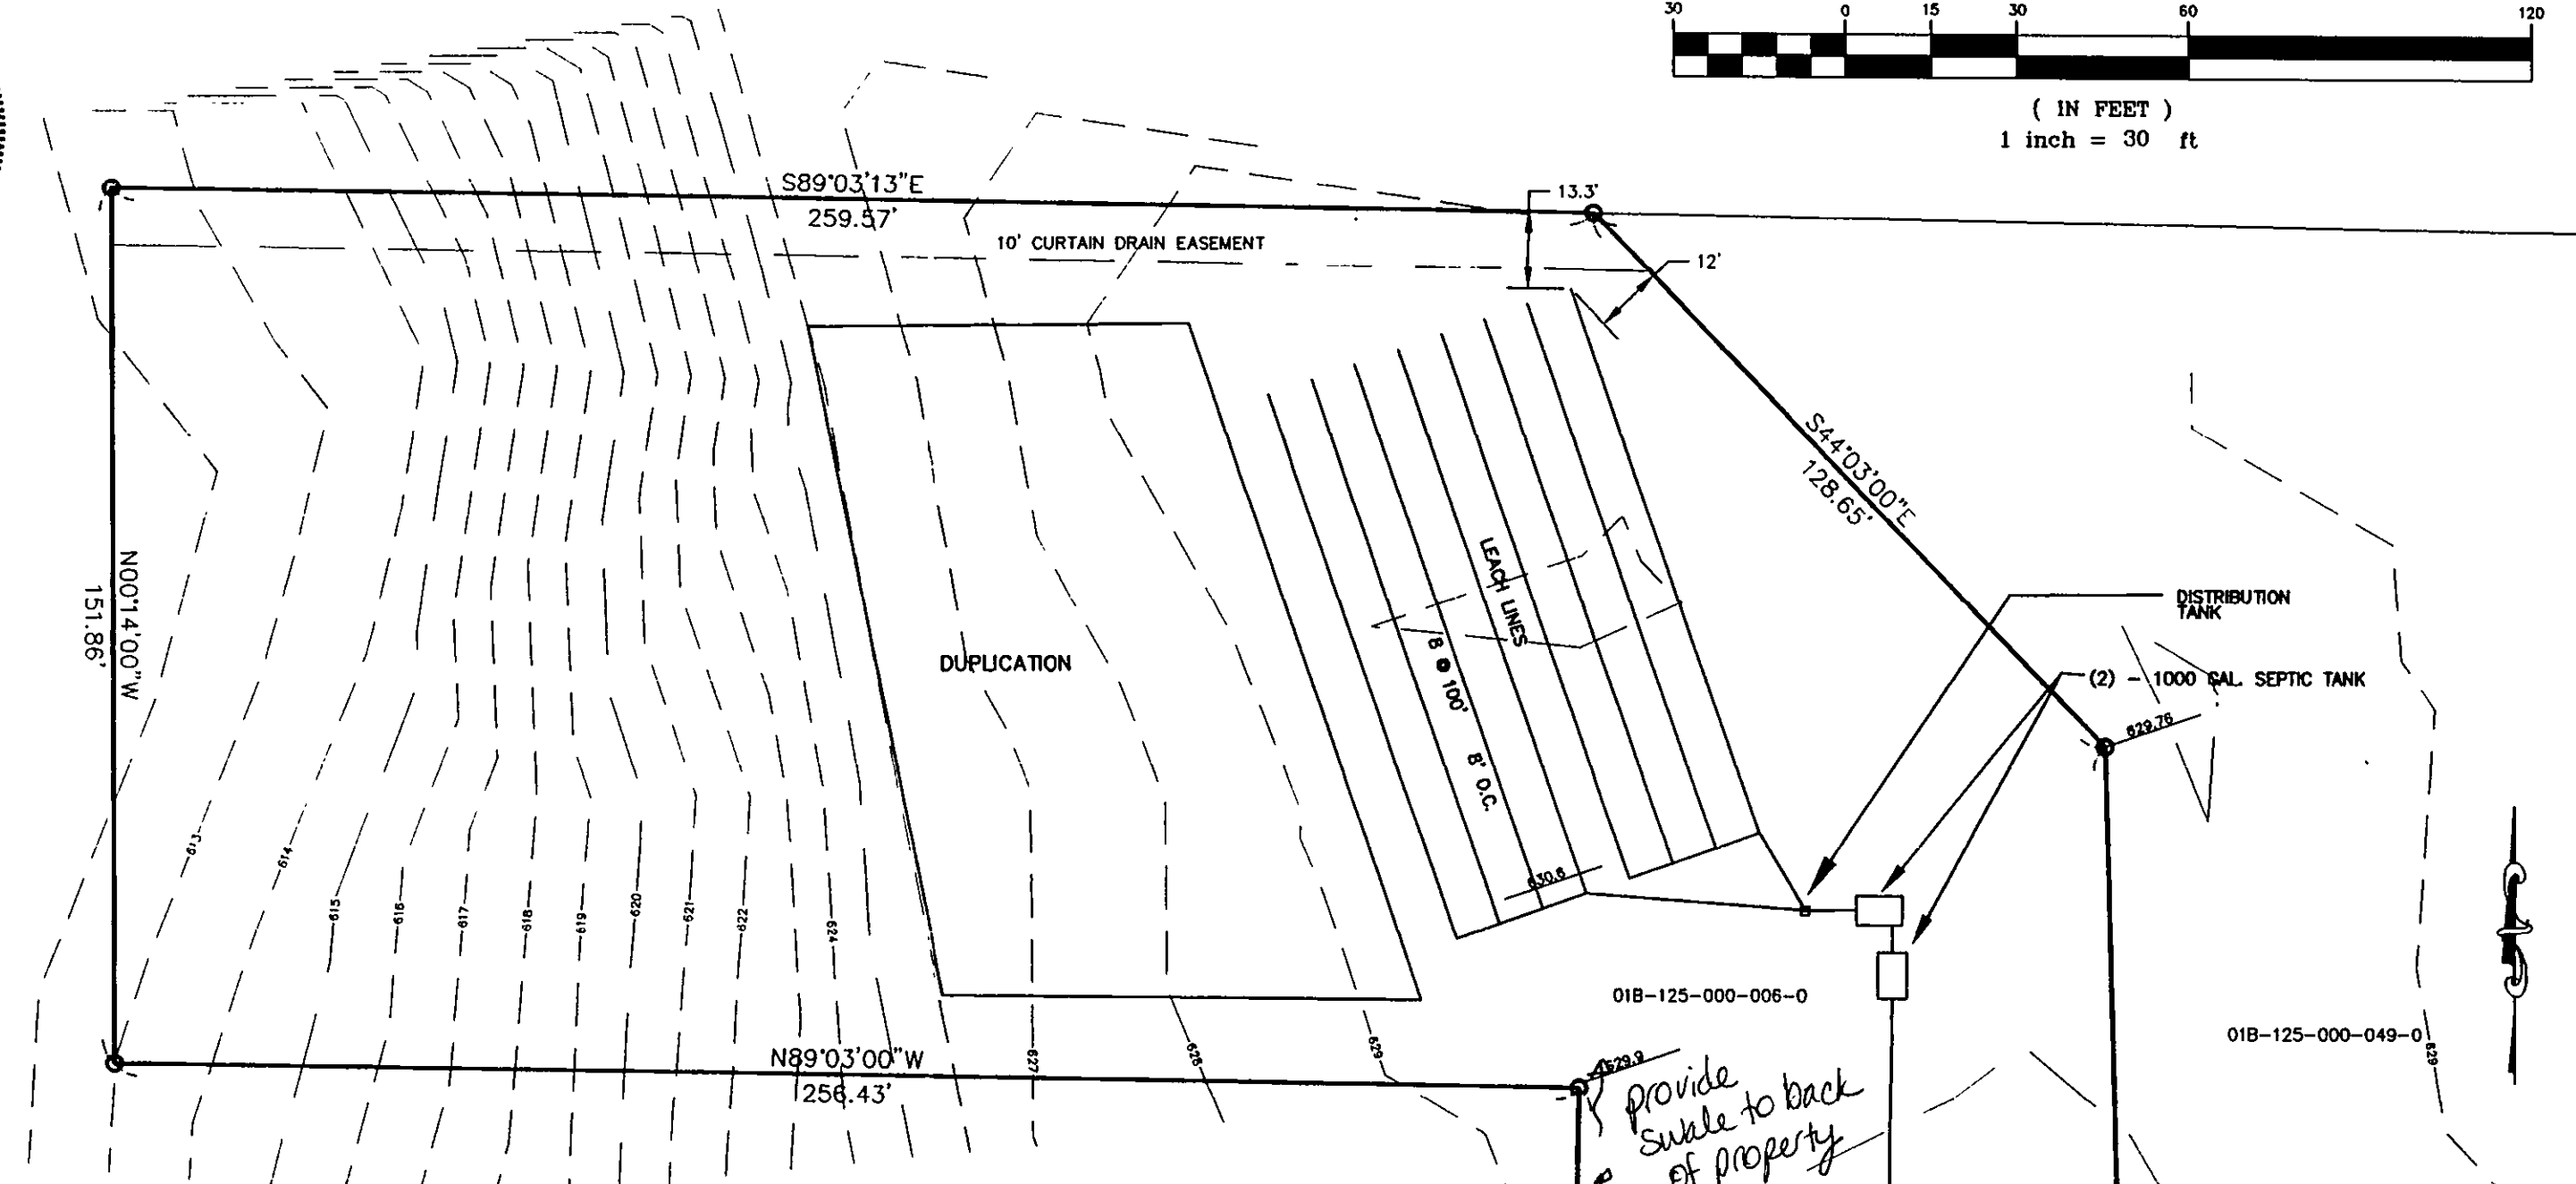


NOTES: 1. The Contractor Shall Verify the Following Before Starting.
Finish Floor Elevations and House Size.
Location and elevation of existing utility connections.
2. Contractor Shall Contact OUPS at least 2 Working Days prior to construction, 1-800-362-2764.

"I, the undersigned hereby certify that this topography, indicated by 1' contours and elevations shown hereon represents an actual field survey made by me in APRIL, 2001 and that the elevations were taken at appropriate intervals and that as of that date they existed as indicated hereon."


David A. Rapp 6/2/03 Reg. No.

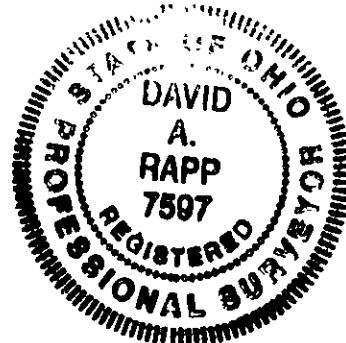

01B-125-6
R-1 ZONE

Grading Plan Approved as shown and/or noted
JAMES R. GILLS, P.E.
Lake County Engineer


By *[Signature]* Date 6/10/03

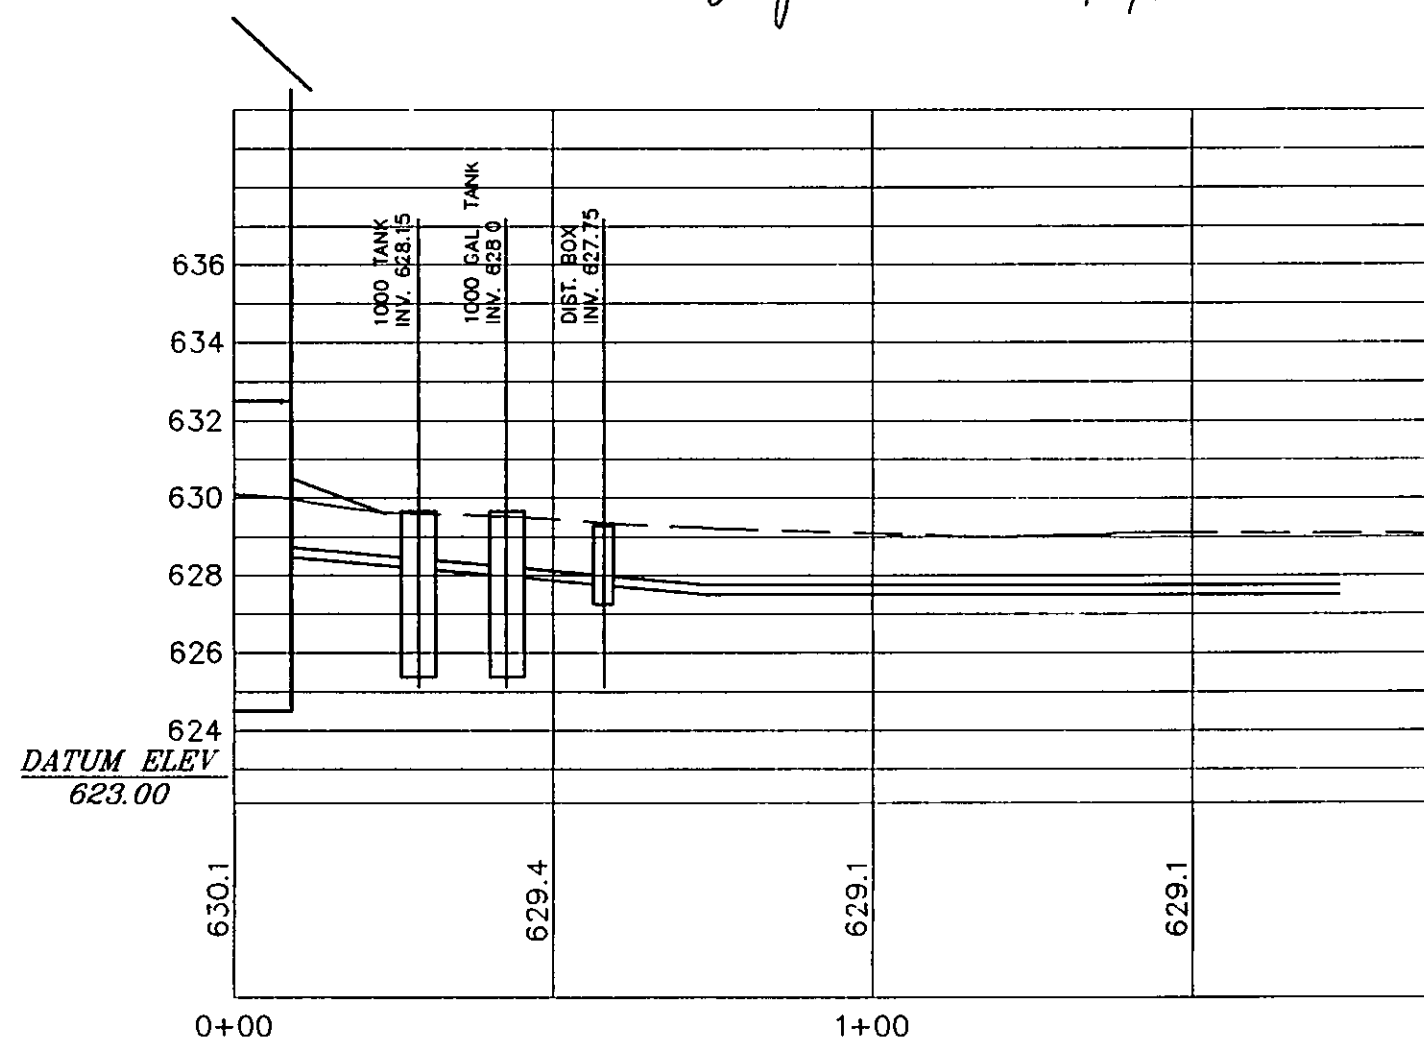

REVIEWED AND ACCEPTED
LAKE COUNTY GENERAL
HEALTH DISTRICT

Date 5-30-03 BY
[Signature] R.S.

SEWAGE DISPOSAL PERMIT MUST BE
OBTAINED BY A LAKE COUNTY LICENSED
INSTALLER BEFORE INSTALLATION IS
STARTED

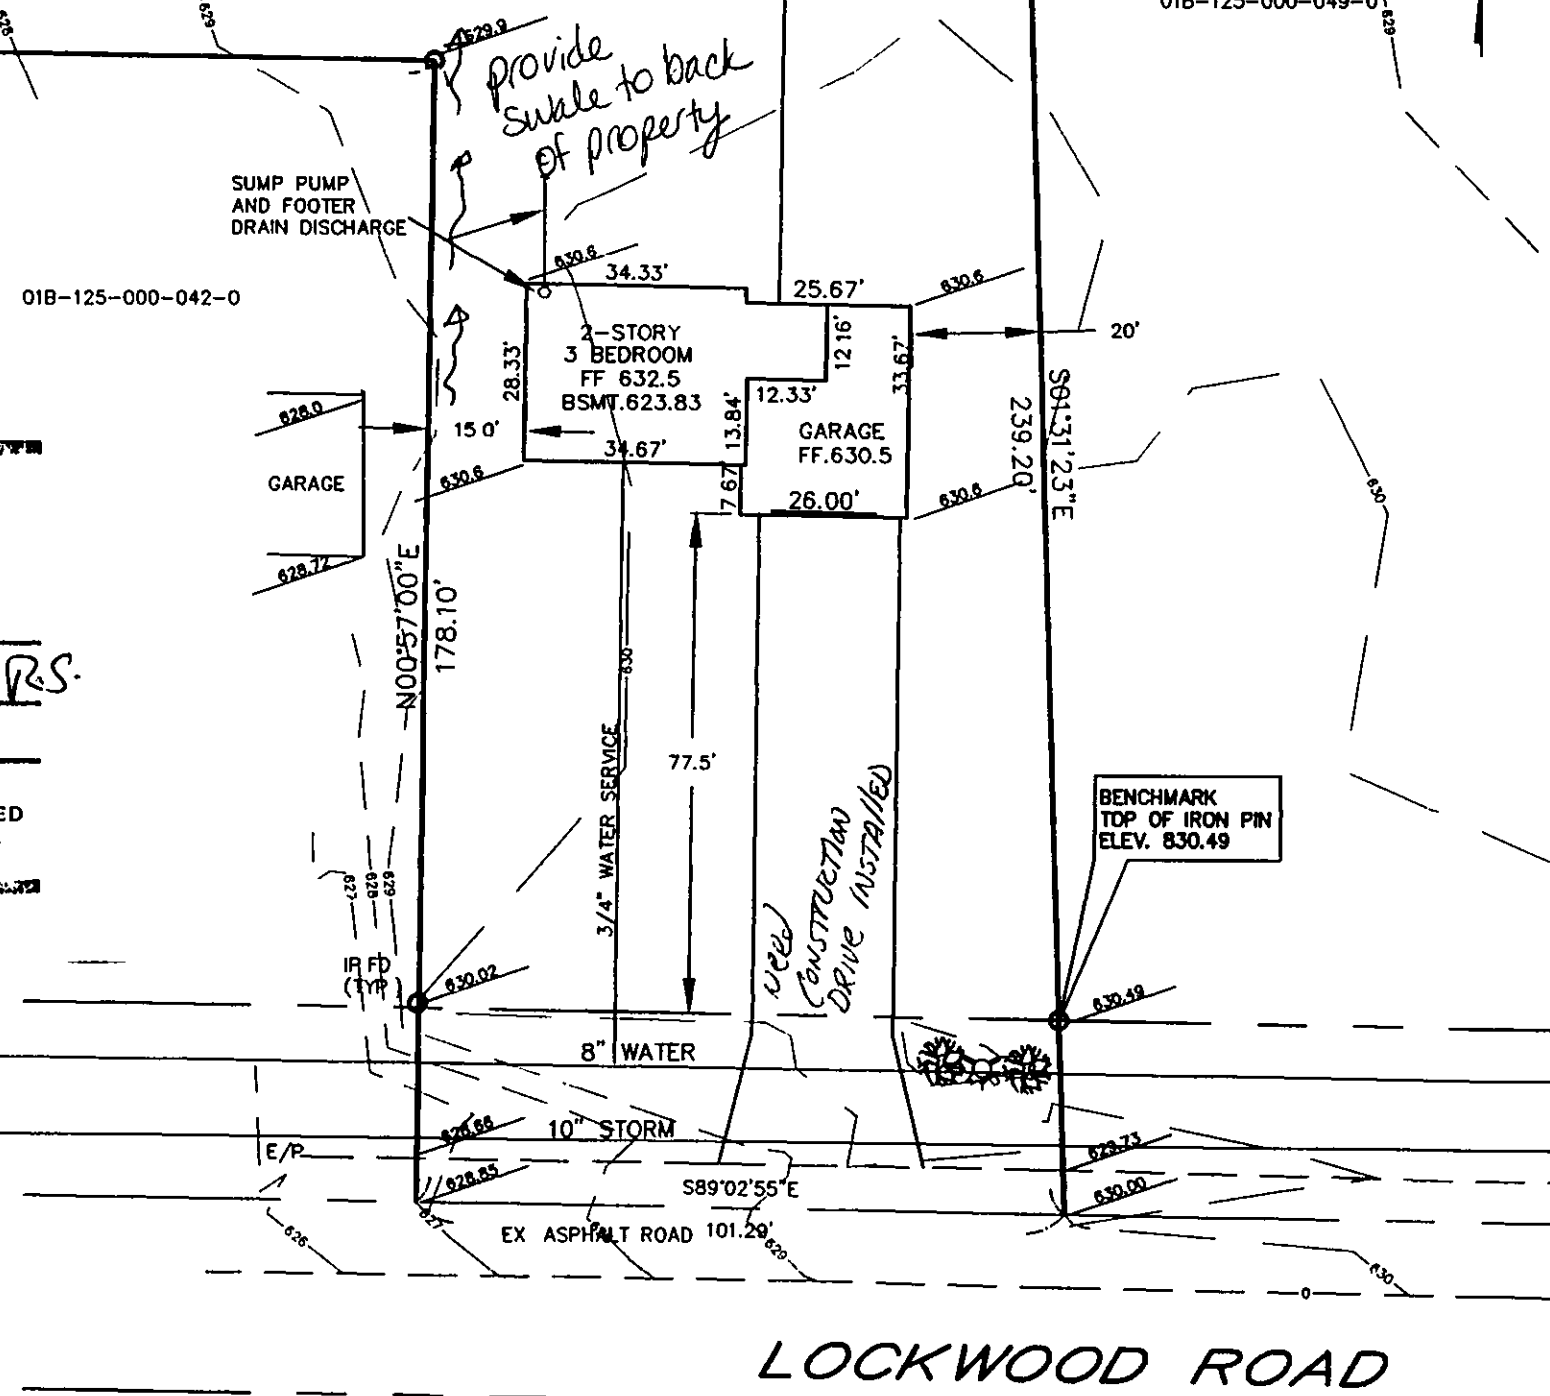

LOCKWOOD ROAD

COR Consultants, Inc.
23 S. Forest Street Geneva, Ohio 44041
440-466-8085

DATE: May, 2003
DRAWN BY: dar
CHECKED BY: mro
APPROVED BY: dar
P.S. No. 7597

DAVID WELCH
LOCKWOOD
MADISON TOWNSHIP

SITE PLAN

APPROVED
MADISON TOWNSHIP ZONING
DATE 6/6/03
BY *[Signature]* 7/3/77

Hor. Scale 1" = 30'
Vert. Scale 1" = 5'
23062
SHEET No. 1 OF 1