


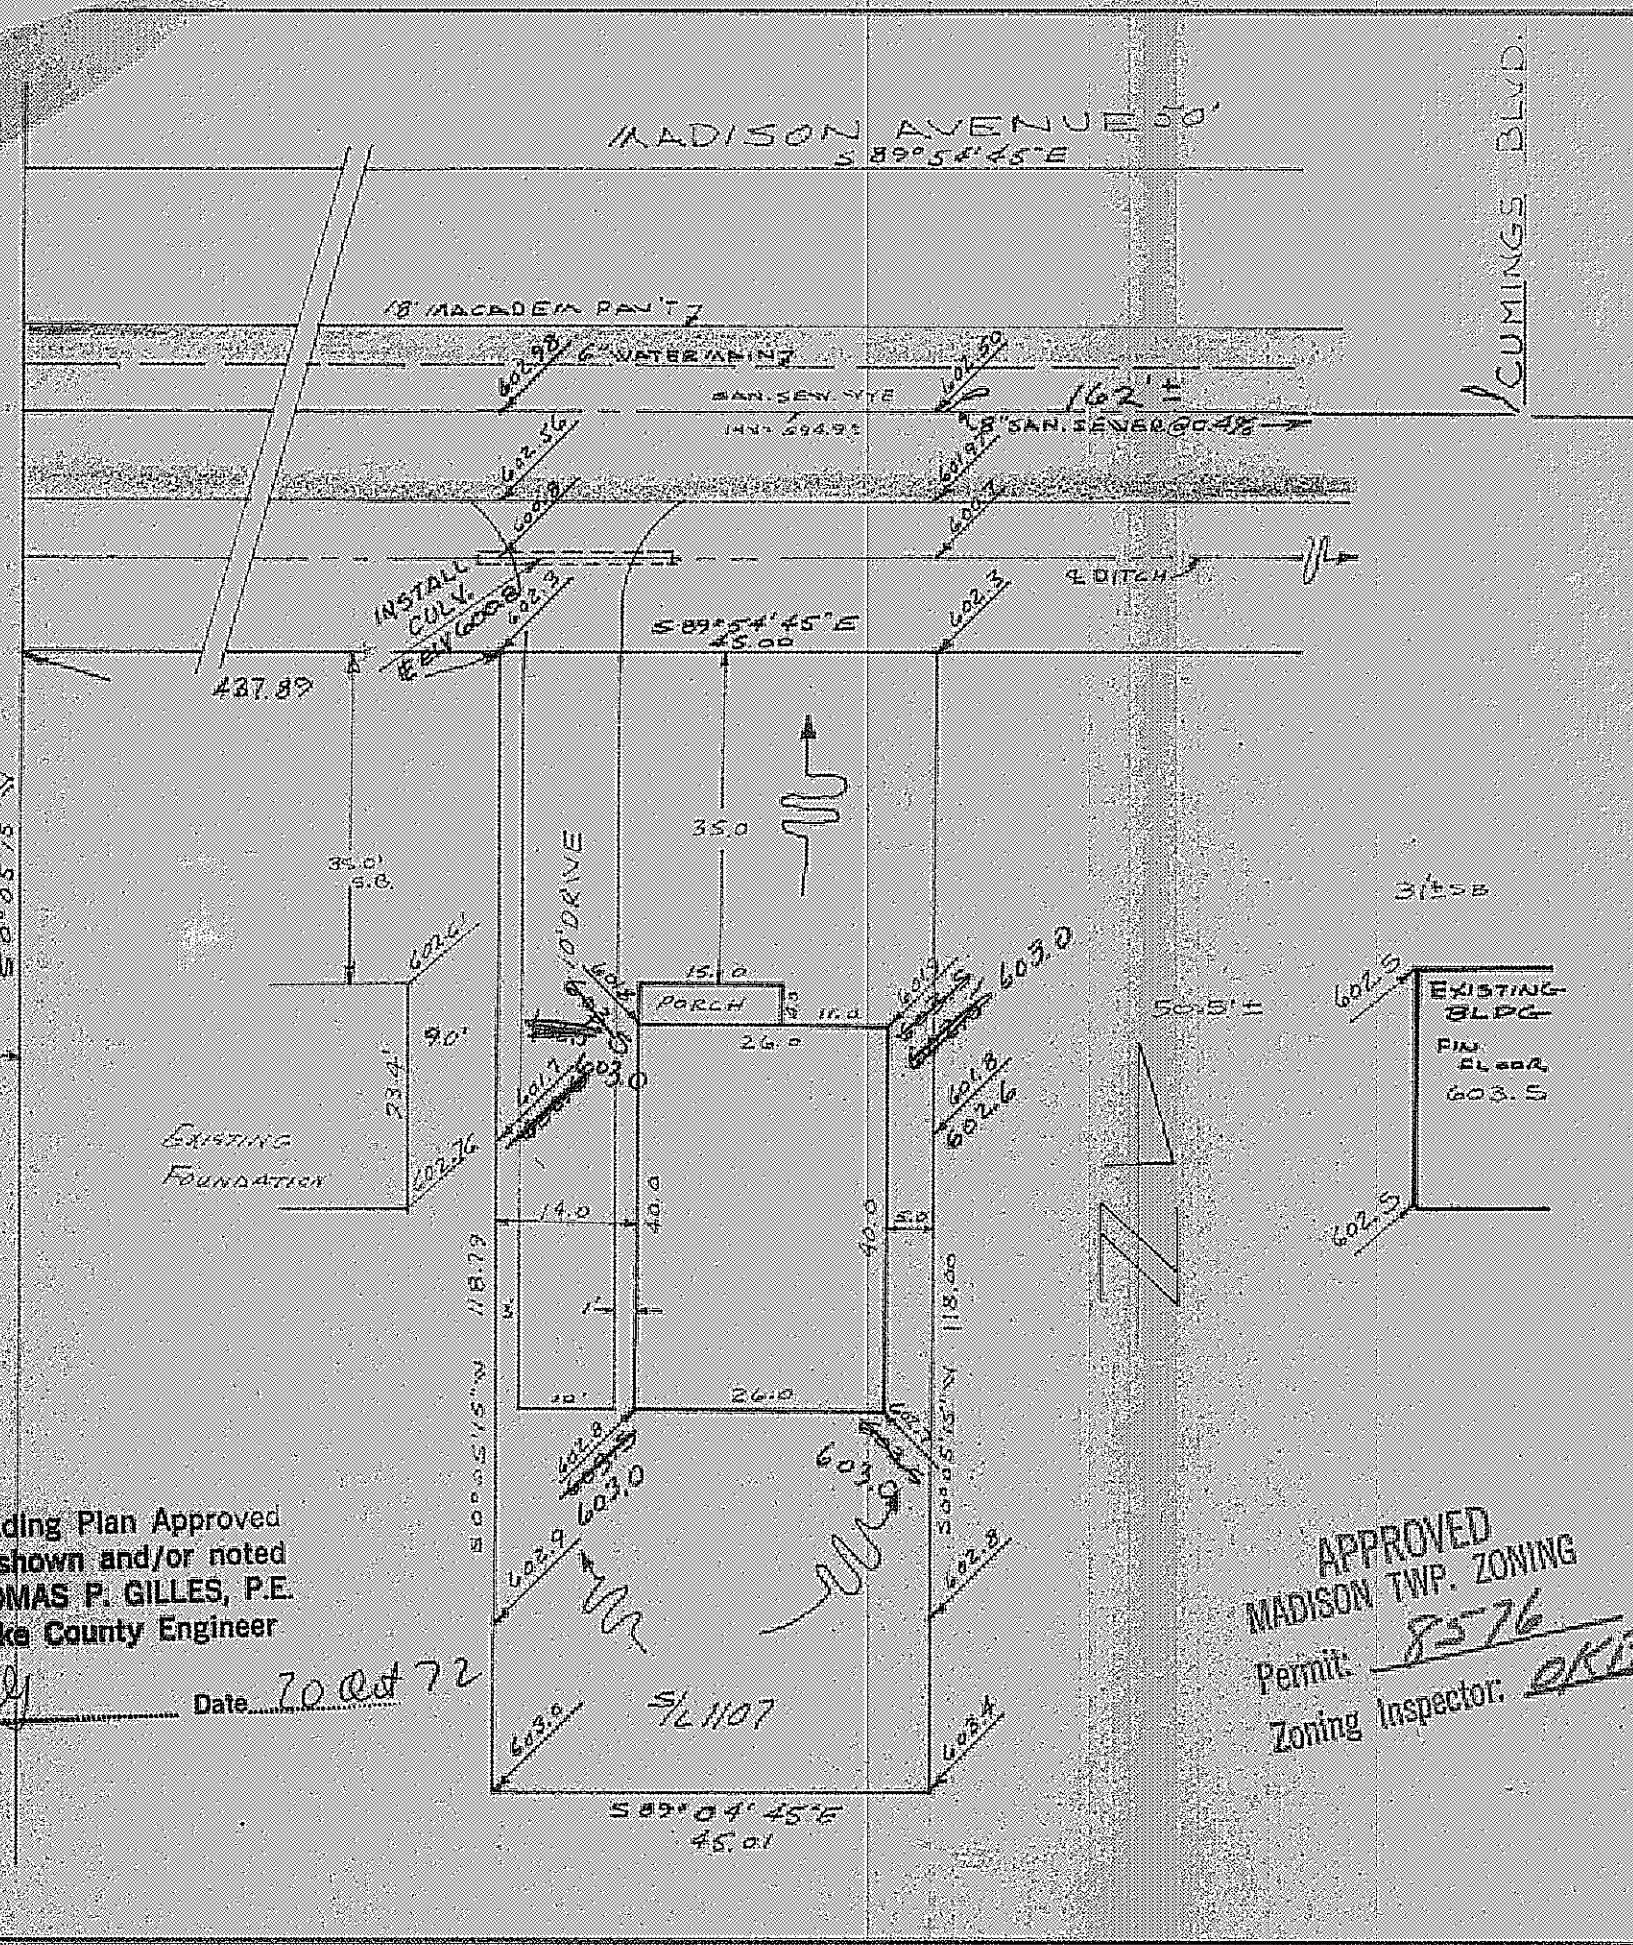

Grading Plan Approved
as shown and/or noted
THOMAS P. GILLES, P.E.
Lake County Engineer

By 7/22 Date 7/20/72

APPROVED
MADISON TWP. ZONING
Permit: 8576
Zoning Inspector: OKB

SITE PLAN

MADISON LAKE COUNTY, OHIO

TOWNSHIP
for RYON HOMES
CLIENT OWNER
6856 Madison Ave Madison 44057
ADDRESS STREET CITY ZIP

CURRING BEACH	LOT	TRACT
RECORD SUBDIVISION		
F		
VOLUME	PAGE	
1107	MADISON AVE	
SUBLOT 40	STREET	
	PERM PARCEL	STREET

LEGEND

SANITARY MANHOLE	WATER VALVE (GAS)
STORM MANHOLE	WATER METER (GAS)
INLET OR CATCH BASIN	AS BUILT ELEVATION
HYDRANT	
EXISTING CONTOURS	DIRECTION OF SURFACE DRAINAGE
PROPOSED CONTOURS	
EXIST ELEV	100.0
PROP ELEV	100.0

REMARKS

ALL BOUNDARY DATA SHOWN WAS OBTAINED FROM (DEEDS RECORDED SUBDIVISION PLAT OR OTHER PUBLIC RECORDS)

DESIGN CERTIFICATION

THIS PLAT WAS PREPARED BY ME, AND IS CORRECT TO THE BEST OF MY KNOWLEDGE AND BELIEF
Richard R. Hestfield P.S. #5506
NAME SURVEYOR REGISTRATION NO.

CHECK LIST

DIMENSIONS	WATER MAIN SIZE LOCATION
BEARINGS	SAN SEWER SIZE % GR LOC
TIE TO NEAREST STREET	SAN MH CAST ELEV INV ELEV
SUBLOT NO PARCEL NO	SAN CORR SIZE LOC DEPTH
SURROUNDING OWNERS	STORM SEWER SIZE % GR LOC
BLDG DIMENSIONS FIN GR	STORM MH CAST ELEV INV ELEV
BLDG TIES FLR GRADES	PAVT TYPE GRADE CURBS
APRON TYPE WIDTH THICKNESS	GAS LINE LOC SIZE PRESSURE
SIDEWALK TYPE WIDTH THICKNESS	SEPTIC TANK SIZE LOC
CULVERT TYPE DIA LENGTH	WELL LOCATION

REVISIONS			PLAN PREPARED BY:	
NO.	DATE	BY	DEBEVEC, SALO & ASSOC, INC.	
1	Aug 4 72	RJB	VILLAGE MEERS SURVEYORS	NAME
2			180 E JACKSON ST PAINESVILLE, O.	ADDRESS
3			DRAWN BY	SCALE
4			CHKD	DATE
5			FILED	DATE
6			CHIEF	DATE