

SITE PLAN FOR JEFF'S CONST.CO.

SCALE: 1" = 30'

BENCHMARK - 604.20
N. RIM SAN. M.H. : INV - 593.37

MADISON AVE 50'

8" SAN

8" WATER

Grading Plan Approved
as shown and/or noted
THOMAS P. GILLES, P.E.
Lake County Engineer

By 6JH Date 6/3/94
LOVER TO AS SHOWN


14th ~~RD.~~ 6999 MADISON AVE EXIST
BEING PART OF ~~SL 6554~~ OF 54, 56 & 58
VACATED MAPLE GROVE SUBD & ADDITIONAL
LANDS. IN THE TOWNSHIP OF MADISON,
LAKE 222 COUNTY, OHIO

N 01° 04' 30" W 315.00'

S 01° 04' 30" E 315.00'

D. 6147 Ac.

N 88° 55' 30" E 85.00'

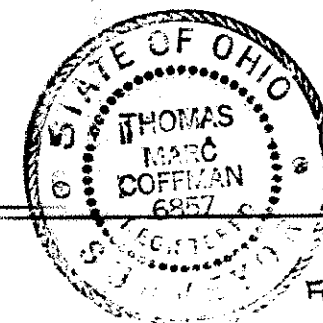

APPROVED
MADISON TWP. ZONING

Permit: 13028

Zoning Inspector: JM

SEP. 22 1989

VILLAGE SURVEYING CO.

202 THIRD ST. FAIRPORT HBR. OH. 44077

<216> 357-1359

I, the undersigned hereby certify that
this topography, indicated by 1' contours,
and elevations shown herein represent an
actual field survey made by me on 11-15-92
and that the elevations were taken at
appropriate intervals and that as of that
date they existed as indicated herein.

J.M. Coffman P.E.
No 6857