

WATER MAIN

MAPLE AVE. 40 ft.

STA 38+27.1 S.M.H.

BENCH MARK
S.M.H. RIM
EL. 590.31'

614
Tie existing storm sewer
to proposed yard drain

32495
Civil Engineer

SCALE: 1" = 10 ft.



LAKE COUNTY, OHIO

Lot 16 MADISON TOWNSHIP

SITE PLAN FOR RONALD J. WELSH

18 MAR 1995

JIM PETERLAND SURVEY
4759 CROSBY-COOK RD.
ROME, OHIO 44085
APPROVED
MADISON TOWNSHIP ZONING
MAR 23 1995
PERMIT # 14188
ZONING INSPECTION
950313

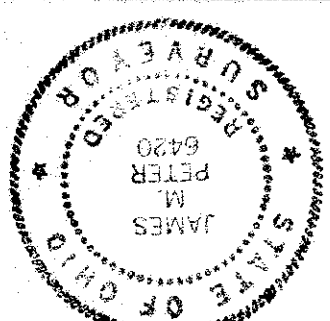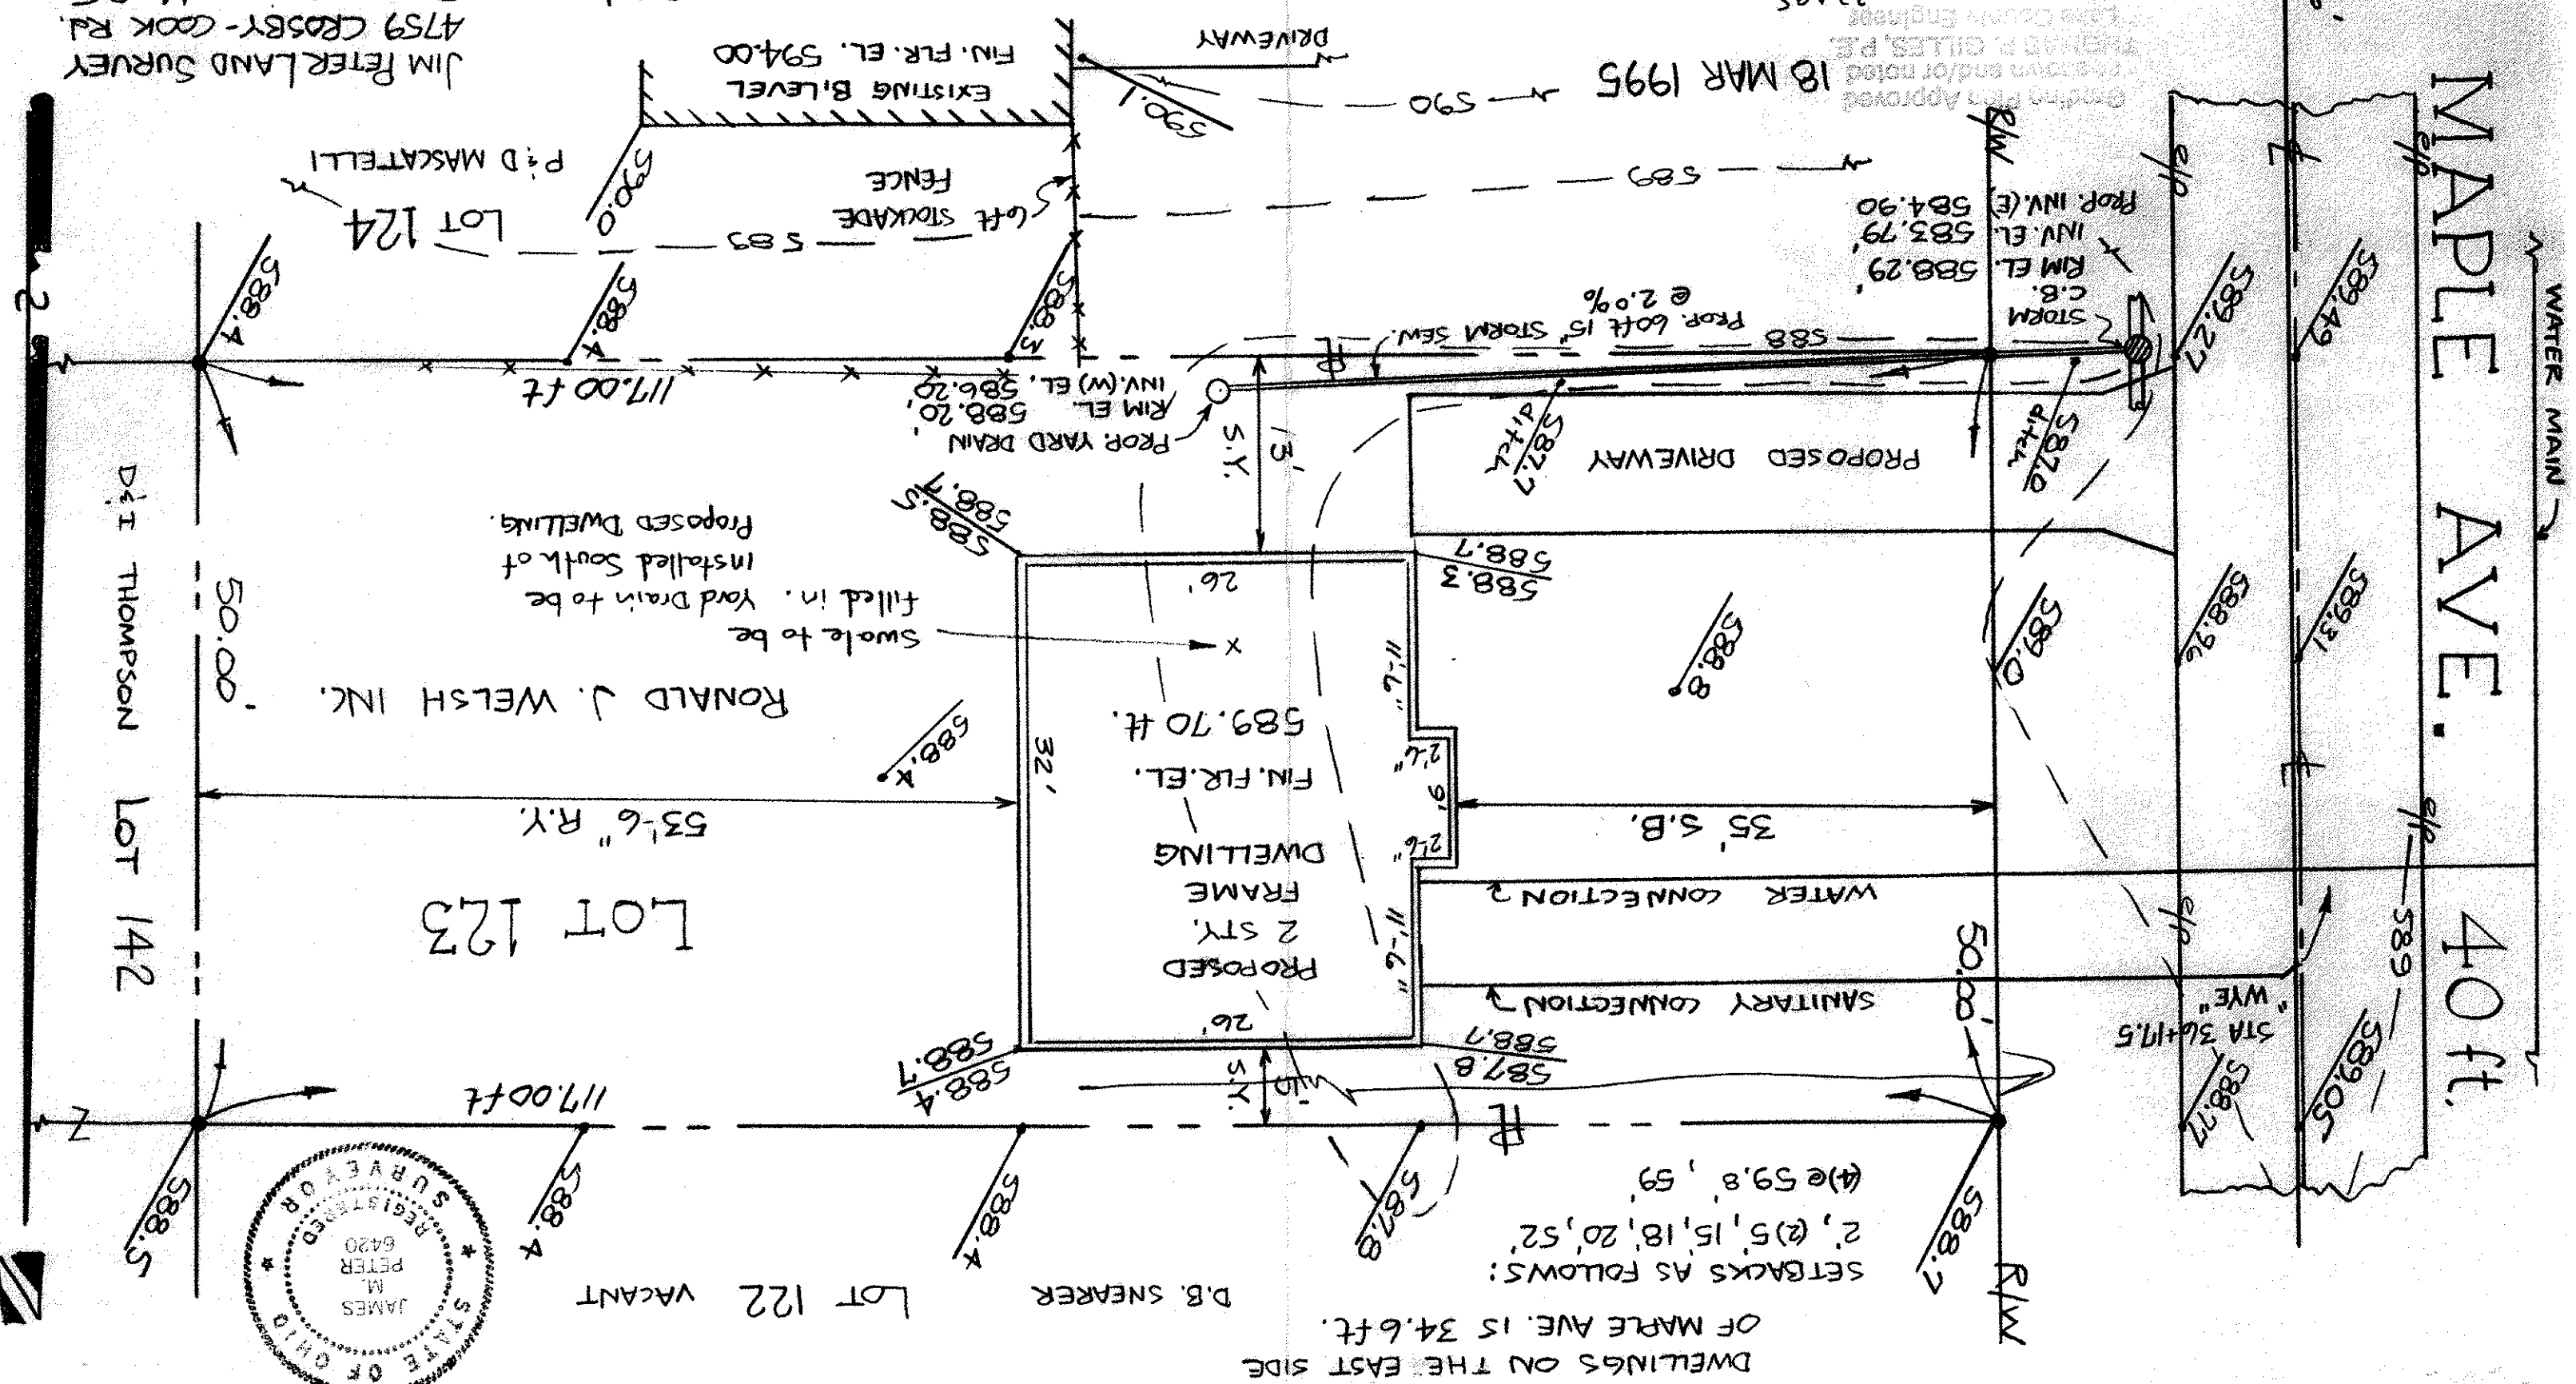

NOTE: AVE. SETBACK FOR DWELLING
D.WELLINGS ON THE EAST SIDE
OF MAPLE AVE. IS 34.6 ft.

SETBACKS AS FOLLOWS:
2', (2) 5', 15', 18', 20', 52',
(4) @ 59.8', 59'

LOT 122 VACANT D.B. SNEAKER