

Grading Plan Approved
as shown and/or noted
THOMAS P. GILLES, P.E.
Lake County Engineer

By OMP

Date 10-23-84 1314 132 LAKE BREEZE PARK
MADISON TOWNSHIP
LAKE CO OHIO
1" = 30' Oct. 1984

SITE PLAN

for



PAC HOMES

APPROVED
MADISON TWP. ZONING

Permit: 11467

Zoning Inspector: RCM

Milton A. Boonhauer
Reg. Surveyor #2247

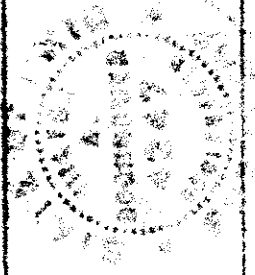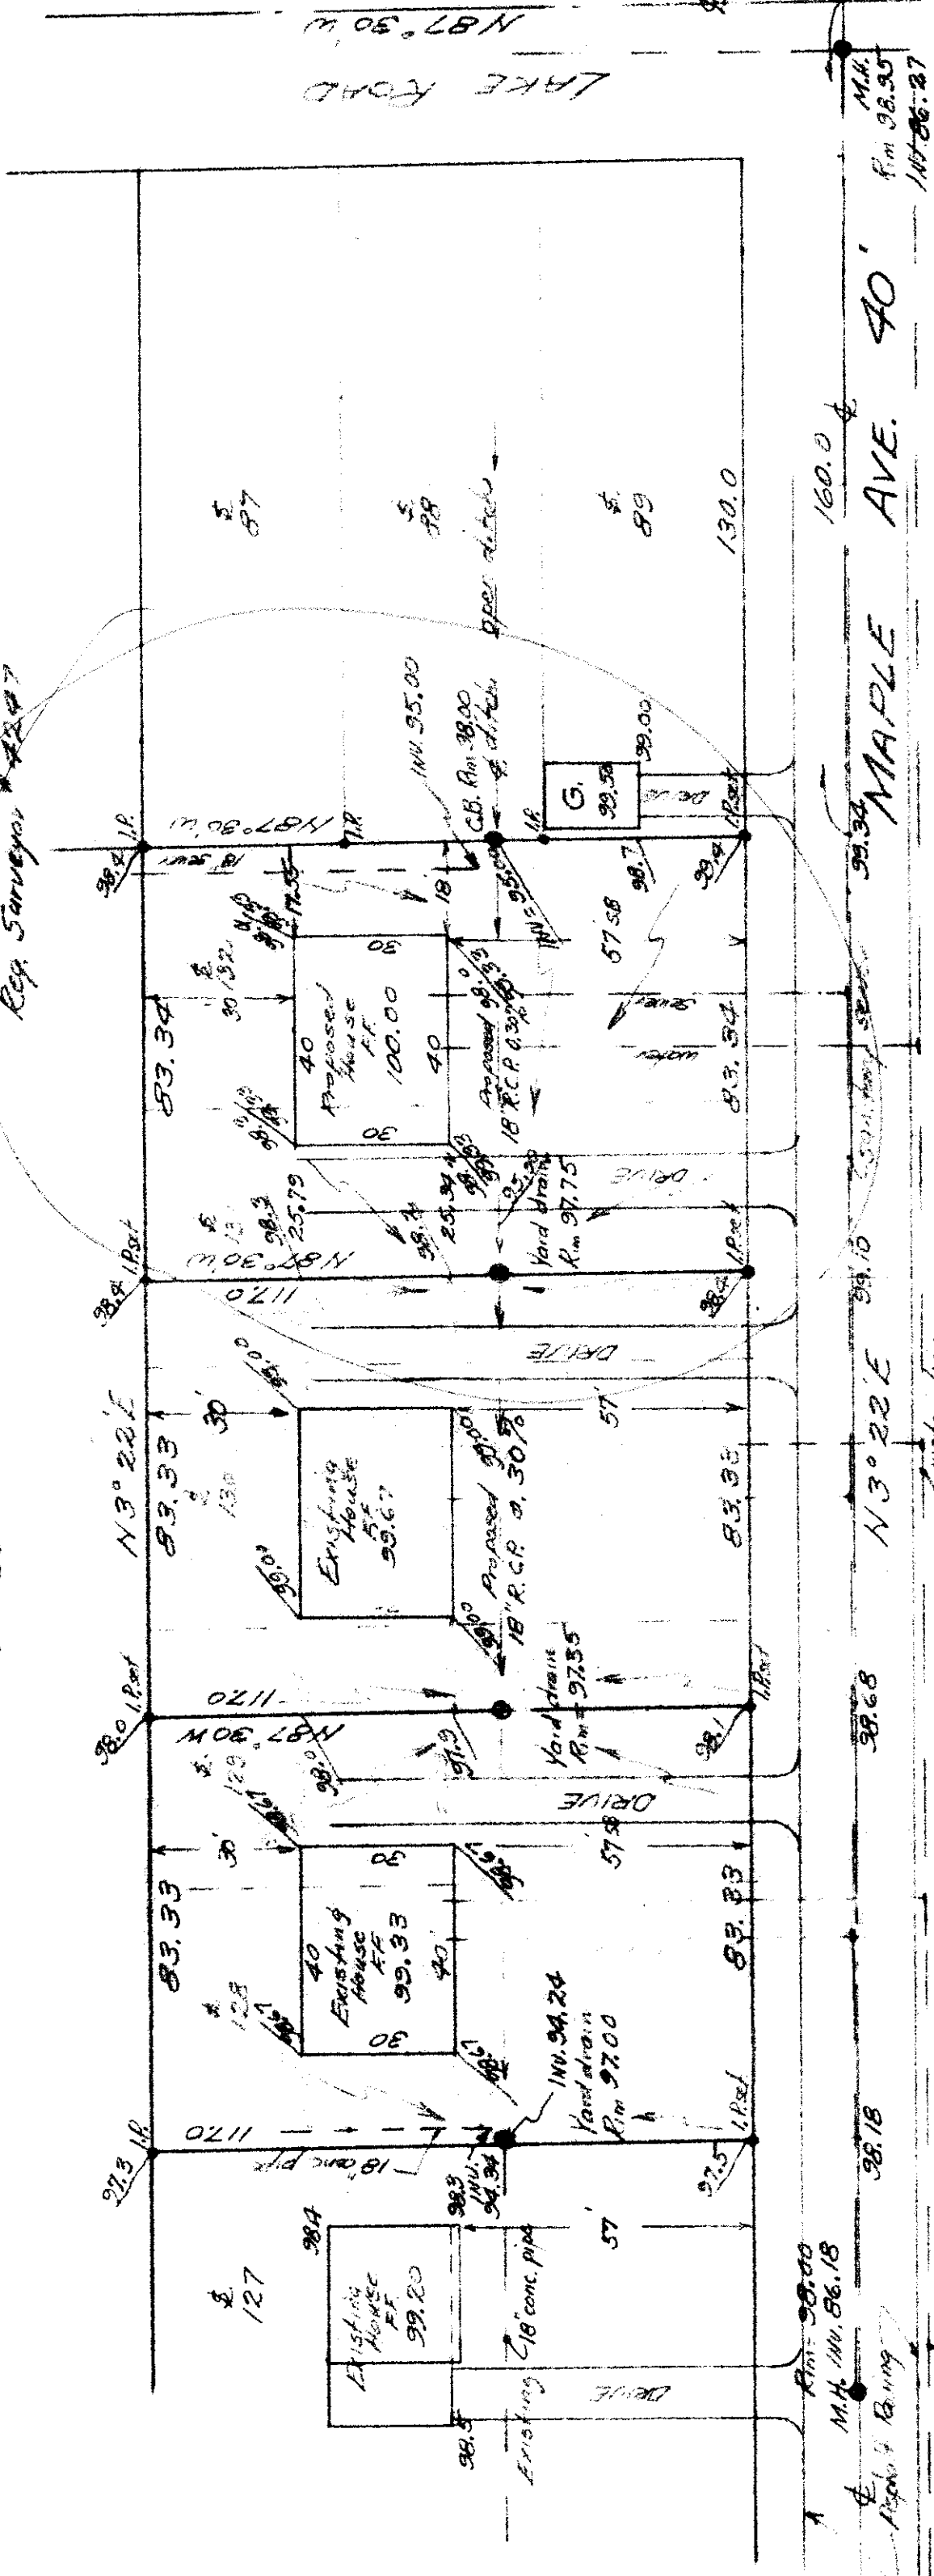

B.M. Top hyd.
100.00