



SITE PLAN
 TOWNSHIP: MADISON COUNTY, OHIO
 for: PAUL BEACIT
 ADDRESS: MADISON, OH CITY: OH ZIP: 43055
 SUBDIVISION: NAME LOT: 8 TRACT: 1
 VOLUME: 100 STREET: LOCKWOOD ROAD PARCEL NO.: 100
 SUBLOT NO.: 100 STREET: LOCKWOOD ROAD PARCEL NO.: 100

LEGEND
 SANITARY MANHOLE: WATER VALVE (GAS):
 STORM MANHOLE: WATER METER (GAS):
 WILEY OR CATCH BASIN: AS BUILT ELEVATION:
 HYDRANT: INDICATES:
 EXISTING CONTOURS: DIRECTION OF:
 PROPOSED CONTOURS: SURFACE DRAINAGE:

REMARKS
 ALL BOUNDARY DATA SHOWN WAS OBTAINED FROM IDEEDS, RECORDED SUBDIVISION PLAT OR OTHER PUBLIC RECORDS.
 LOCATIONS AS SHOWN OF ADJACENT WELLS AND SEPTIC TANKS OBTAINED FROM LAKE COUNTY HEALTH DEPARTMENT.

DESIGN CERTIFICATION
 THIS PLAT WAS PREPARED BY ME, AND IS CORRECT TO THE BEST OF MY KNOWLEDGE AND BELIEF.
William C. Jones SURVEYOR REGISTRATION NO. 83-014

CHECK LIST

NO. OF BEDROOMS	NO. OF BATHS	NO. OF GARAGES	NO. OF POOLS	NO. OF SHEDS	NO. OF TRAILERS	NO. OF OTHER BUILDINGS	NO. OF OTHER STRUCTURES	NO. OF OTHER UTILITIES	NO. OF OTHER FEATURES
1	1	1	1	1	1	1	1	1	1


REVISIONS

NO.	DATE	BY	DESCRIPTION
1			
2			
3			
4			
5			

PLAN PREPARED BY:
 BABCOCK • JONES & ASSOCIATES, INC.
 PAINESVILLE, OHIO
 DRAWN BY: WJ SCALE: 1" = 30' PHONE NO.: 357-1811
 CHECKED: WJ DATE: Feb 83 DRAWING NO.: 83-014
 APP'D: WJ

APPROVED
 11/49
 Permit: 1149
 Zoning Inspector: WJ

Grading Plan Approved
 as shown and/or noted
 THOMAS P. GILLES, P.E.
 Lake County Engineer
 By: WJ Date: 3-3-83

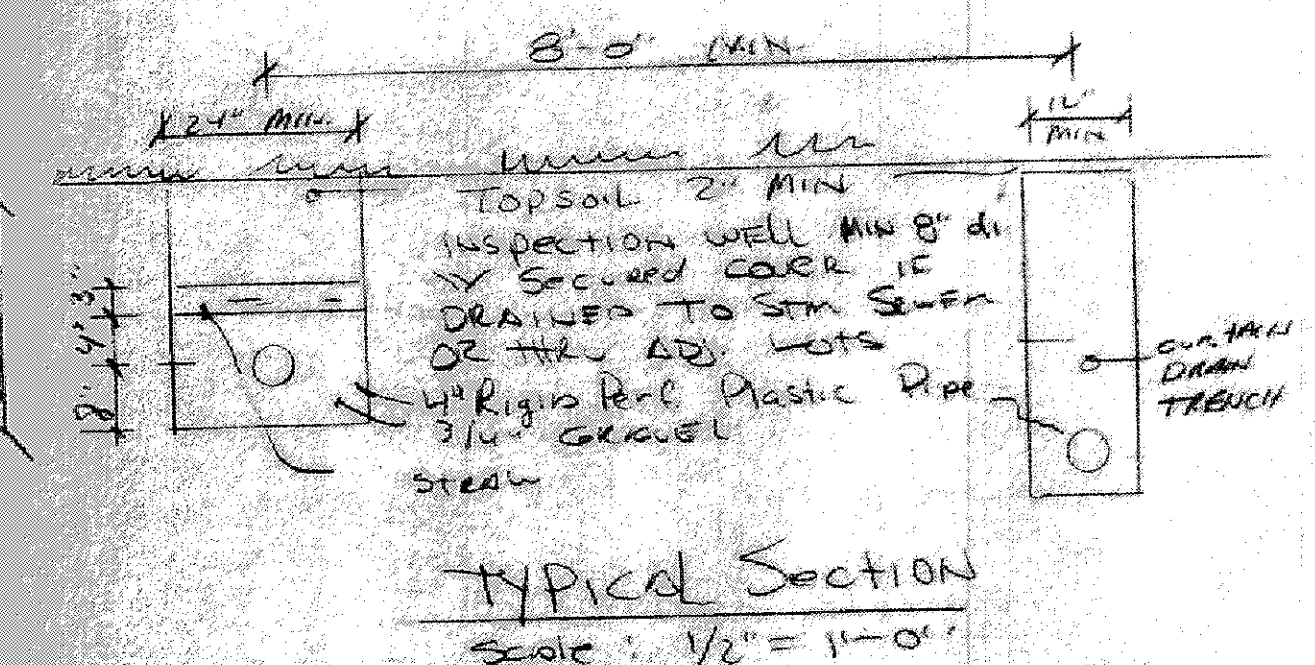

REV. NO.	DESCRIPTION	DATE	BY	CHKD
1				
2				
3				
4				
5				

BABCOCK, JONES AND ASSOCIATES, INC.
 CIVIL ENGINEERS - SURVEYORS - LAND PLANNERS
 PAINESVILLE, OHIO 44077

DATE	DESIGN BY	DRAWN BY	APPROVED BY
1/18/83	WJ	WJ	WJ

SCALE	JOB NO.	SHEET	OF
1" = 30'	83-014	1	1