


HYDRAULIC PROFILE
HORIZ: 1"=40' VERT: 1"=5'

Grading Plan Approved
as shown and/or noted
JAMES R. GILLS, P.E.
Lake County Engineer

By JAM Date 9/20/01
I Swear as shown.
A permit will be required for utility work
within R/W

ROOF DRAINS
SHALL DISCHARGE
TO SPLASH BLOCKS.

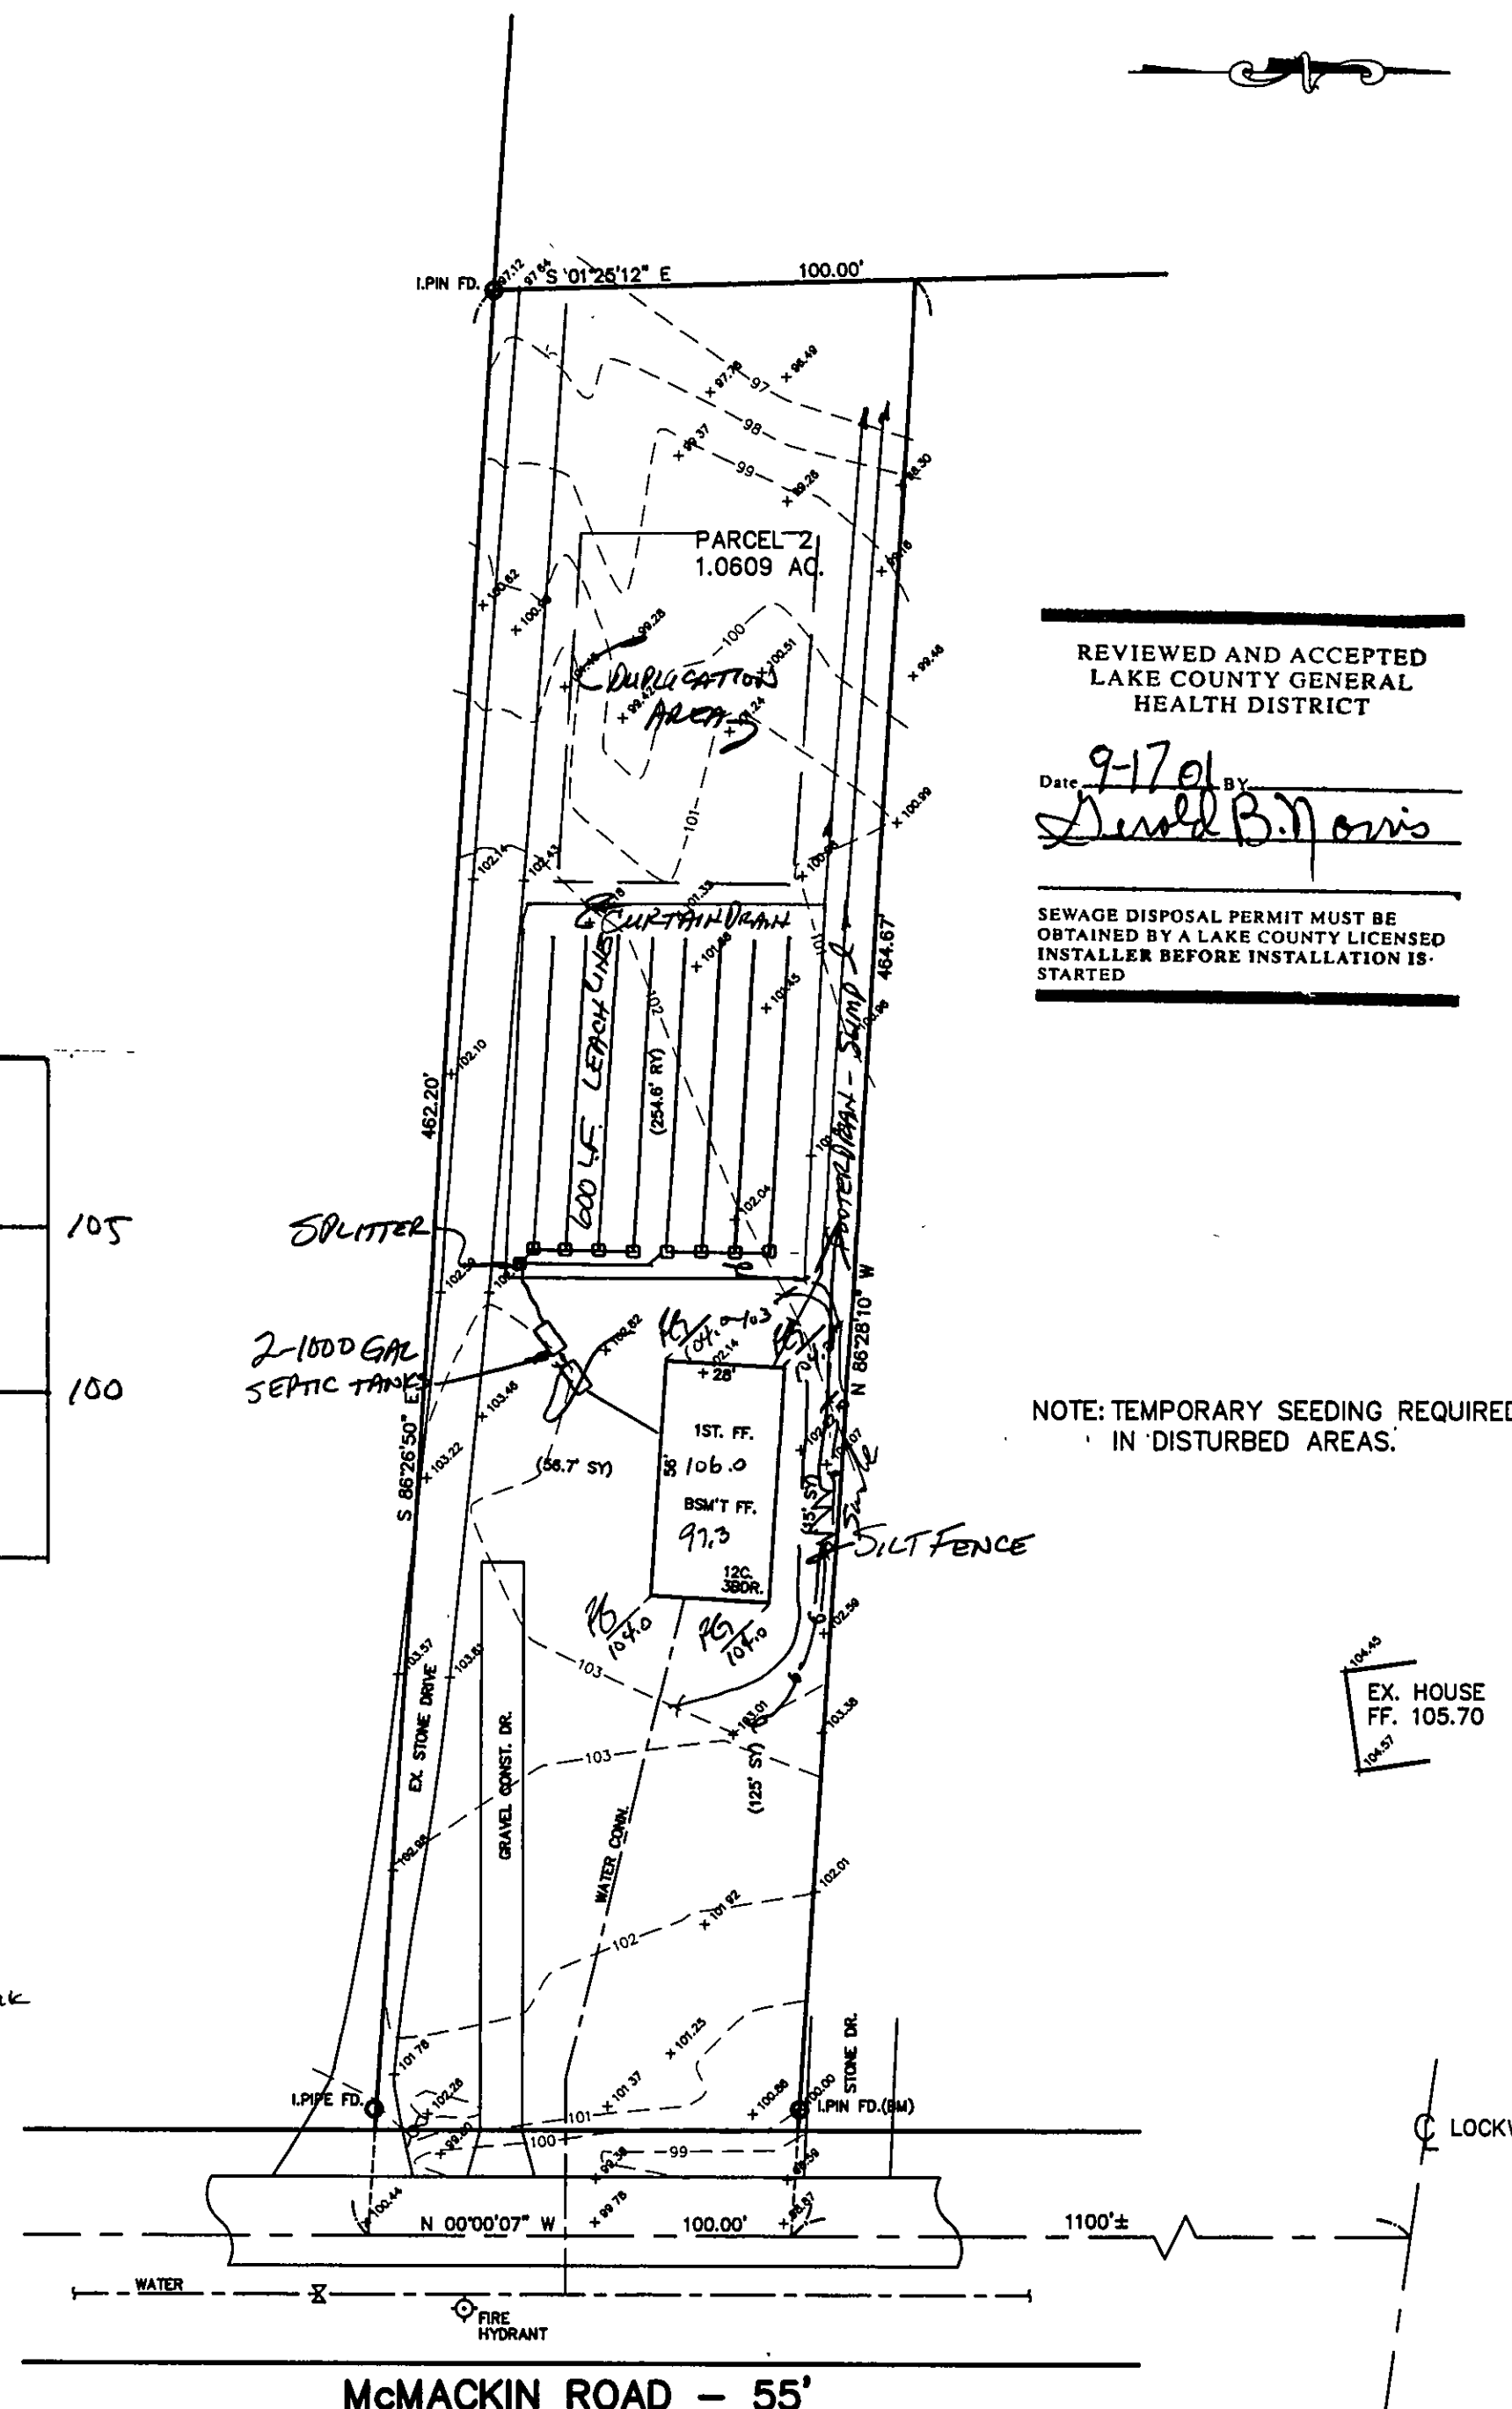

REVIEWED AND ACCEPTED
LAKE COUNTY GENERAL
HEALTH DISTRICT

Date 9-17-01 BY
Daniel B. Morris

SEWAGE DISPOSAL PERMIT MUST BE
OBTAINED BY A LAKE COUNTY LICENSED
INSTALLER BEFORE INSTALLATION IS
STARTED

NOTE: TEMPORARY SEEDING REQUIRED
IN DISTURBED AREAS.

EX. HOUSE
FF. 105.70

LOCKWOOD RD.

McMACKIN ROAD - 55'

SITE PLAN

MADISON TOWNSHIP, LAKE COUNTY, OHIO

for: VERONICA SCHLEE

CLIENT: VERONICA SCHLEE OWNER: VERONICA SCHLEE
ADDRESS: 6568 TARBELL DR. STREET: MADISON TWP. CITY: 44057 ZIP:

SUBDIVISION: VERONICA SCHLEE NAME: VERONICA SCHLEE TRACT: McMACKIN RD.
VOL.-Pg.: LOT: 18-124-23
SUBLOT NO.: STREET: VOL.-Pg.: PERM. PARCEL NO.:

LEGEND

SANITARY MANHOLE: 100.0
STORM MANHOLE: 100.0
INLET OR CATCH BASIN: 100.0
HYDRANT: 100.0
EXISTING CONTOURS: 100.0
PROPOSED CONTOURS: 100.0

EXIST. ELEV. 100.0
PROP. ELEV. 100.0
AS BUILT ELEVATION
INDICATES
DIRECTION OF
SURFACE DRAINAGE

REMARKS

ALL BOUNDARY DATA SHOWN WAS OBTAINED FROM (DEEDS, RECORDED
SUBDIVISION PLAT OR OTHER PUBLIC RECORDS)

LOCATIONS AS SHOWN OF ADJACENT WELLS AND SEPTIC TANKS OBTAINED FROM
LAKE COUNTY HEALTH DEPARTMENT

DESIGN CERTIFICATION

THIS PLAT WAS PREPARED BY ME, AND IS CORRECT
TO THE BEST OF MY KNOWLEDGE AND BELIEF.

NAME: Harry S. Jones, Jr. SURVEYOR: 440343 REGISTRATION NO.:

CHECK LIST

NO. OF BEDROOMS
DIMENSIONS
BEARINGS
TIE TO NEAREST STREET
SUBLOT NO. PARCEL NO.
SURROUNDING OWNERS
BLDG. DIMENSIONS FIN GR.
BLDG. TIES F.T.R. GRADES
APRON TYPE WIDTH THICKNESS
SIDEWALK TYPE WIDTH THICKNESS
CULVERT TYPE DIA. LENGTH
ROCK OUTCROPPINGS

WATER MAIN SIZE, LOCATION
SAN. SEWER SIZE & GR. LOC.
SAN. MH. CAST. ELEV. INV. ELEV.
SAN. CONN. SIZE, LOC. DEPTH
STORM SEWER SIZE & GR. LOC.
STORM MH. CAST. ELEV. INV. ELEV.
PAV'T TYPE GRADE CURBS
GAS LINE LOC. SIZE PRESSURE
SEPTIC TANK LOCATION & DUPLICATION AREA
WELL LOCATION
ISOLATION RADIUS FROM WELL

REVISIONS			PLAN PREPARED BY:		
NO.	DATE	BY	BABCOCK JONES & ASSOCIATES, INC.		
1	8/28/01	TR.	PANESVILLE, OHIO		
2	9/11/01	TR.	DRAWN BY T.R. SCALE 1"=40' PHONE NO. 440-357-1811		
3	9/14/01	HJ	DATE 6/2/01 DRAWING NO. 01-064		
4		CHK'D. H.J.			
5		CHK'D. R.B.			

"AS BUILT" CERTIFICATION
I, HEREBY CERTIFY THAT THE CIRCLED GRADES ARE EXISTING
FINISH GRADES CHECKED IN THE FIELD ON 6/2/01, 2001
AND ARE CORRECT TO THE BEST OF MY KNOWLEDGE AND BELIEF.

REGISTERED SURVEYOR

REG. NO.

BM-IRON PIN FOUND
ELEV.=100.00

APPROVED
MADISON TOWNSHIP ZONING
DATE 9/19/01
BY Chl 20674

"I, the undersigned hereby certify that
this topography indicated by 6", 1', or 2'
contours, and elevations shown hereon
represent an actual field survey made by
me on the 12 day of JUNE, 2001
and that the elevations were taken at
appropriate intervals and that as of that
date they existed as indicated hereon."

Name: Harry S. Jones, Jr. Reg. No.: 440343

