


10/7/93

SITE PLAN for BRIAN SHUSS LOT 9 TRACT 4 MADISON TOWNSHIP

BRIAN SHUSS
1855 MINI RANCH TRAIL
GENEVA, OHIO 44041
PH. 466-0150



EX WELL
LOW YIELD WATER
FIXTURES REQUIRED
ON ALL:
Shower Head
Toilet

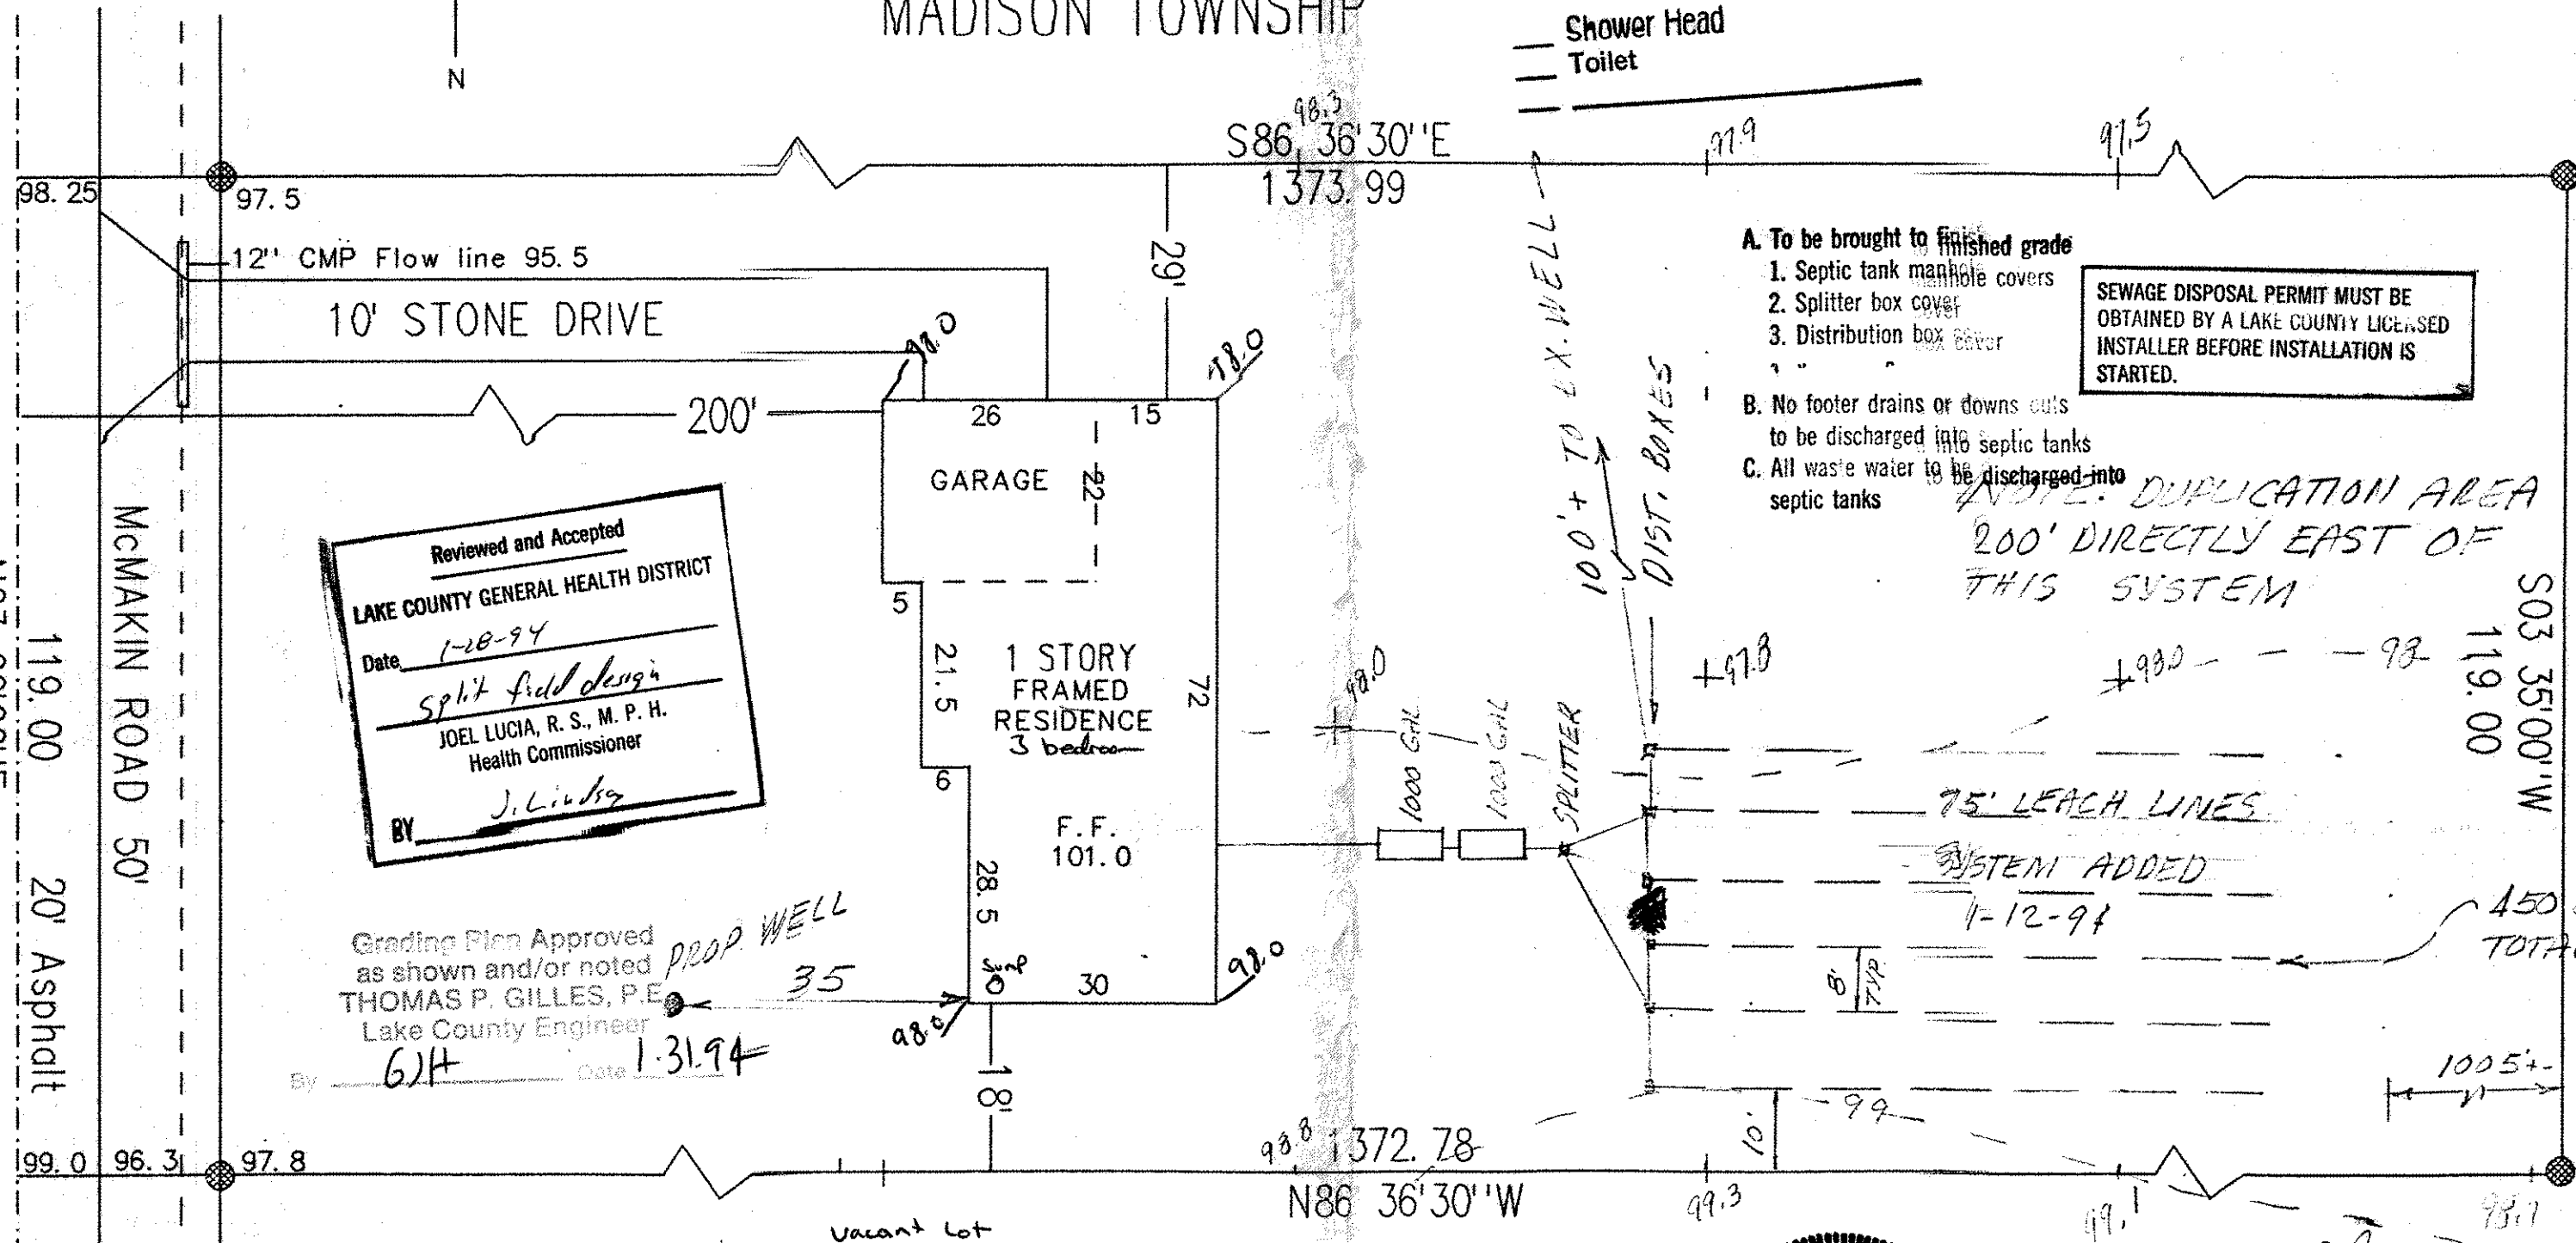

Reviewed and Accepted
LAKE COUNTY GENERAL HEALTH DISTRICT
Date 1-28-94
Split field design
JOEL LUCIA, R. S., M. P. H.
Health Commissioner
BY J. Lucia

Grading Plan Approved
as shown and/or noted
THOMAS P. GILLES, P.E.
Lake County Engineer
By GJH Date 1-31-94


- A. To be brought to finished grade
1. Septic tank manhole covers
 2. Splitter box cover
 3. Distribution box cover
- B. No footer drains or down outs to be discharged into septic tanks
- C. All waste water to be discharged into septic tanks

SEWAGE DISPOSAL PERMIT MUST BE OBTAINED BY A LAKE COUNTY LICENSED INSTALLER BEFORE INSTALLATION IS STARTED.

NOTE: DUPLICATION AREA
200' DIRECTLY EAST OF
THIS SYSTEM

● Indicates Iron Pin Found
SCALE 1"=20'

B.M. Nail in Power Pole #555785, 60'
South of South Property Line,
Elevation= 100.00

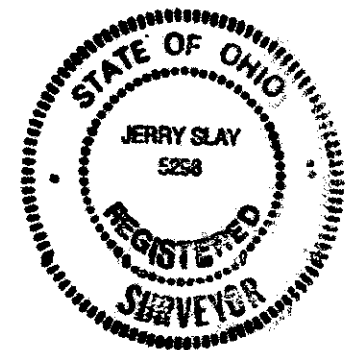

Jerry Slay
Ohio Surveyor Number 5298