


ROOF DRAINS SHALL DISCHARGE TO SPLASH BLOCKS.


Grading Plan Approved as shown and/or noted JAMES R. GILLS, P.E. Lake County Engineer

By *[Signature]* Date 10/2/02

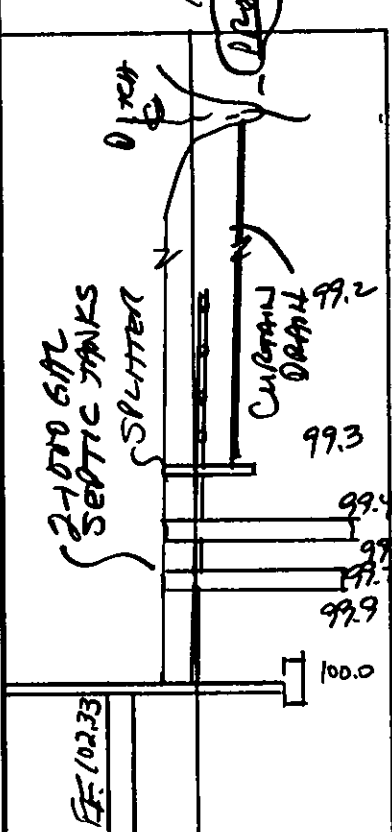

HYDRAULIC PROFILE  
1700' x 30' x 15'

MIDDLE Ridge Rd.

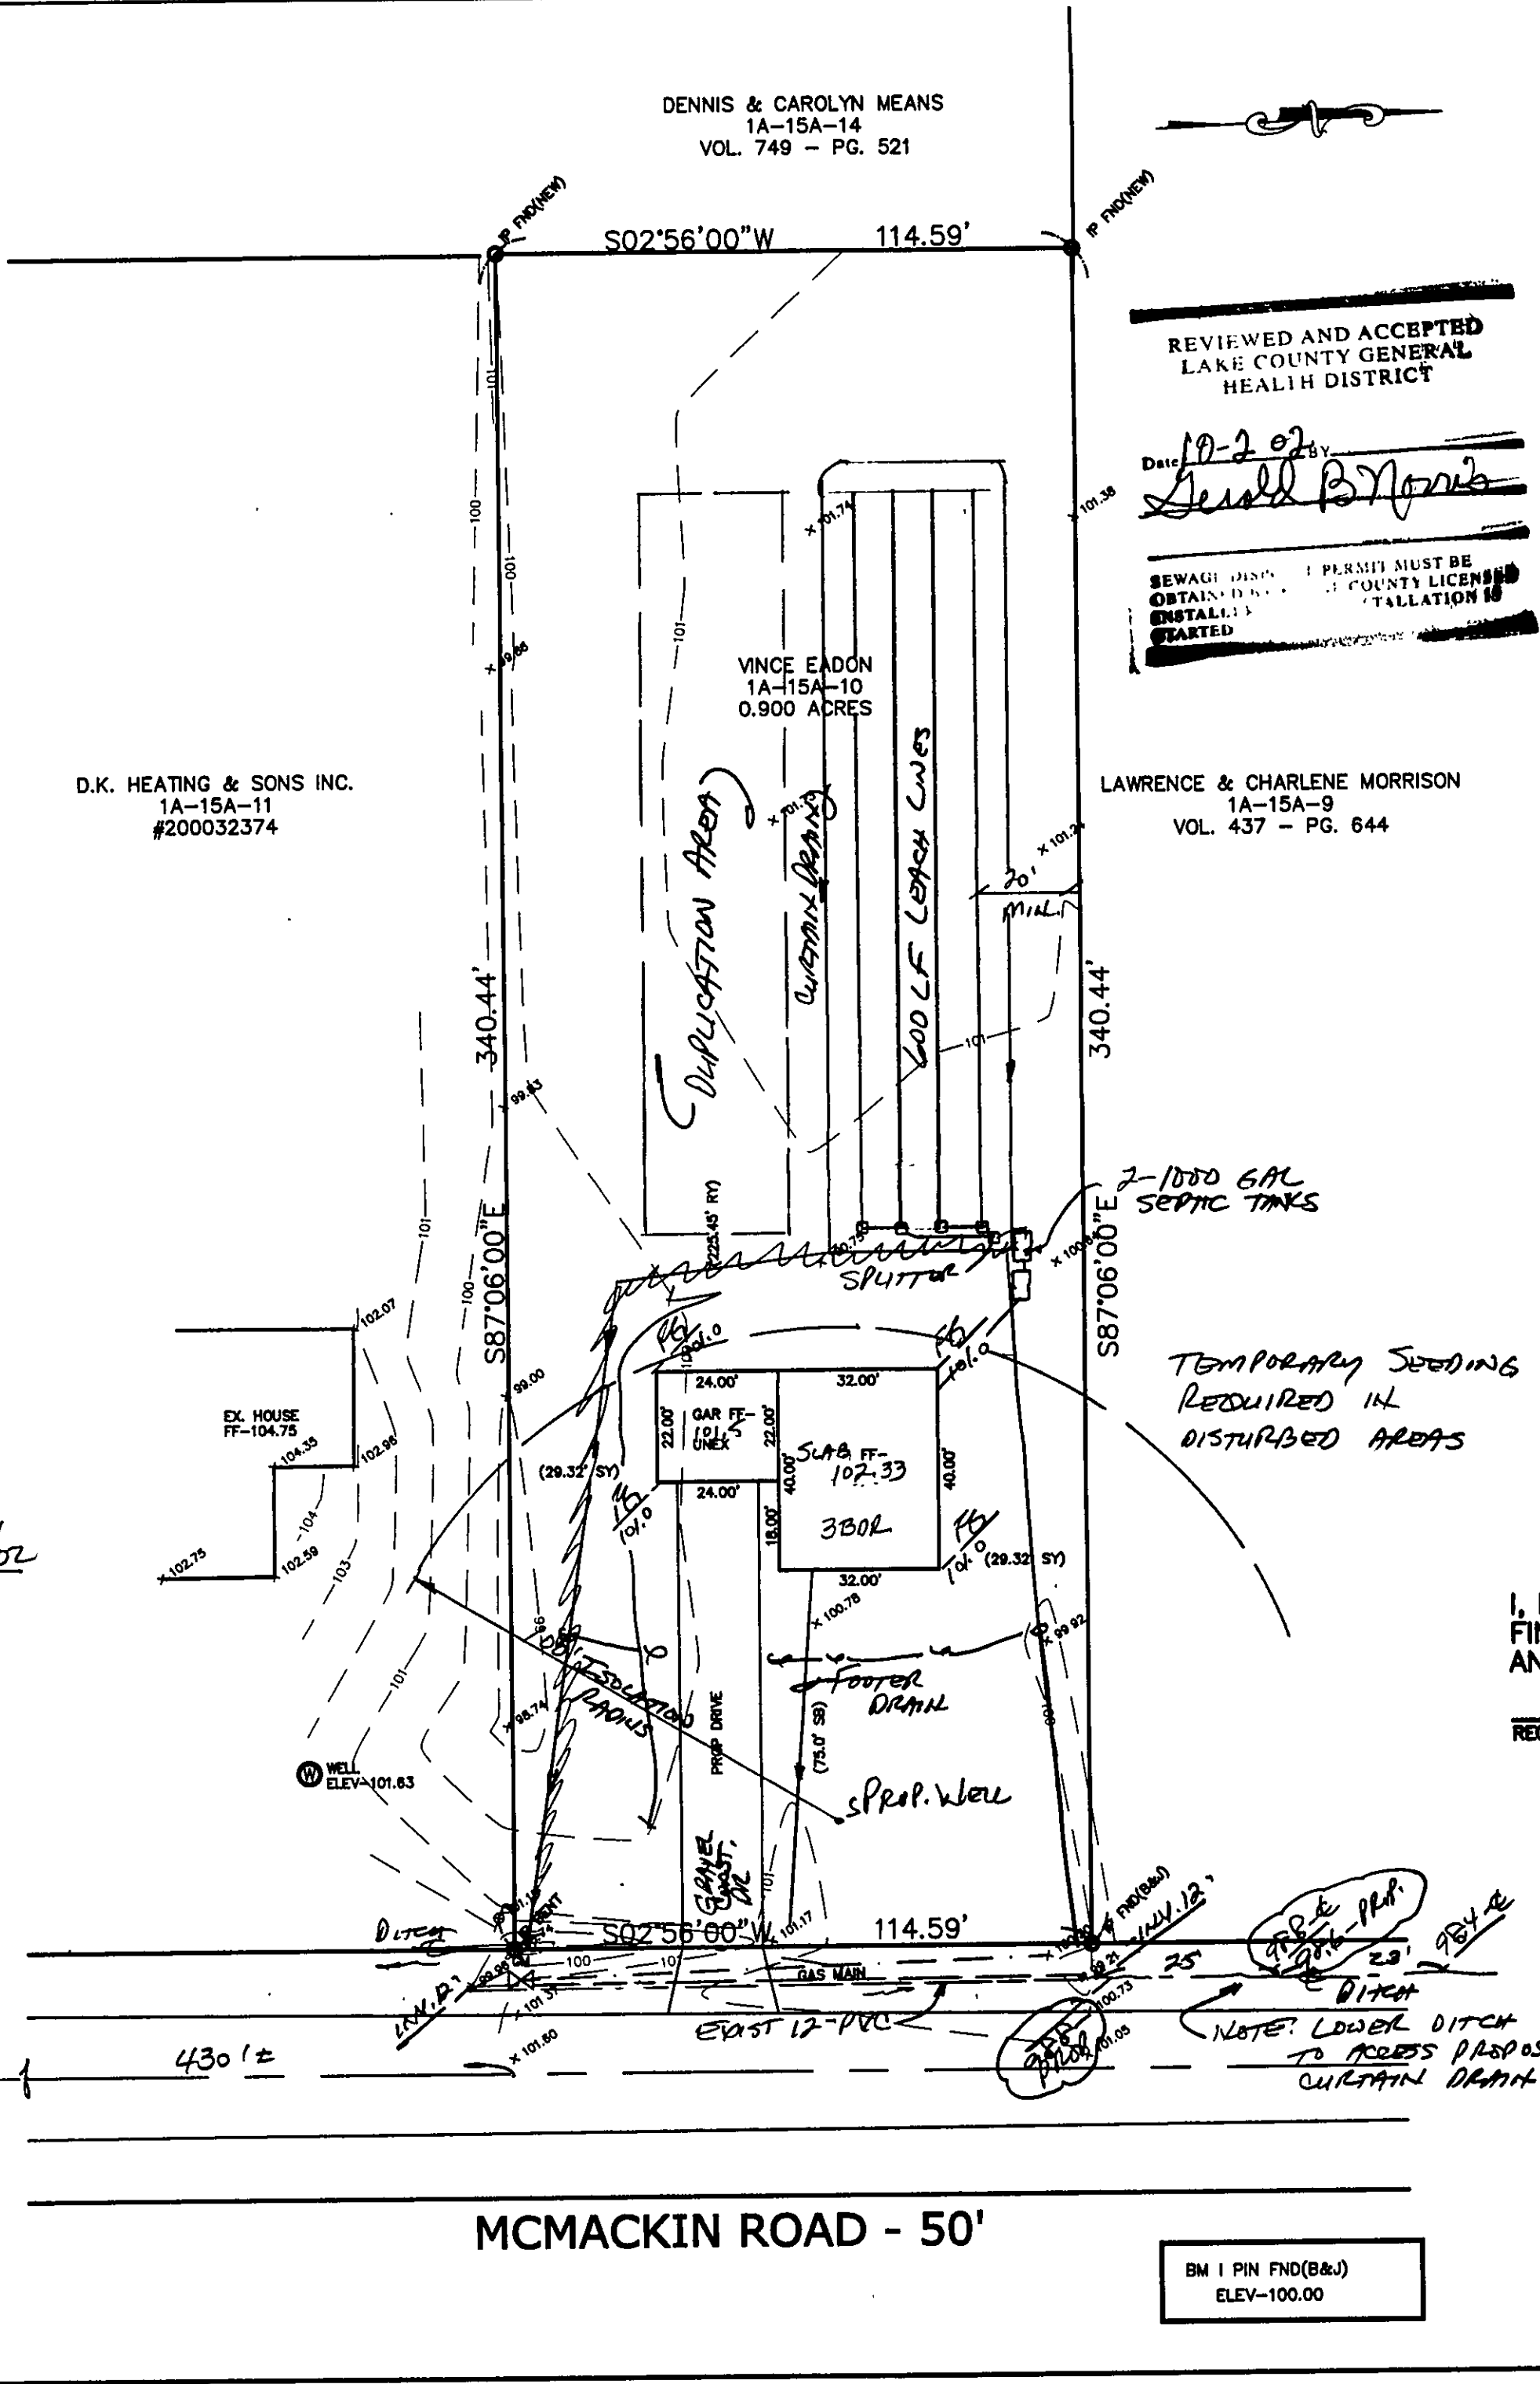

DENNIS & CAROLYN MEANS  
1A-15A-14  
VOL. 749 - PG. 521

D.K. HEATING & SONS INC.  
1A-15A-11  
#200032374

VINCE EADON  
1A-15A-10  
0.900 ACRES

LAWRENCE & CHARLENE MORRISON  
1A-15A-9  
VOL. 437 - PG. 644

REVIEWED AND ACCEPTED  
LAKE COUNTY GENERAL  
HEALTH DISTRICT

Date 10-2-02  
*[Signature]*

SEWAGE DISPOSAL PERMIT MUST BE OBTAINED FROM LAKE COUNTY HEALTH DEPARTMENT BEFORE INSTALLATION OF TREATMENT SYSTEM

LAWRENCE & CHARLENE MORRISON  
1A-15A-9  
VOL. 437 - PG. 644

2-1000 GAL SEPTIC TANKS

TEMPORARILY SEEDINGS REQUIRED IN DISTURBED AREAS

BM 1 PIN FND(B&J)  
ELEV-100.00

SITE PLAN

MADISON TOWNSHIP LAKE COUNTY, OHIO

for: VINCE EADON 537-6370  
CLIENT OWNER

ADDRESS	STREET	CITY	ZIP
SUBDIVISION	NAME	TRACT	STREET
VOL-PG.	MCMACKIN ROAD	LOT	1A-15A-10
SUBLOT NO.	STREET	VOL-PG.	PERM. PARCEL NO.

LEGEND

SANITARY MANHOLE	---○---	EXIST. ELEV. 100.0	PROP. ELEV. 100.0
STORM MANHOLE	---●---	AS BUILT ELEVATION	INDICATES DIRECTION OF SURFACE DRAINAGE
INLET OR CATCH BASIN	---□---		
HYDRANT	---○---		
EXISTING CONTOURS	---○---		
PROPOSED CONTOURS	---○---		

REMARKS  
ALL BOUNDARY DATA SHOWN WAS OBTAINED FROM (DEEDS, RECORDED SUBDIVISION PLAT OR OTHER PUBLIC RECORDS)  
LOCATIONS AS SHOWN OF ADJACENT WELLS AND SEPTIC TANKS OBTAINED FROM LAKE COUNTY HEALTH DEPARTMENT

DESIGN CERTIFICATION  
THIS PLAN WAS PREPARED BY ME, AND IS CORRECT TO THE BEST OF MY KNOWLEDGE AND BELIEF  
*[Signature]* #6343  
NAME SURVEYOR REGISTRATION NO.

CHECK LIST

NO. OF BEDROOMS	WATER MAIN SIZE, LOCATION
DIMENSIONS	SAN. SEWER SIZE & GR. LOC.
BEARINGS	SAN. MH. CAST. ELEV. INV. ELEV.
TIE TO NEAREST STREET	SAN. CONN. SIZE, LOC. DEPTH
SUBLOT NO. PARCEL NO.	STORM SEWER SIZE & GR. LOC.
SURROUNDING OWNERS	STORM MH. CAST ELEV. INV. ELEV.
BLDG. DIMENSIONS FIN GR.	PAY'T TYPE GRADE CURBS
BLDG. TIES FL'R. GRADES	GAS LINE LOC. SIZE PRESSURE
APRON TYPE WIDTH THICKNESS	SEPTIC TANK LOCATION & DUPLICATION AREA
SIDEWALK TYPE WIDTH THICKNESS	WELL LOCATION
CULVERT TYPE DIA., LENGTH	ISOLATION RADIUS FROM WELL
ROCK OUTCROPPINGS	

REVISIONS

NO.	DATE	BY
1	10/2/02	HJ
2		
3		
4		
5		

PLAN PREPARED BY:  
**BABCOCK · JONES & ASSOCIATES, INC.**  
PAINESVILLE, OHIO

DRAWN BY	NS	SCALE	1" = 30'	PHONE NO.	440-387-1811
CHK'D.	HJ	DATE	09/11/02	DRAWING NO.	02-206
CHK'D.	WB	APP'D	HJ		

"AS BUILT" CERTIFICATION  
I, HEREBY CERTIFY THAT THE CIRCLED GRADES ARE EXISTING FINISH GRADES CHECKED IN THE FIELD ON 10/11/02, 20 AND ARE CORRECT TO THE BEST OF MY KNOWLEDGE AND BELIEF.

REGISTERED SURVEYOR REG. NO.

APPROVED  
MADISON TOWNSHIP ZONING  
DATE 10/11/02  
BY JR 21136

*[Signature]* #6343  
Name Reg. No.

EXISTING UTILITIES NOTE:  
THE SIZE AND LOCATION, BOTH HORIZONTAL AND VERTICAL OF THE UNDERGROUND UTILITIES SHOWN HEREON, HAVE BEEN OBTAINED BY A SEARCH OF AVAILABLE RECORDS. VERIFICATION BY FIELD OBSERVATION HAS BEEN CONDUCTED WHERE PRACTICAL, HOWEVER, BABCOCK, JONES AND ASSOCIATES INC. DOES NOT GUARANTEE THE COMPLETENESS NOR ACCURACY THEREOF.

