



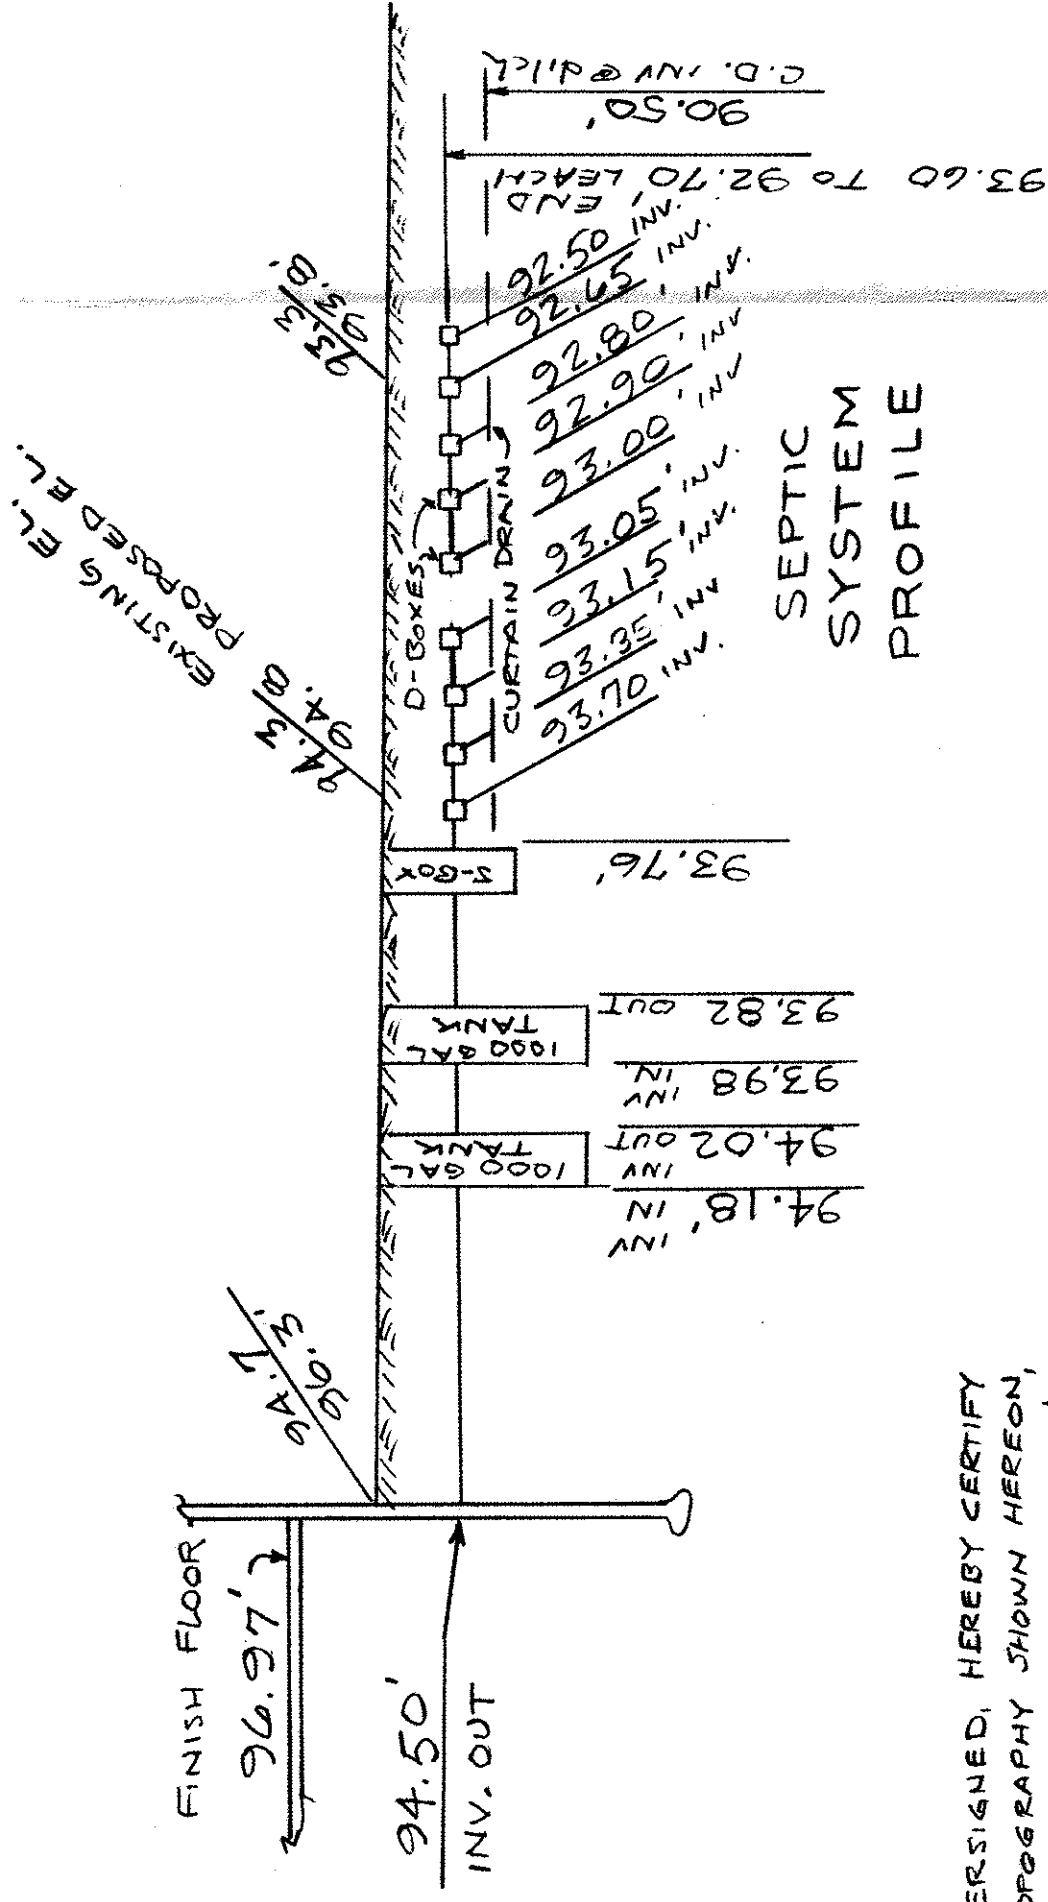

Qmpt

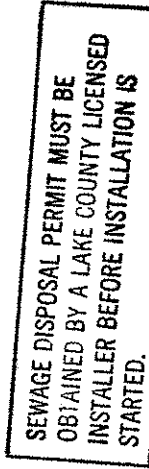

M.A. PROFETA

**LOW YIELD WATER
FIXTURES REQUIRED
ON ALL:**
Water Head

- A. To be brought to finished grade**
1. Septic tank manhole covers
 2. Splitter box cover
 3. Distribution box cover
- B. No footer drains or downspouts**
- C. All waste water to be discharged into septic tanks**

Reviewed and Accepted _____
 LAKE COUNTY GENERAL HEALTH DISTRICT
 Date 5-14-96

 JOEL LUCIA, R. S., M. P. H.
 Health Commissioner

5. Lucia Boy

APPROVED
MADISON TOWNSHIP ZONING
MAY 7 1996
PERMIT # 14034
ZONING INSPECTOR

JIM PETER LAND SURVEY
4759 CROSBY-COOK RD.
ROME, OHIO 44085
TELE: 216-294-2187

REV. 9 MAY '96 SEPTIC

SCALE 1" = 30 ft.

TELE. 216-294-2187

DWG # 960417