

North Lot of 3




SITE PLAN
For
BILL FADE

KNOWN AS BEING PART OF LOT No. 4, TRACT
No. 4 IN THE
TOWNSHIP OF MADISON
COUNTY OF LAKE STATE OF OHIO

REVIEWED AND ACCEPTED
LAKE COUNTY GENERAL
HEALTH DISTRICT

Date 7/20/98 BY Daniel Leal


SEWAGE DISPOSAL PERMIT MUST BE
OBTAINED BY A LAKE COUNTY LICENSED
INSTALLER BEFORE INSTALLATION IS
STARTED

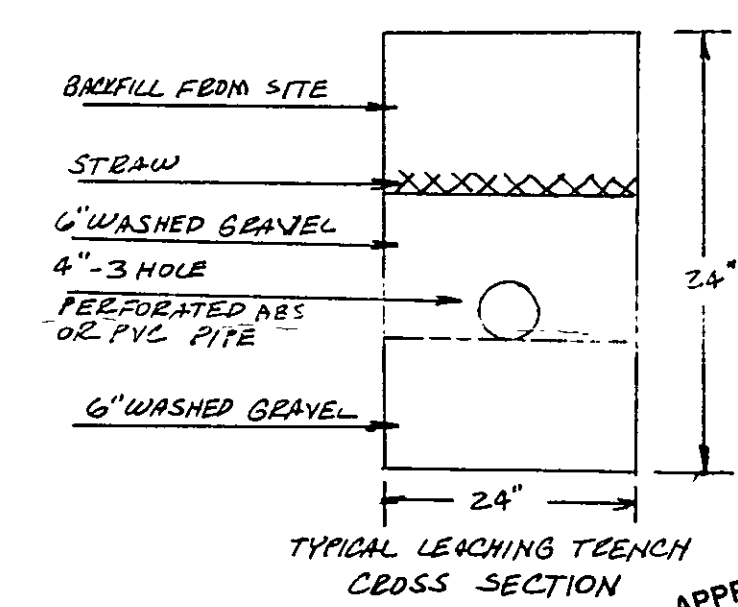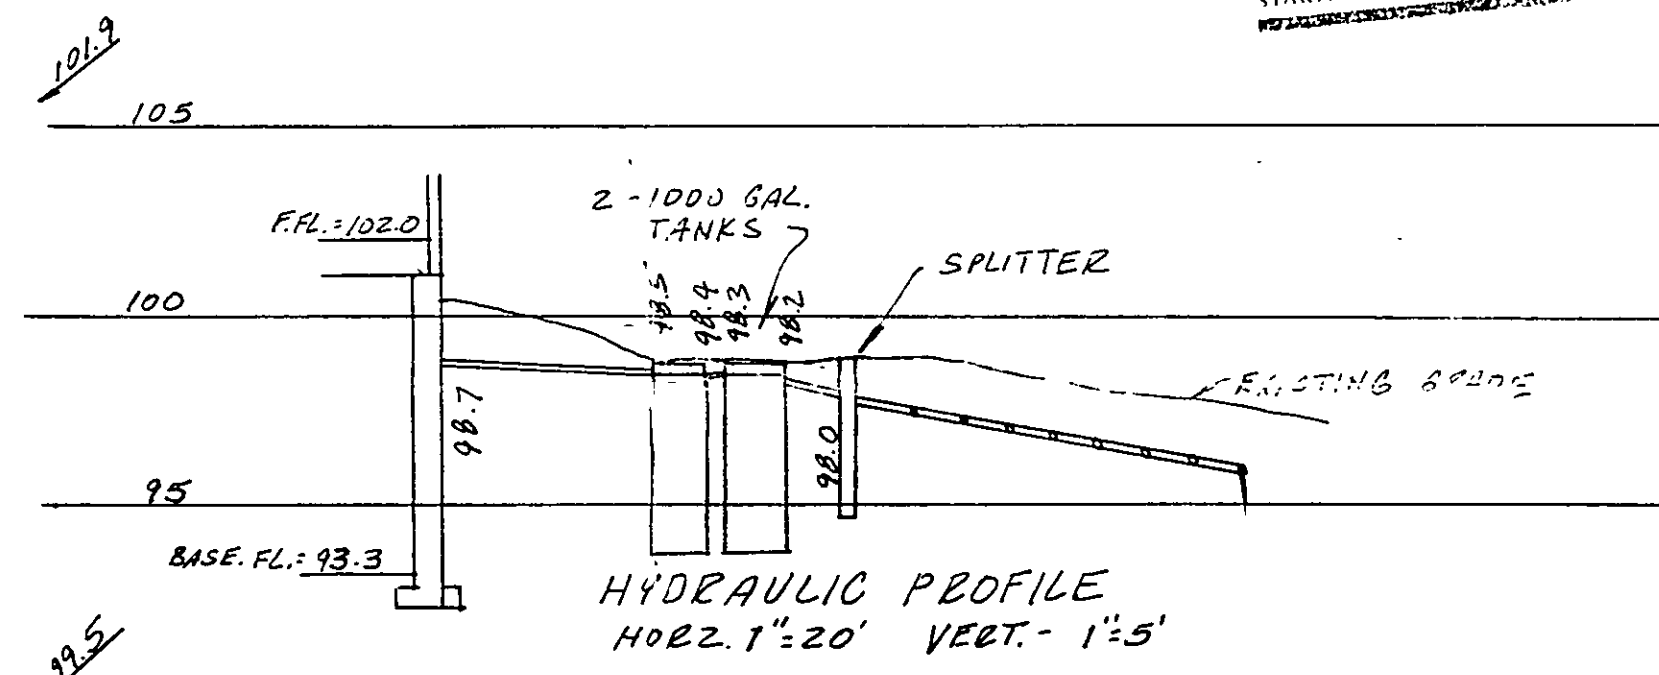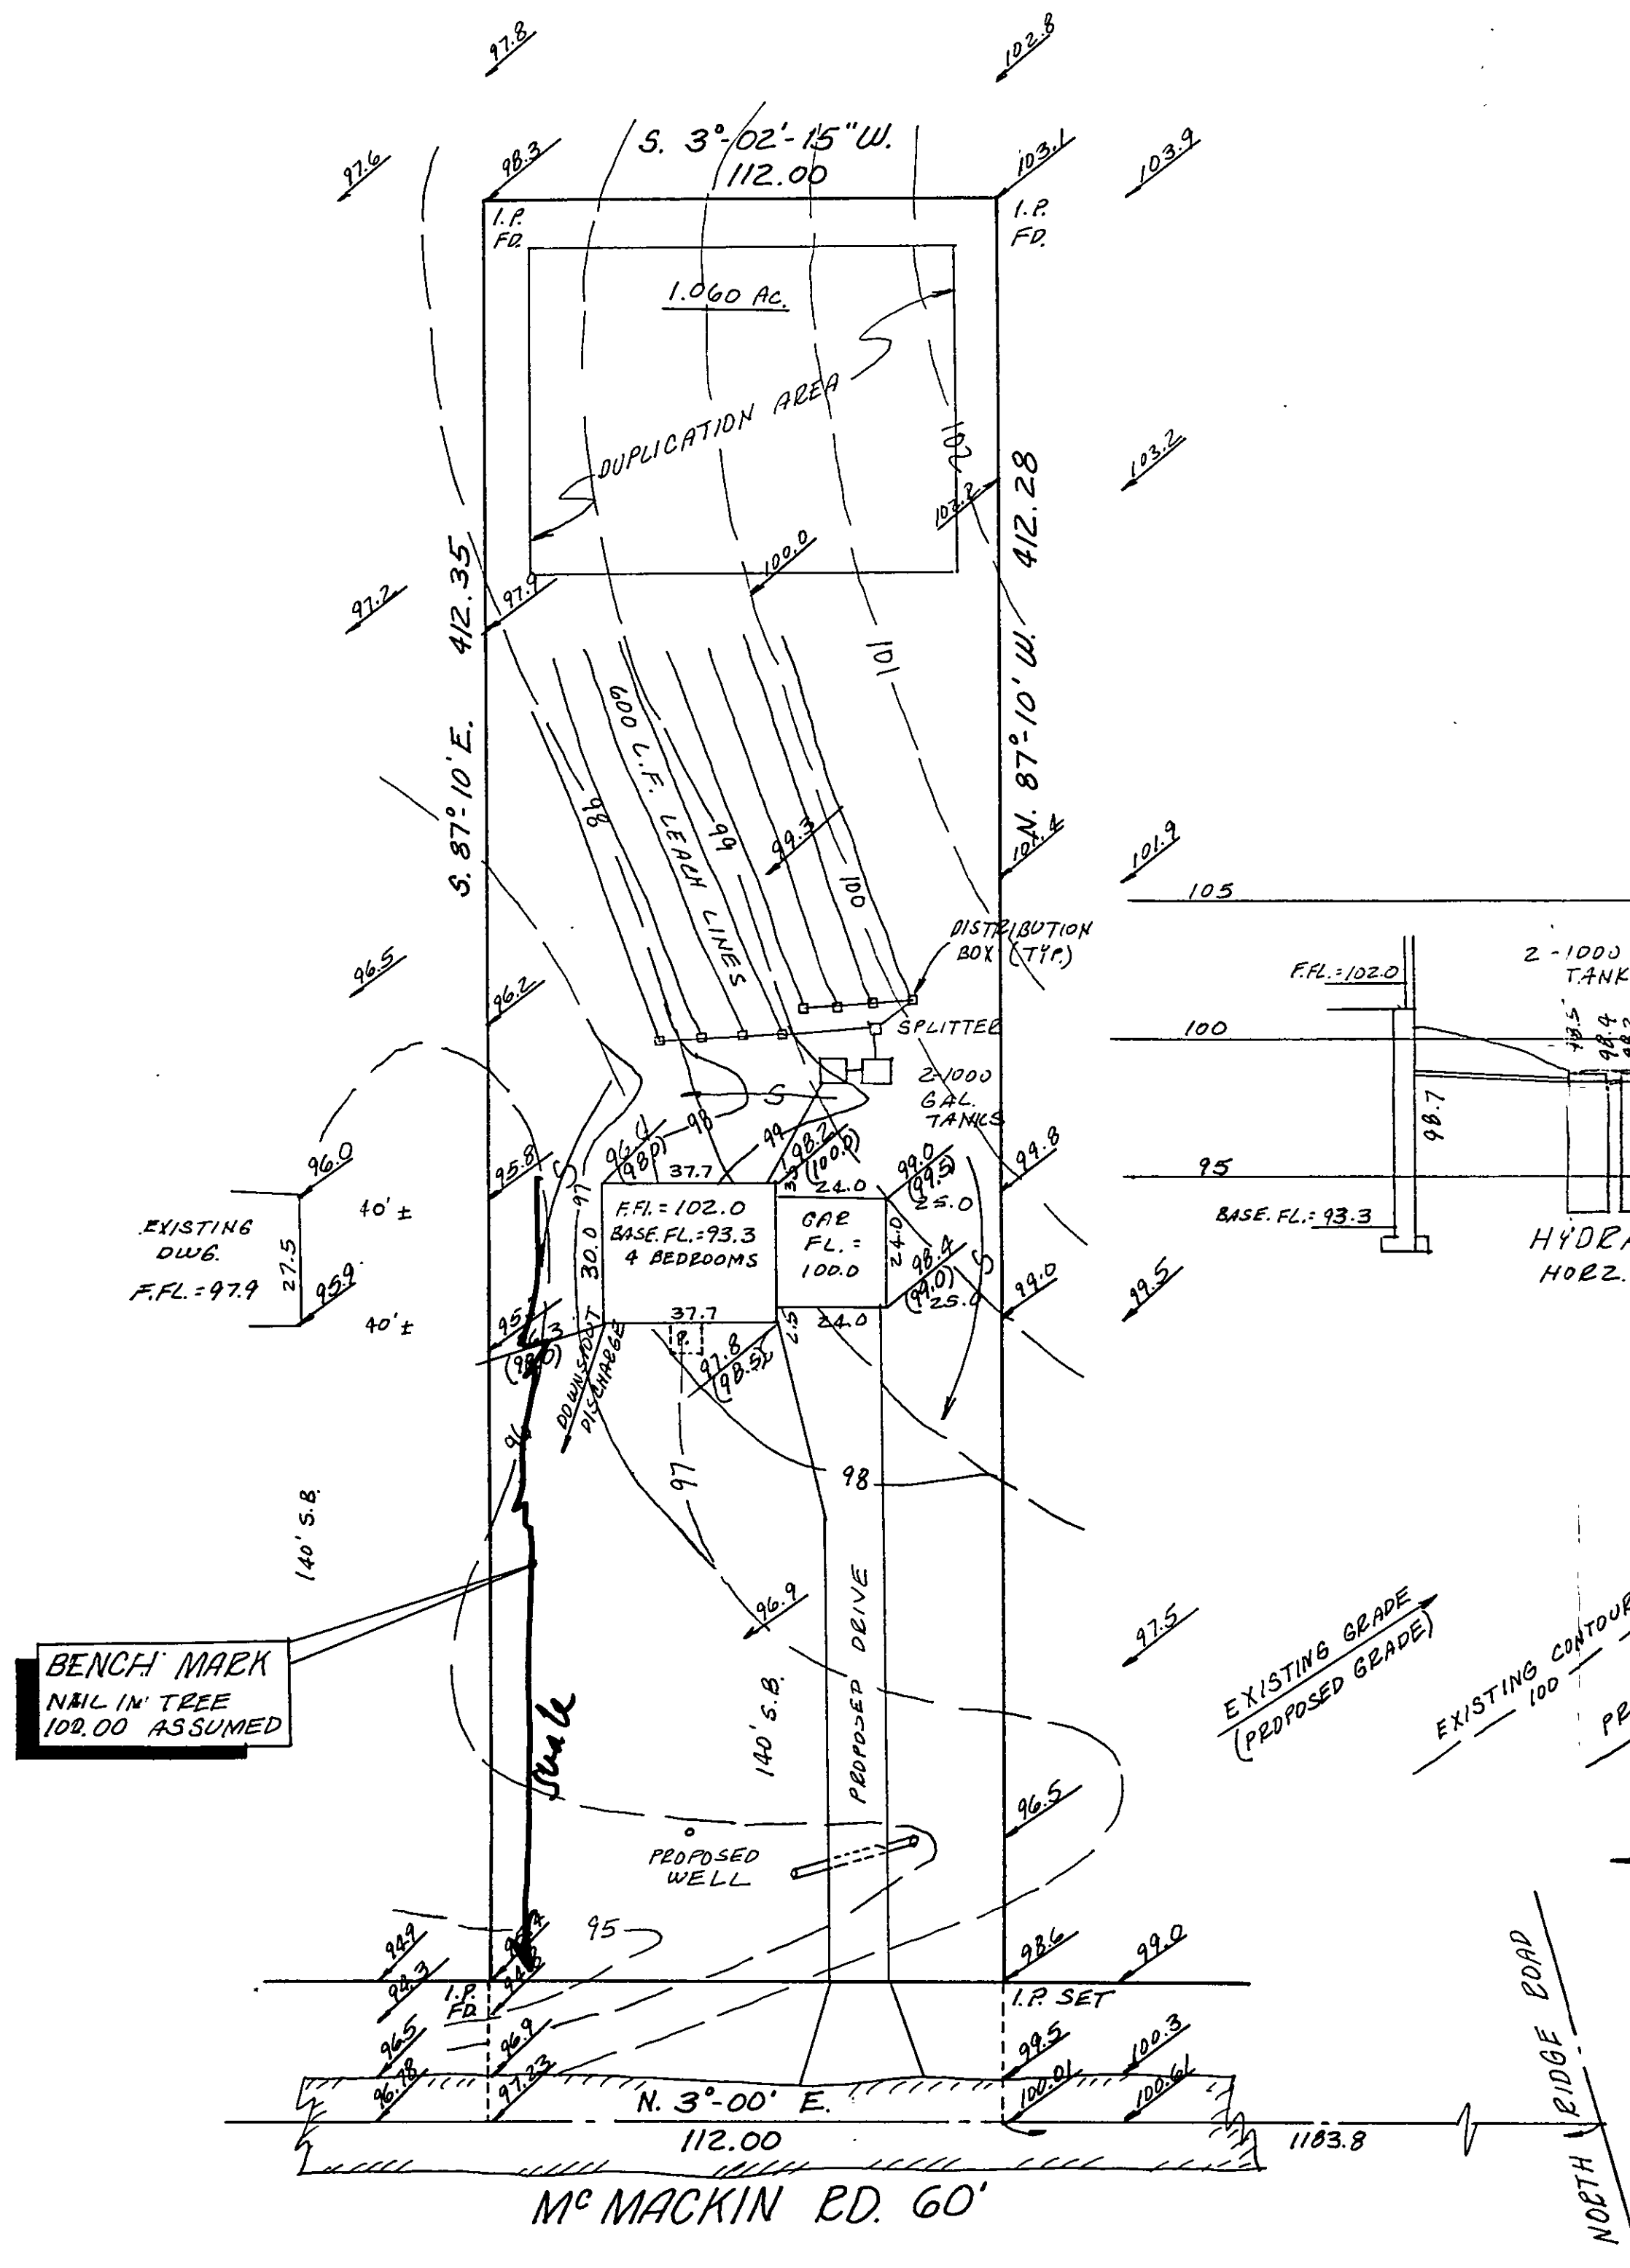

APPROVED
MADISON TOWNSHIP ZONING
DATE 7/9/98
BY DK 15863

"I, THE UNDERSIGNED HEREBY CERTIFY THAT THE TOPOGRAPHY SHOWN HEREON, INDICATED BY ONE FOOT CONTOURS AND ELEVATIONS REPRESENTS AN ACTUAL FIELD TOPOGRAPHIC SURVEY MADE BY ME ON JULY 2ND, 1998 AND THAT THE ELEVATIONS WERE TAKEN AT APPROPRIATE INTERVALS AND THAT AS OF THAT DATE THEY EXISTED AS INDICATED HEREON


BEARINGS SHOWN HEREON ARE TO AN ASSUMED MERIDIAN AND ARE USED TO DENOTE ANGLES ONLY. IRON PINS WERE FOUND OR SET AT ALL POINTS SHOWN HEREON. DISTANCES ARE GIVEN IN FEET AND DECIMAL PARTS THEREOF, ALL OF WHICH ARE CORRECT, TO THE BEST OF MY KNOWLEDGE AND BELIEF.

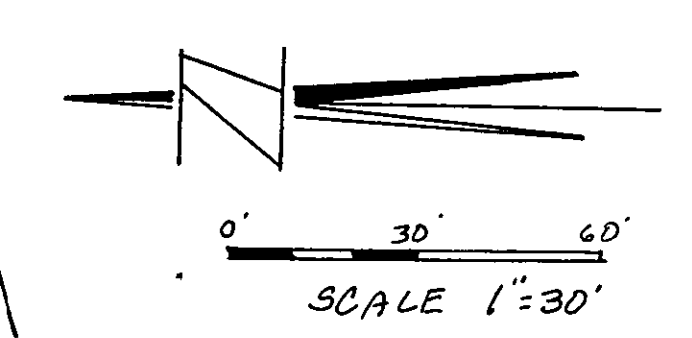

Grading Plan Approved
for shown and/or
THOMAS P. GILLES, P.E.
Lake County Engineer

By GH Date 7.22.98
Suale as shown

James A. Ziemia
JAMES A. ZIEMBA P.S. # 7094

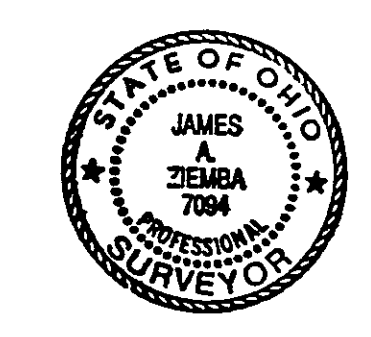

BENCHMARK SURVEY CO.
5964 S. RIDGE RD. 7-2-98
MADISON, OHIO 44057